


THIS MAP WAS PREPARED FOR ASSESSMENT PURPOSE ONLY.

SEC.6 T30S. R.4W. W.M. DOUGLAS COUNTY
1" = 400'

REVISED ON 7-2-10

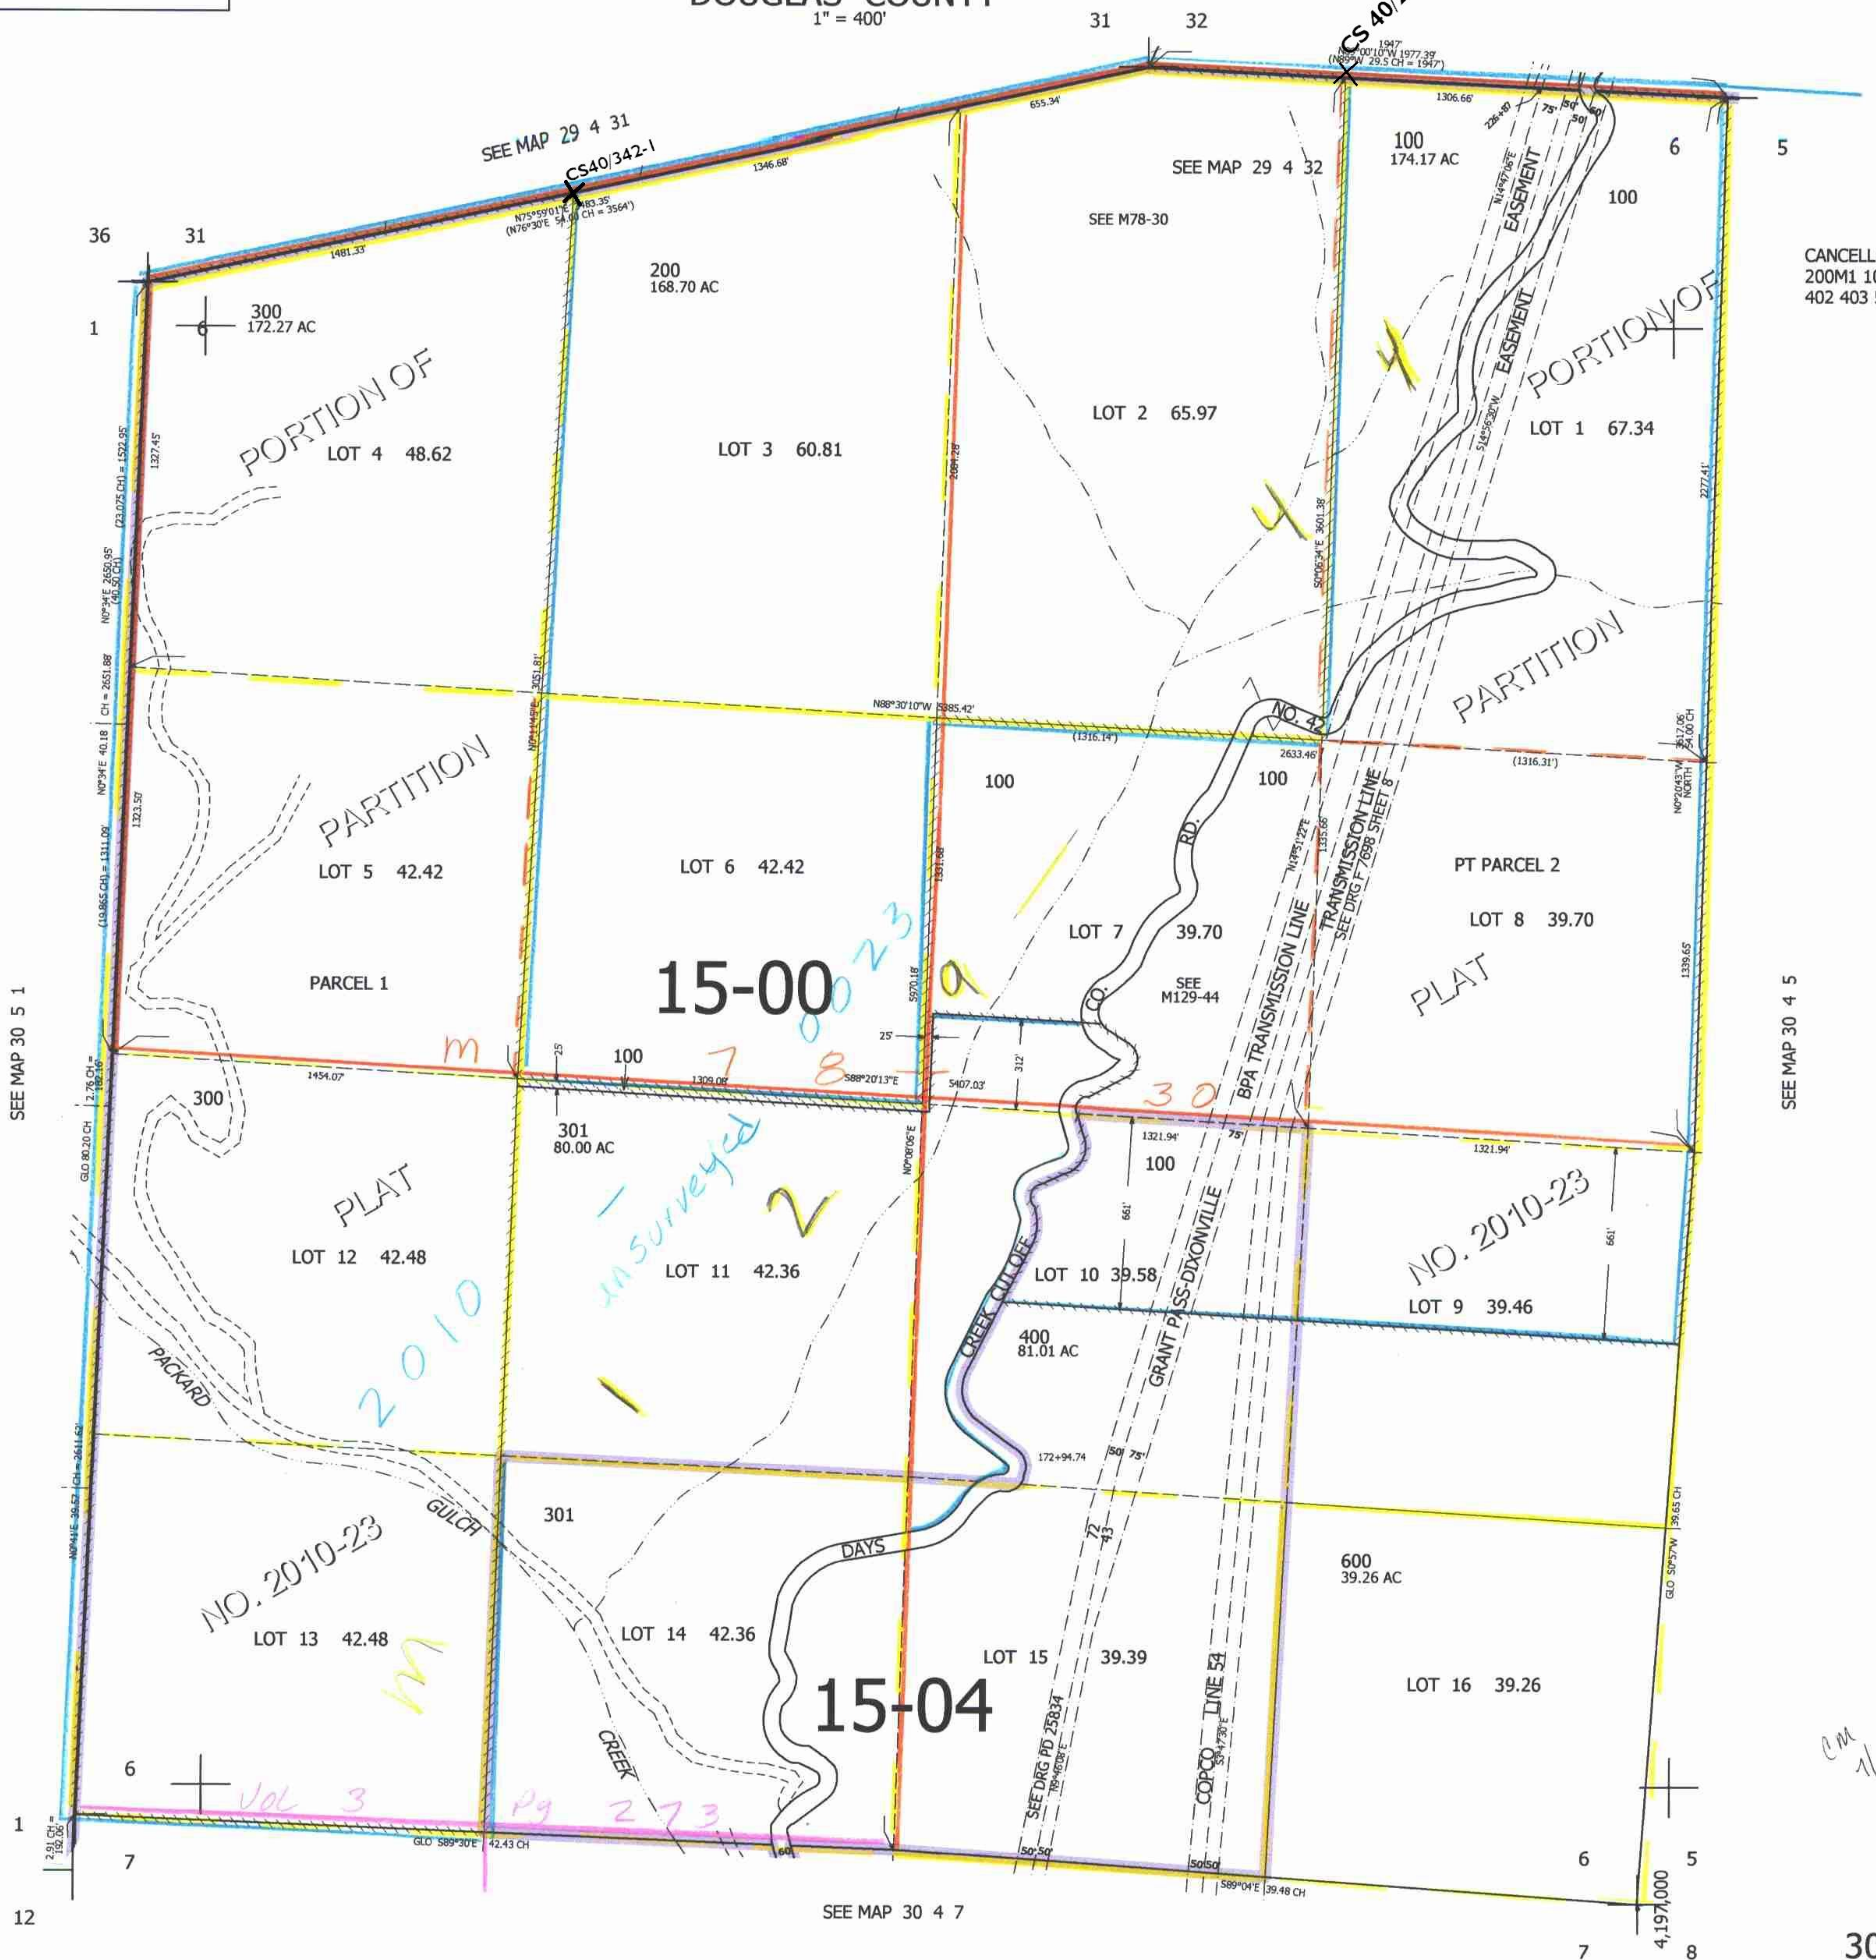

CANCELLED NO'S
200M1 101 401
402 403 500

SEE MAP 30 4 5

cm
1/14/10
JC ✓
492,000