THIS MAP WAS PREPARED FOR ASSESSMENT PURPOSE ONLY.

SE1/4 SE1/4 SEC.9 T30S. R.4W. W.M.
DOUGLAS COUNTY

1" = 100'

REVISED ON 1-28-19
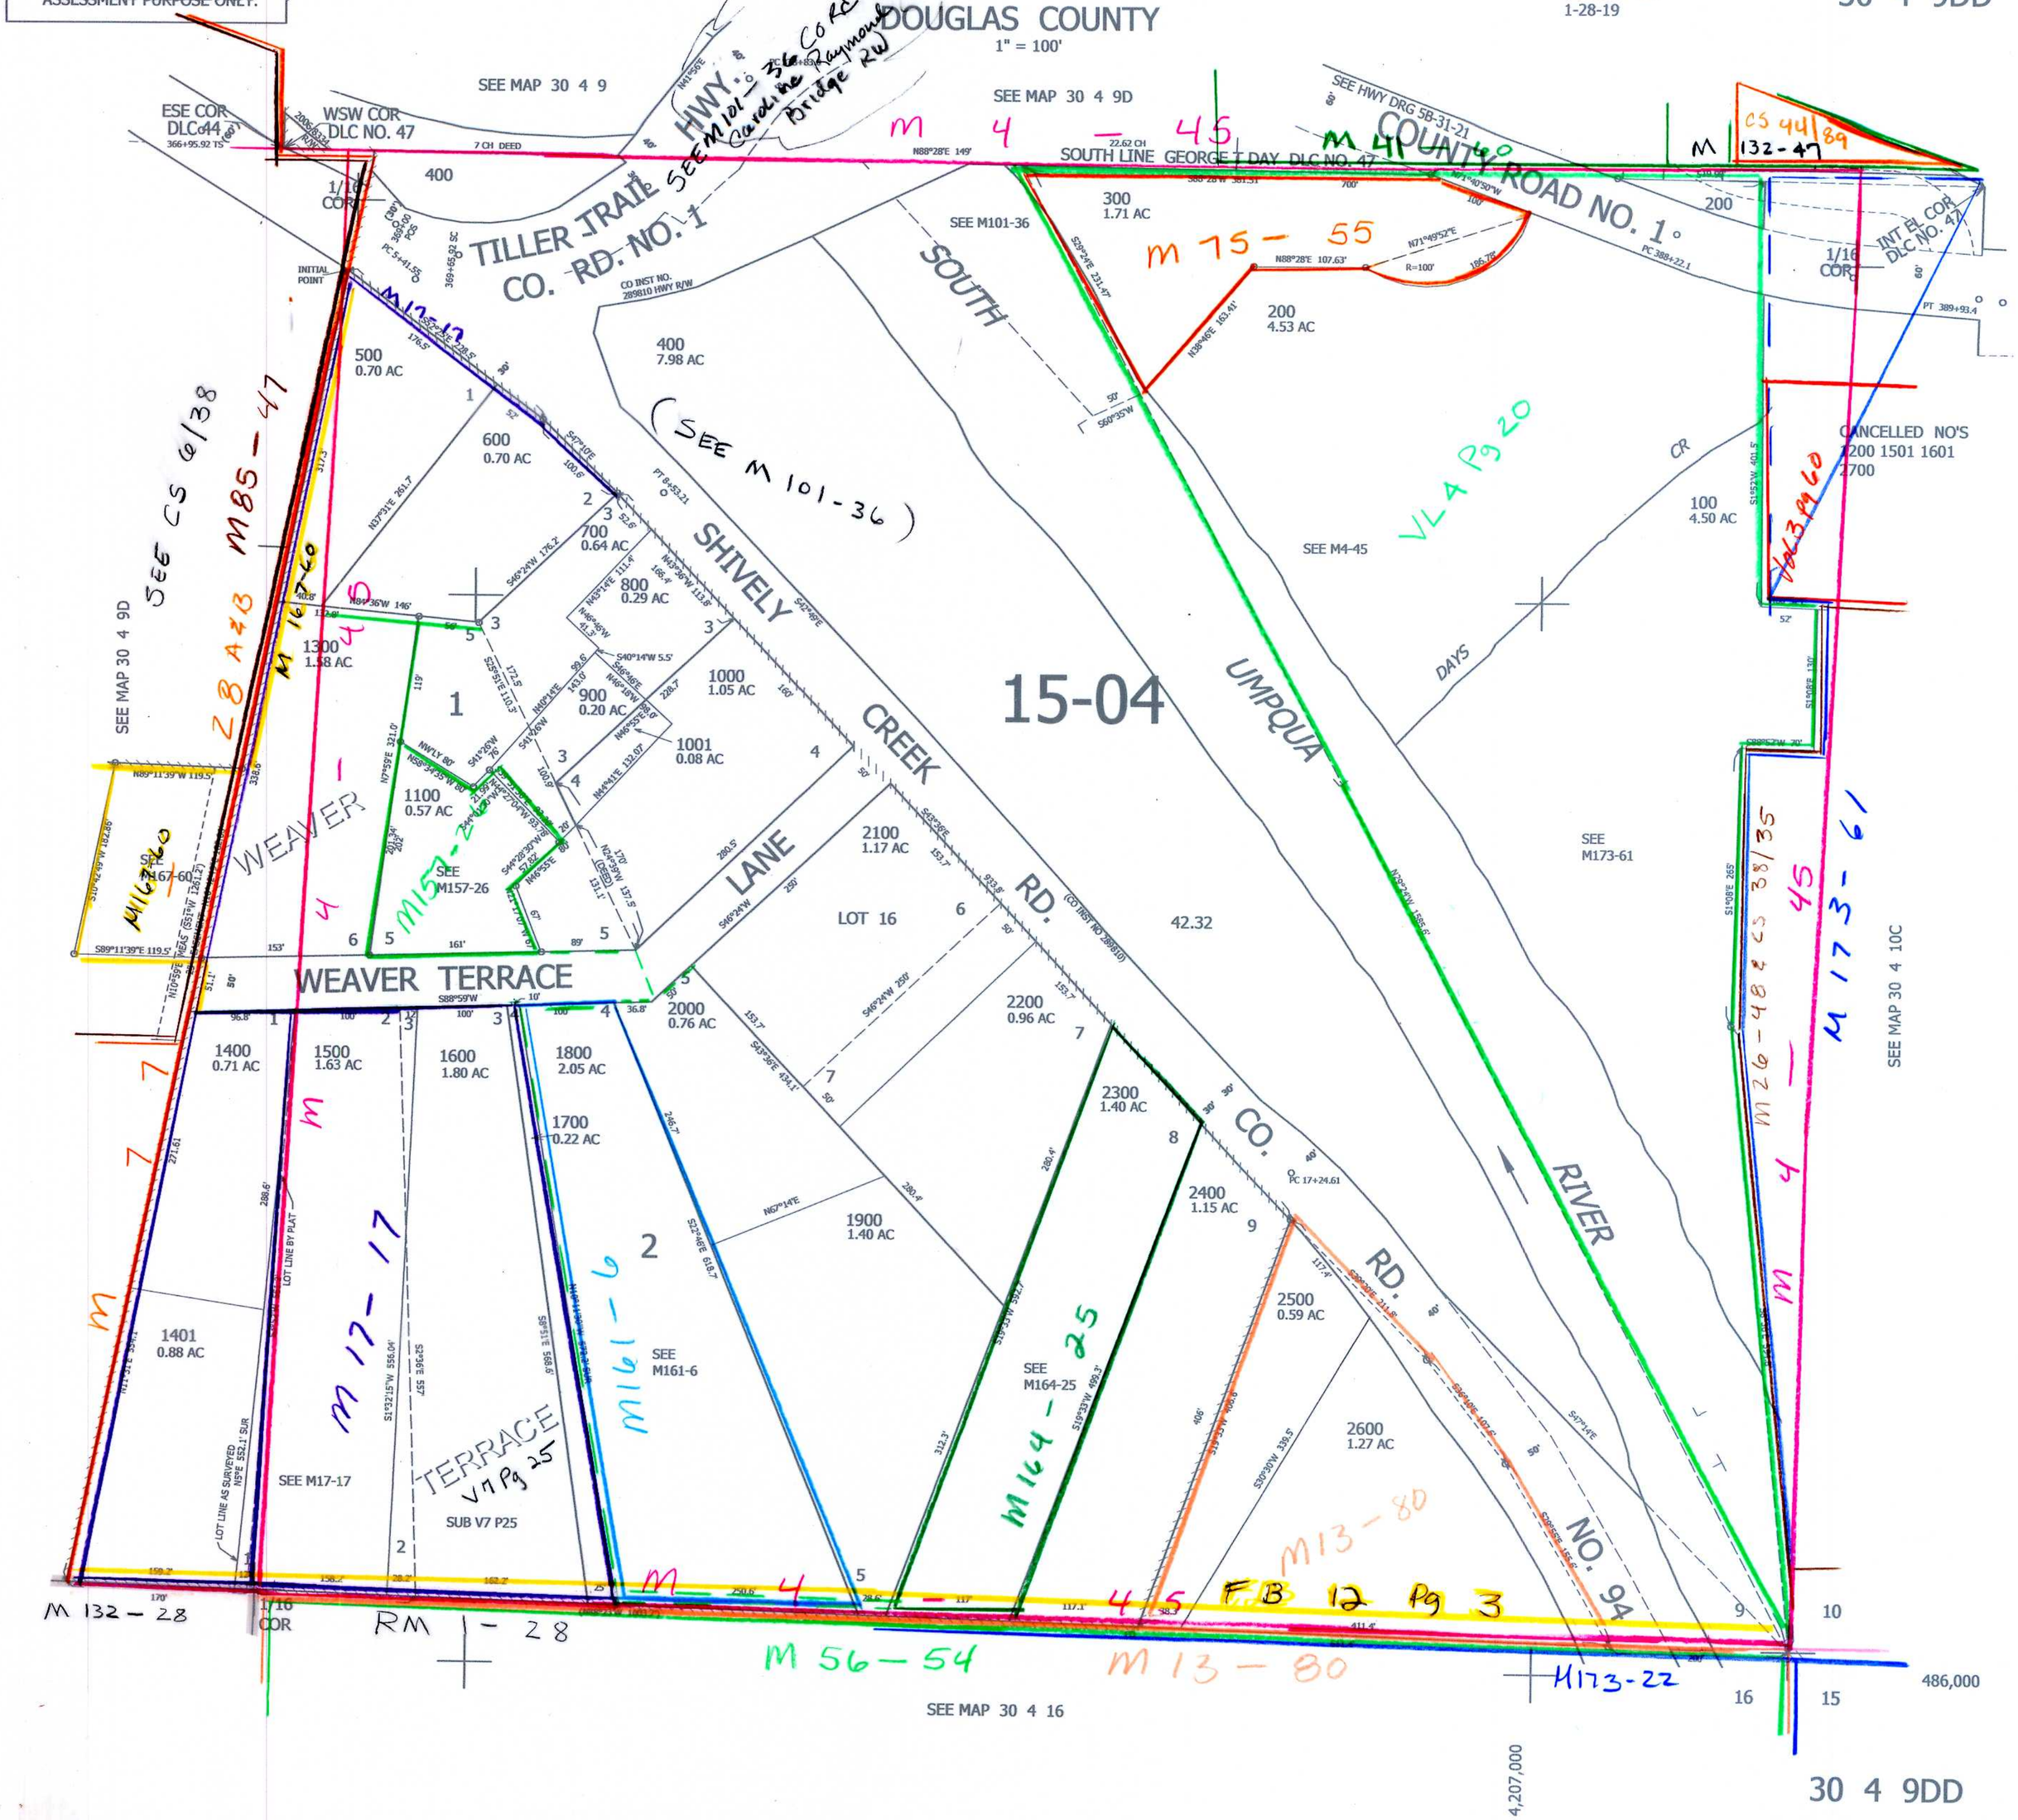
30 4 9DD