THIS MAP WAS PREPARED FOR ASSESSMENT PURPOSE ONLY.

SE1/4 SW1/4 SEC. 10 T.30S. R.4W. W.M.
DOUGLAS COUNTY

30 4 10CD
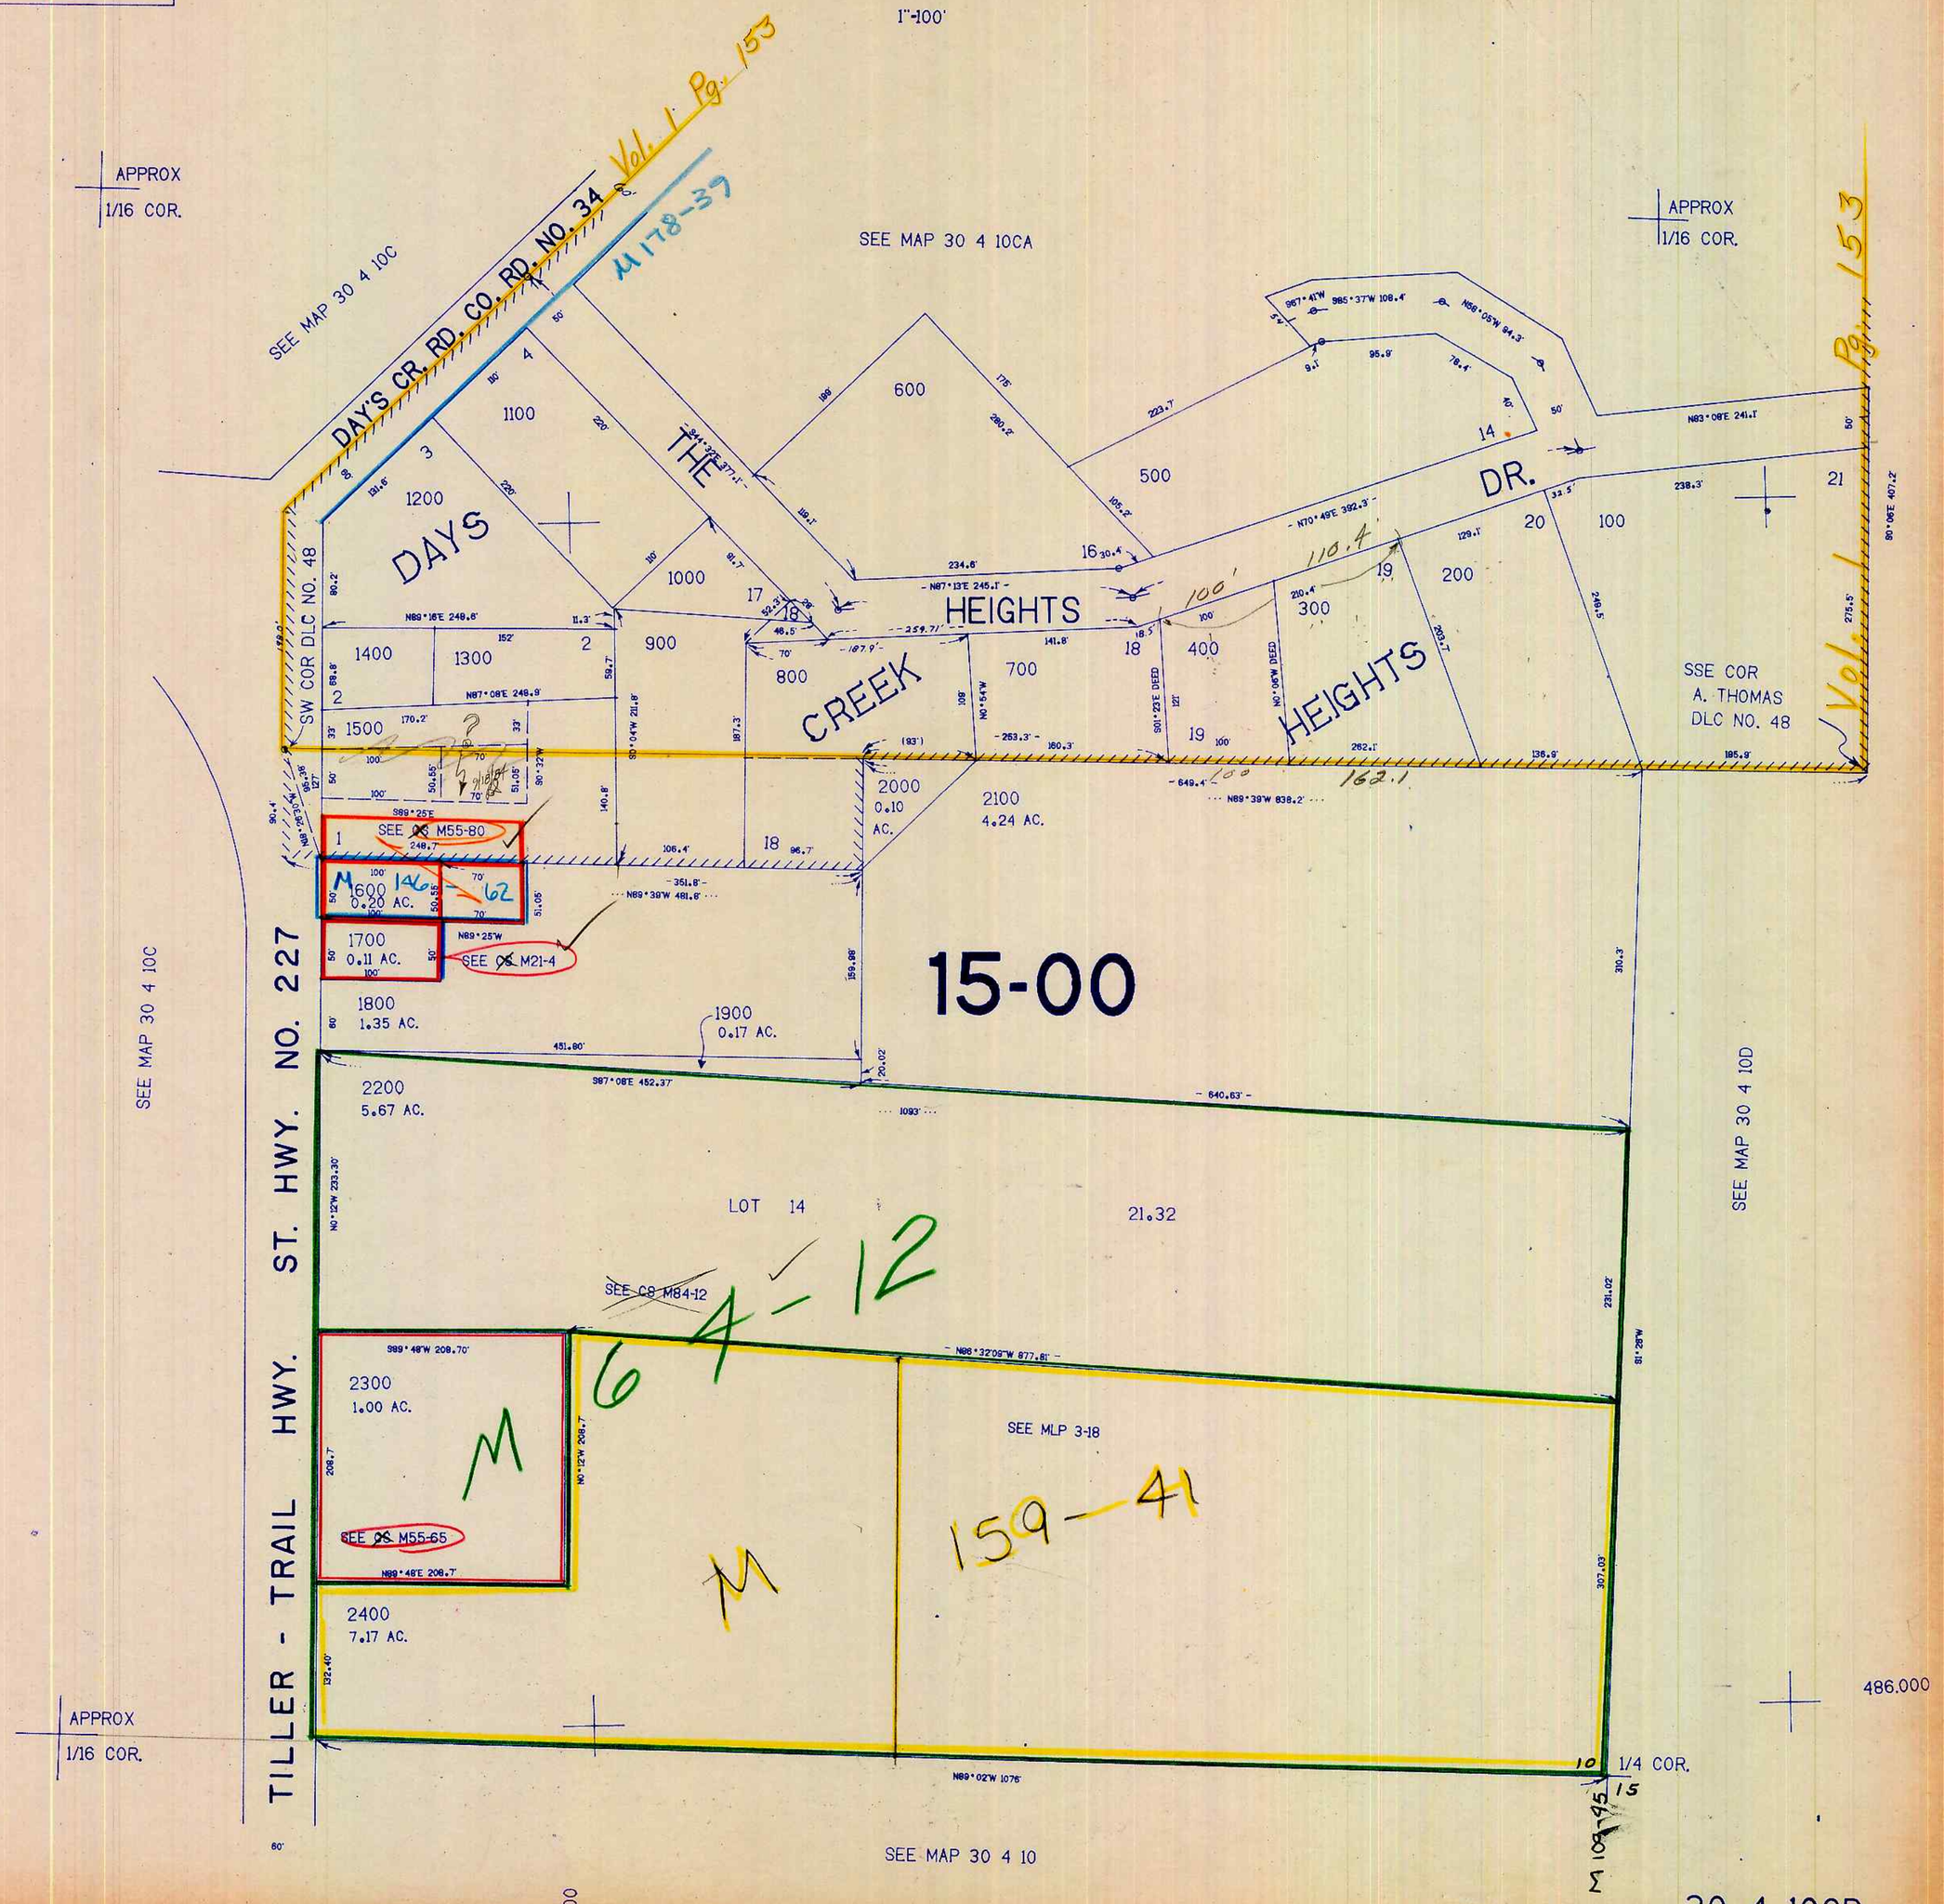
1"=100'