


SECTION 14 T.30S. R.4W. W.M.
DOUGLAS COUNTY

30 4 14

THIS MAP WAS PREPARED FOR
ASSESSMENT PURPOSE ONLY.

1"=400'

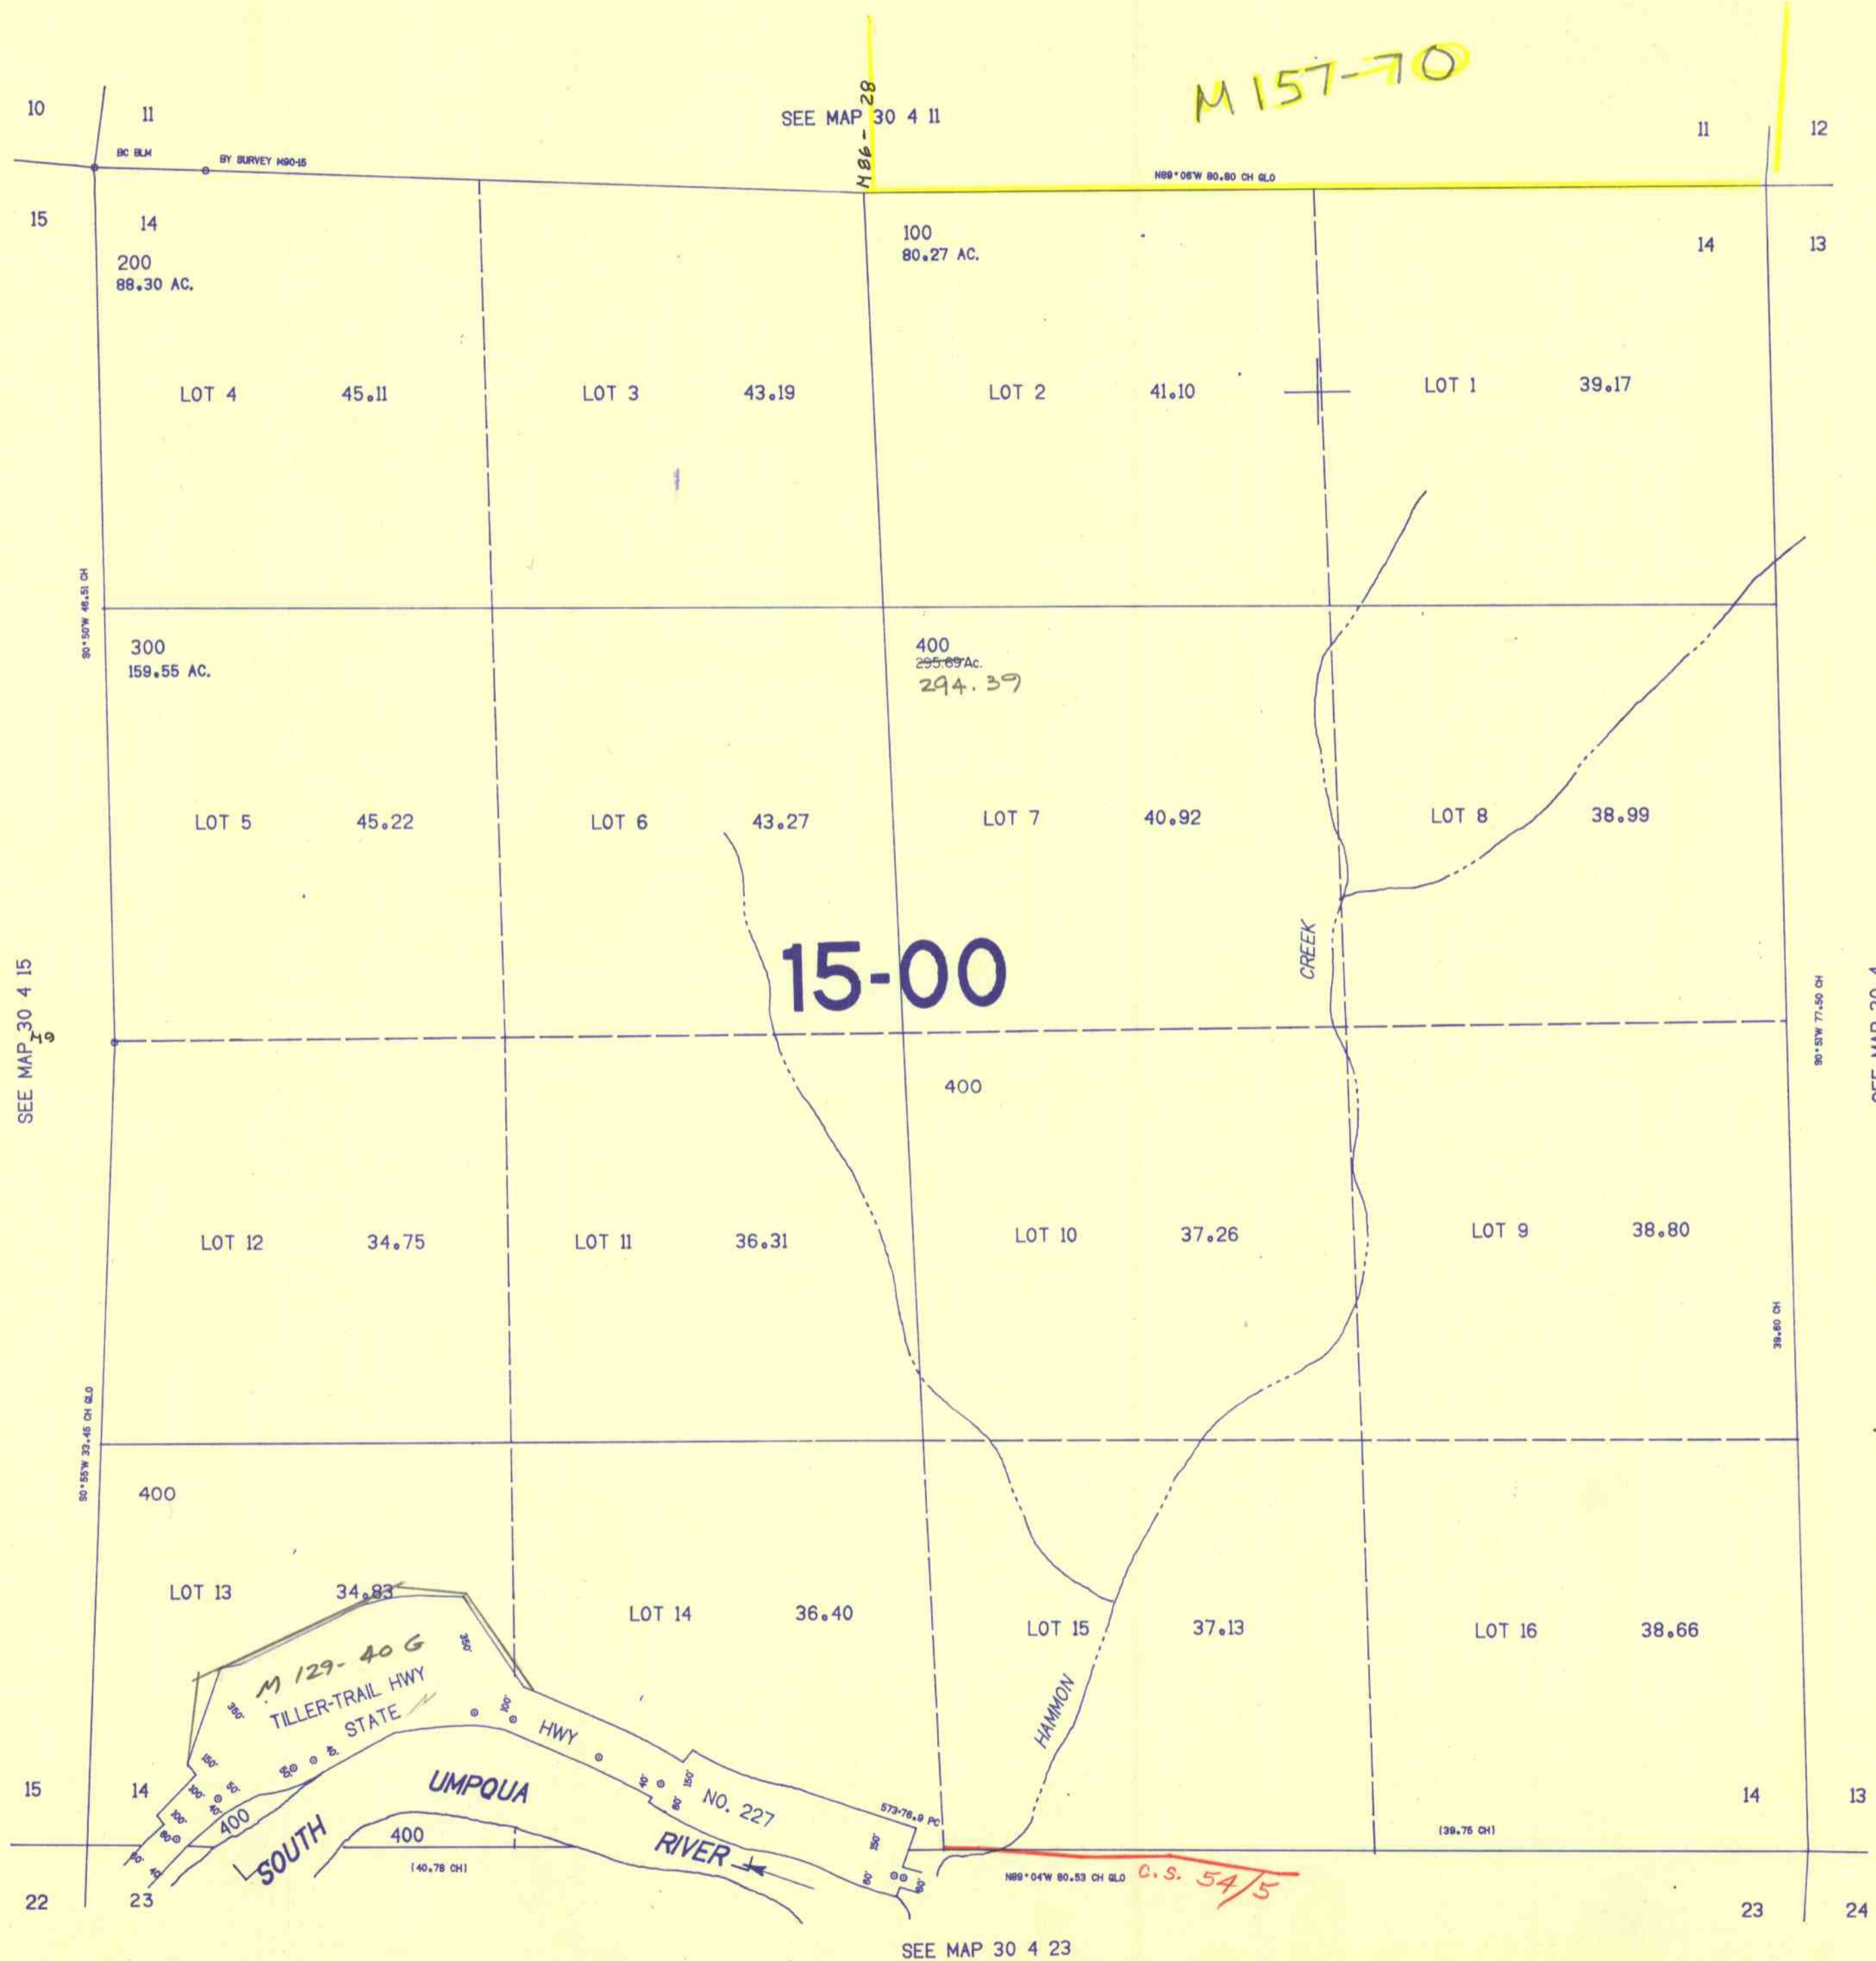

30 4 14

480.000

10/84
BS