


SECTION 20 T.30S. R.4W. W.M.
DOUGLAS COUNTY

30 4 20

THIS MAP WAS PREPARED FOR
ASSESSMENT PURPOSE ONLY.

1"=400'

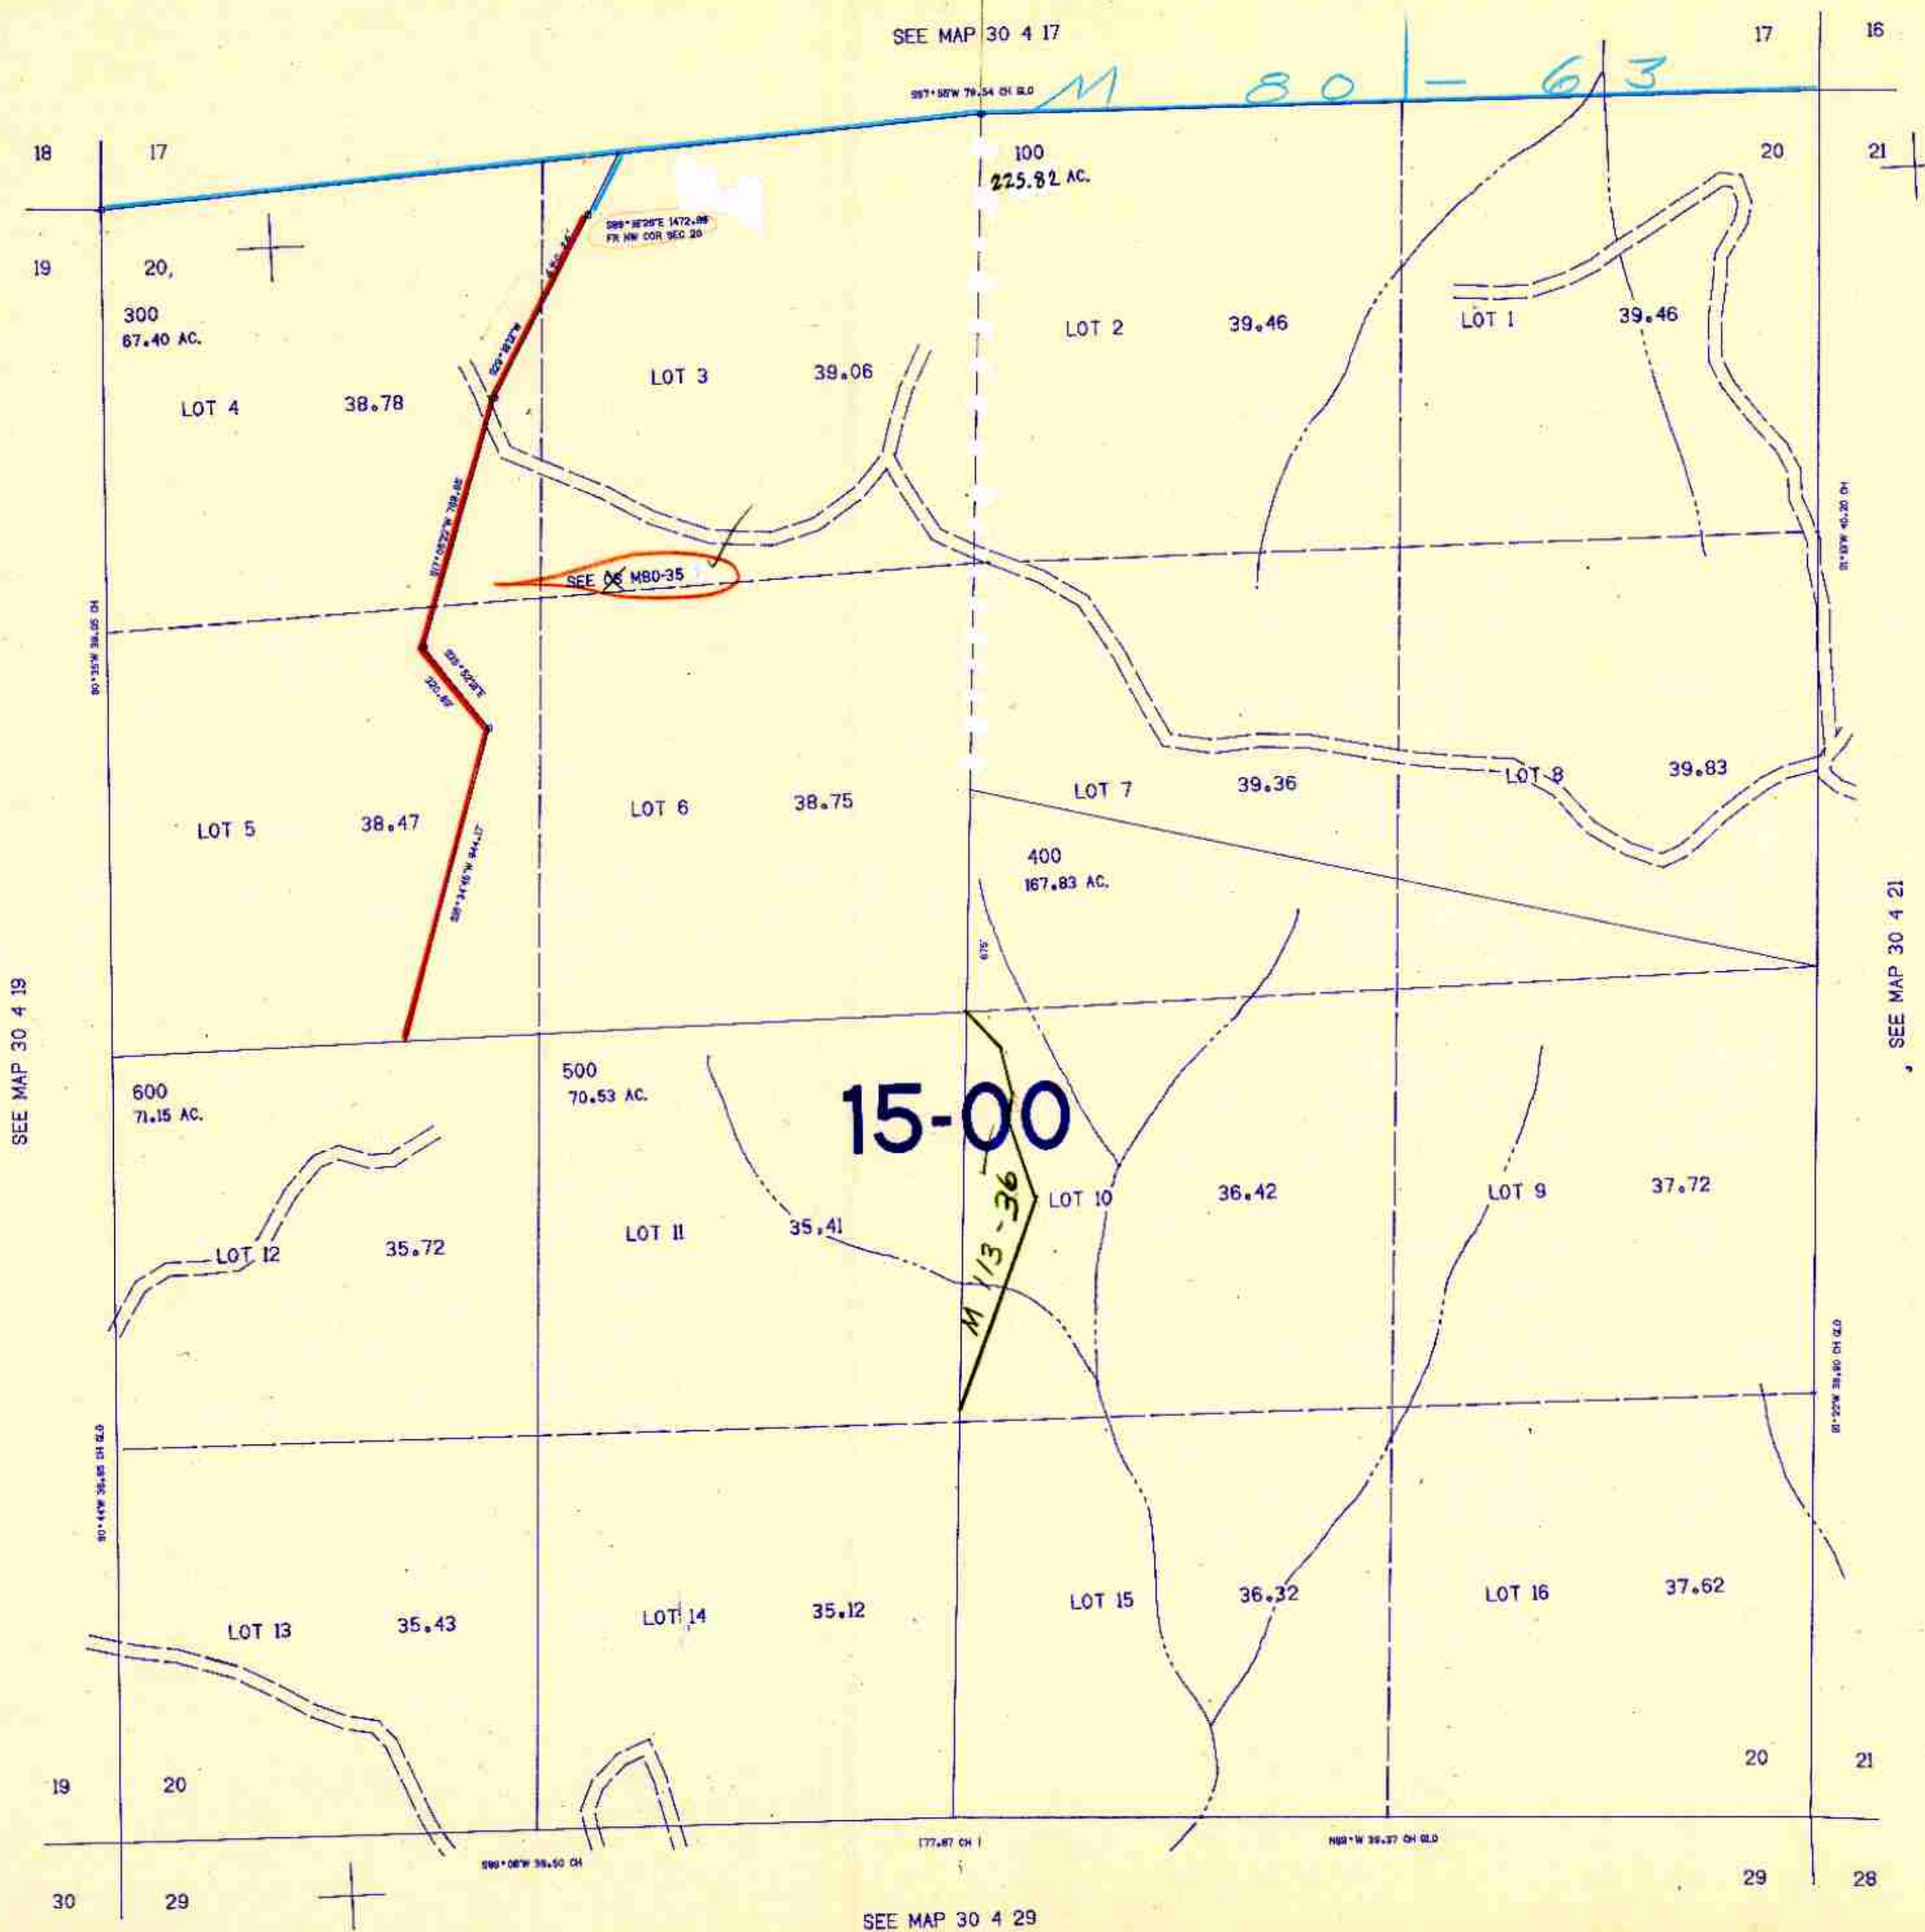

CANCELLED NO'S
200

15-00

M 113-36

SEE MAP 30 4 19

SEE MAP 30 4 17

SEE MAP 30 4 21

SEE MAP 30 4 29

476.000

30 4 20
1281.000
1984 BS