


SECTION 25 T.30S. R.4W. W.M.  
DOUGLAS COUNTY

REVISED ON  
5 - 5 - 95

30 4 25

THIS MAP WAS PREPARED FOR  
ASSESSMENT PURPOSE ONLY.

1"=400'

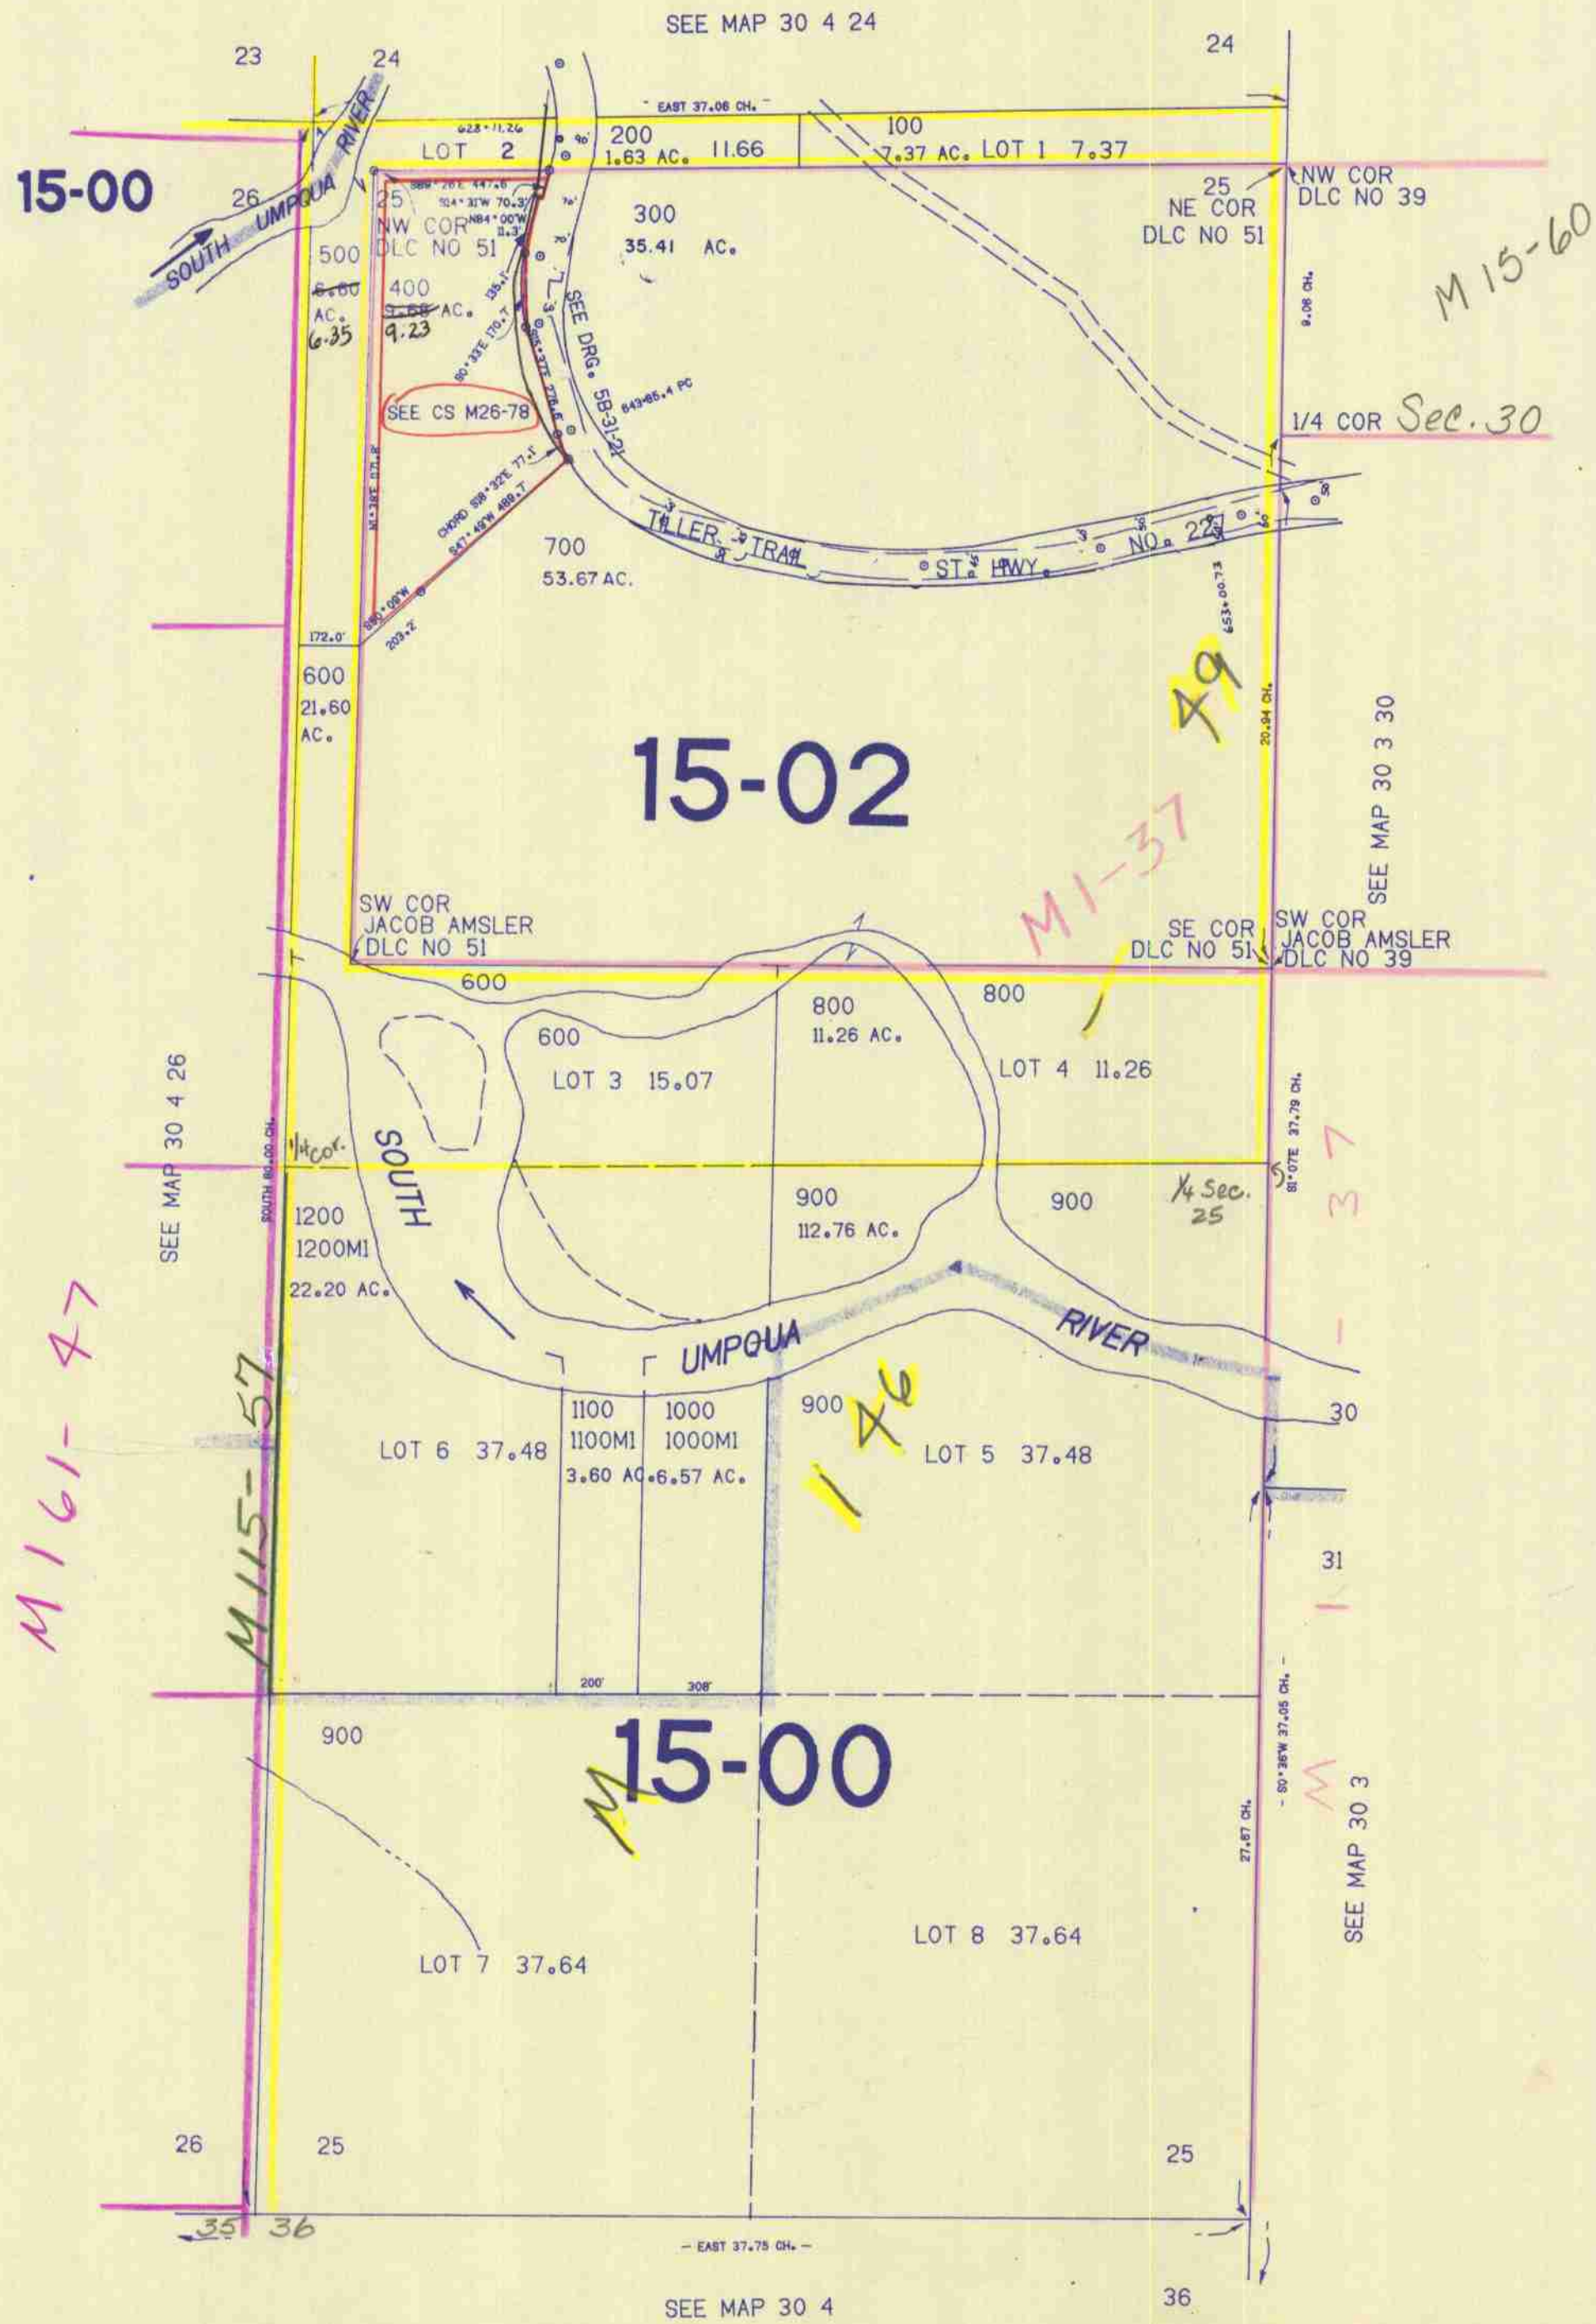

470.000

30 4 25

300.000

5/95