


SECTION 28 T.30S. R.4W. W.M.  
DOUGLAS COUNTY

30 4 28

THIS MAP WAS PREPARED FOR  
ASSESSMENT PURPOSE ONLY.

1"=400'

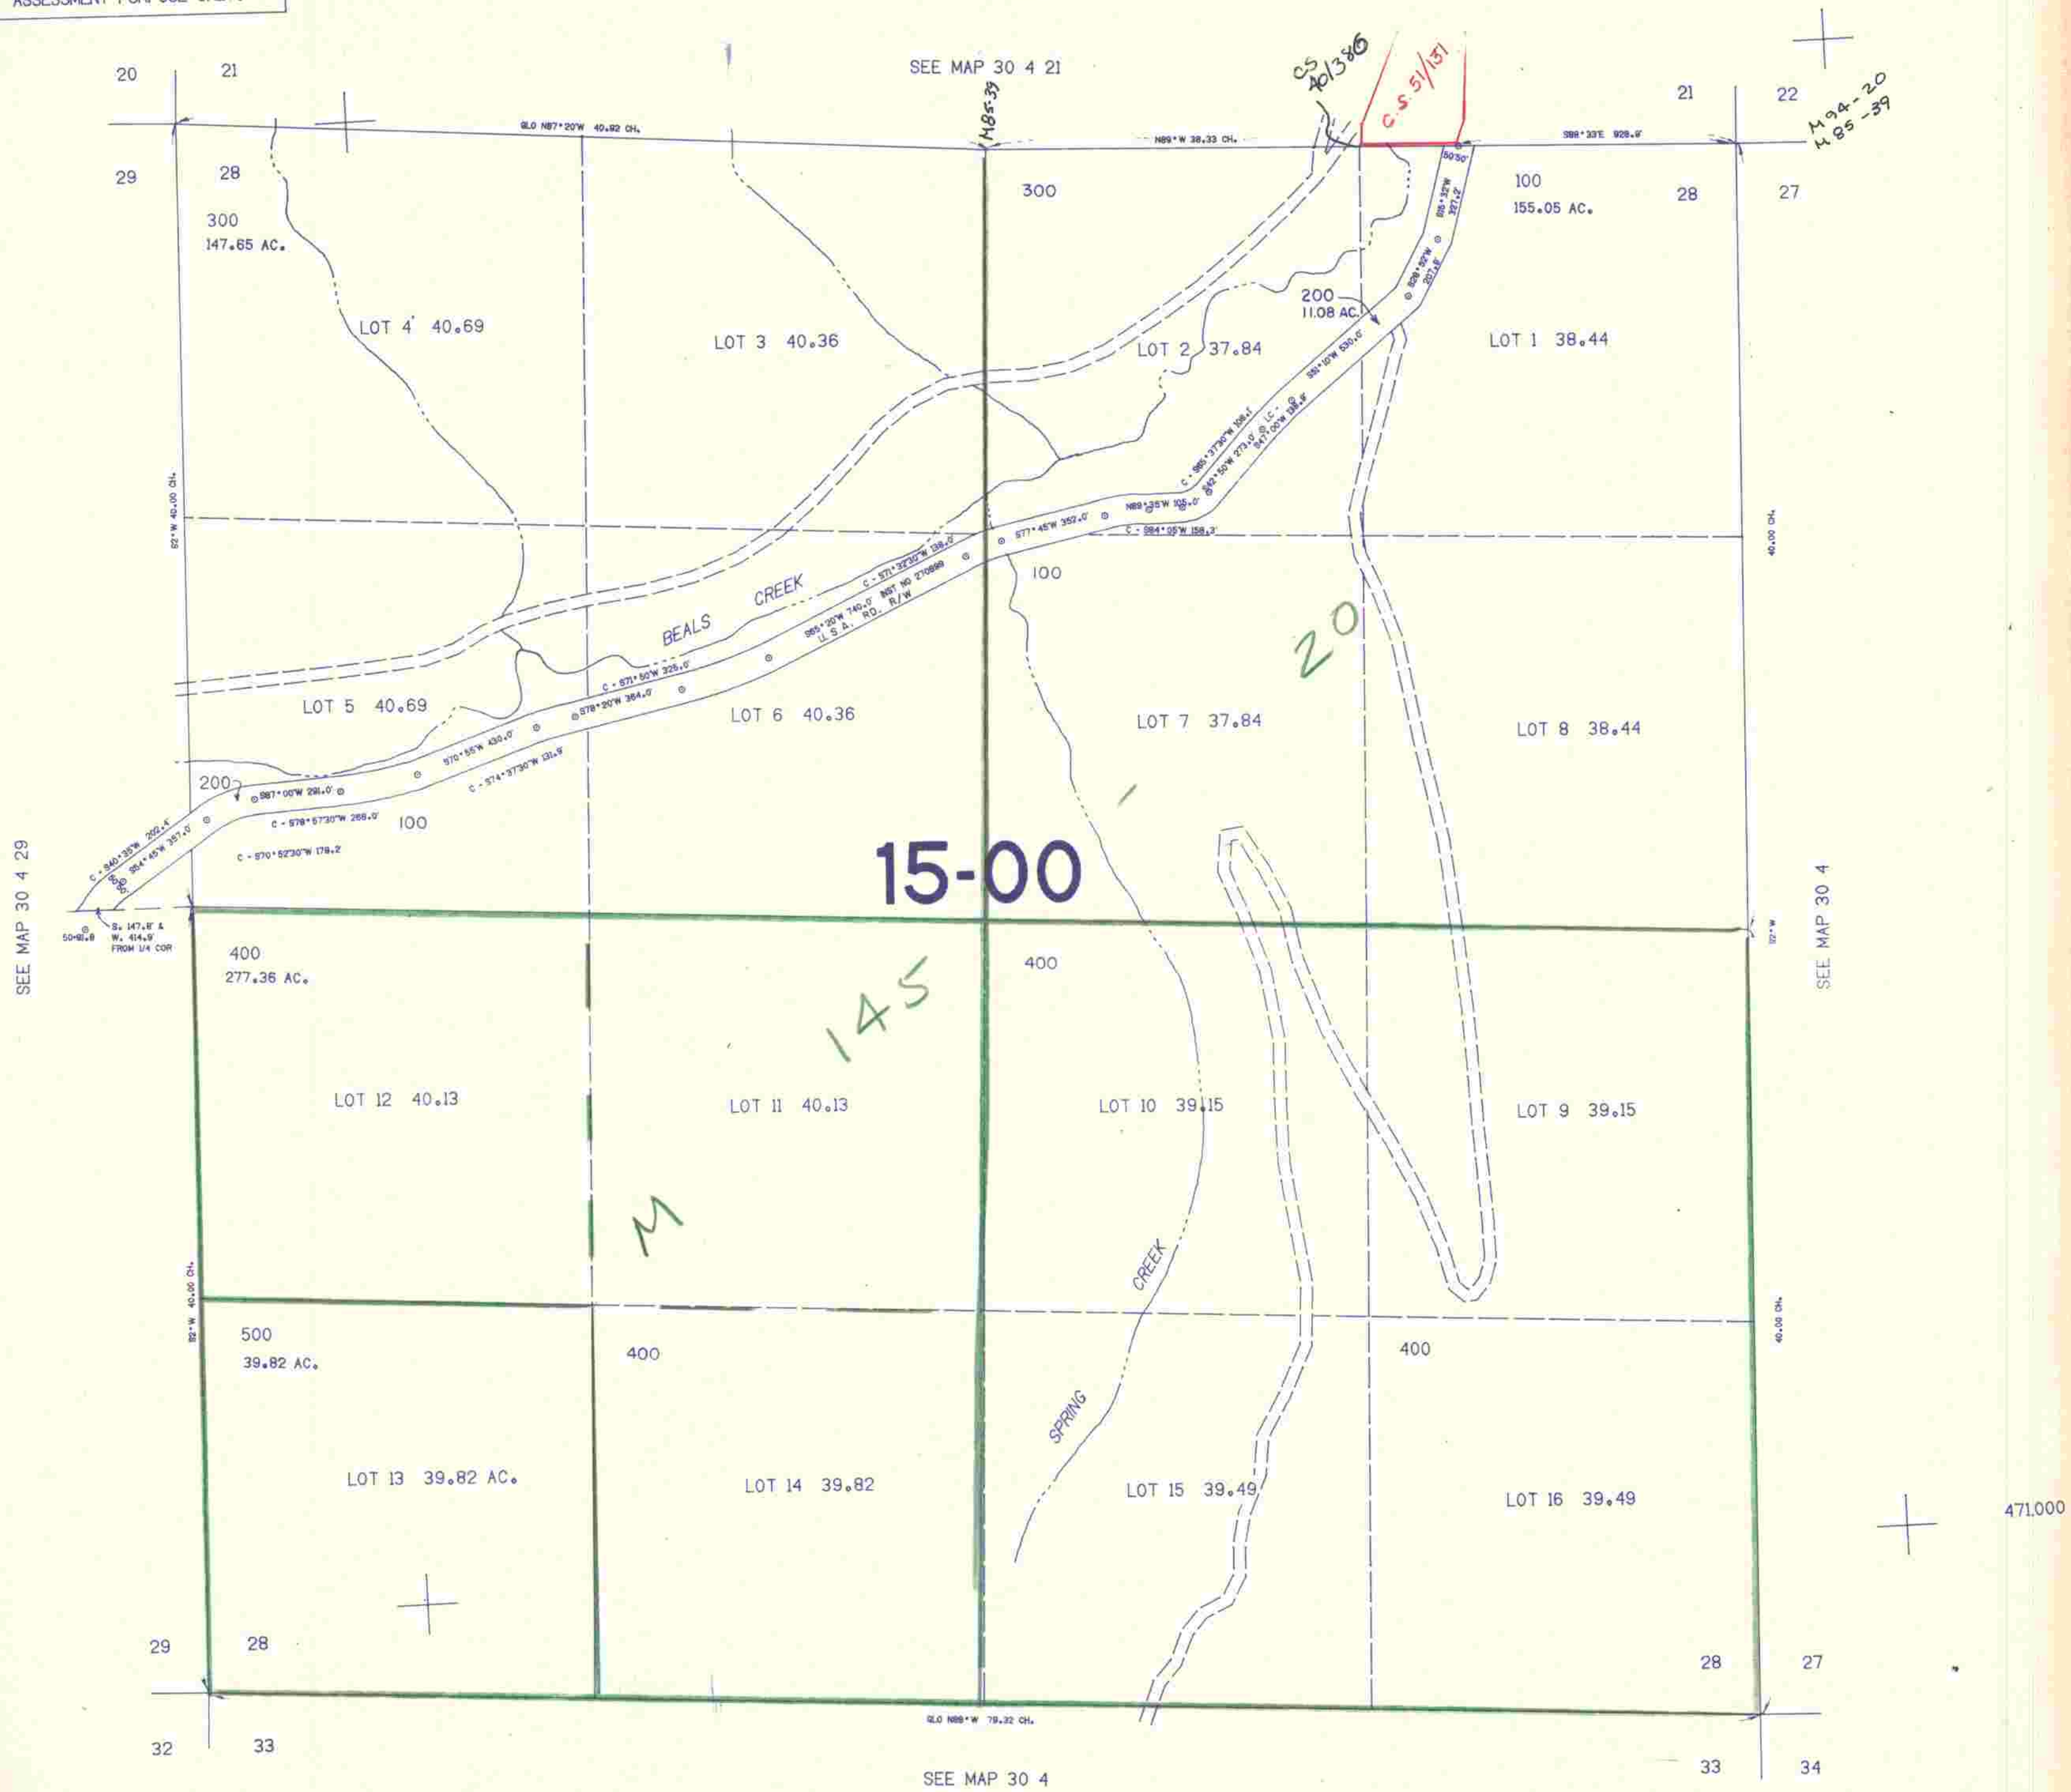

30 4 28

1286.000  
10/04  
[Signature]