SW1/4 NW1/4 SEC.1 T.27S. R.6W. W.M.
DOUGLAS COUNTY

1" = 100'

REVISED ON
3-11-10

27 6 1BC
ROSEBURG

LINES PROTRACTED HEREON
ARE APPROXIMATE ONLY.

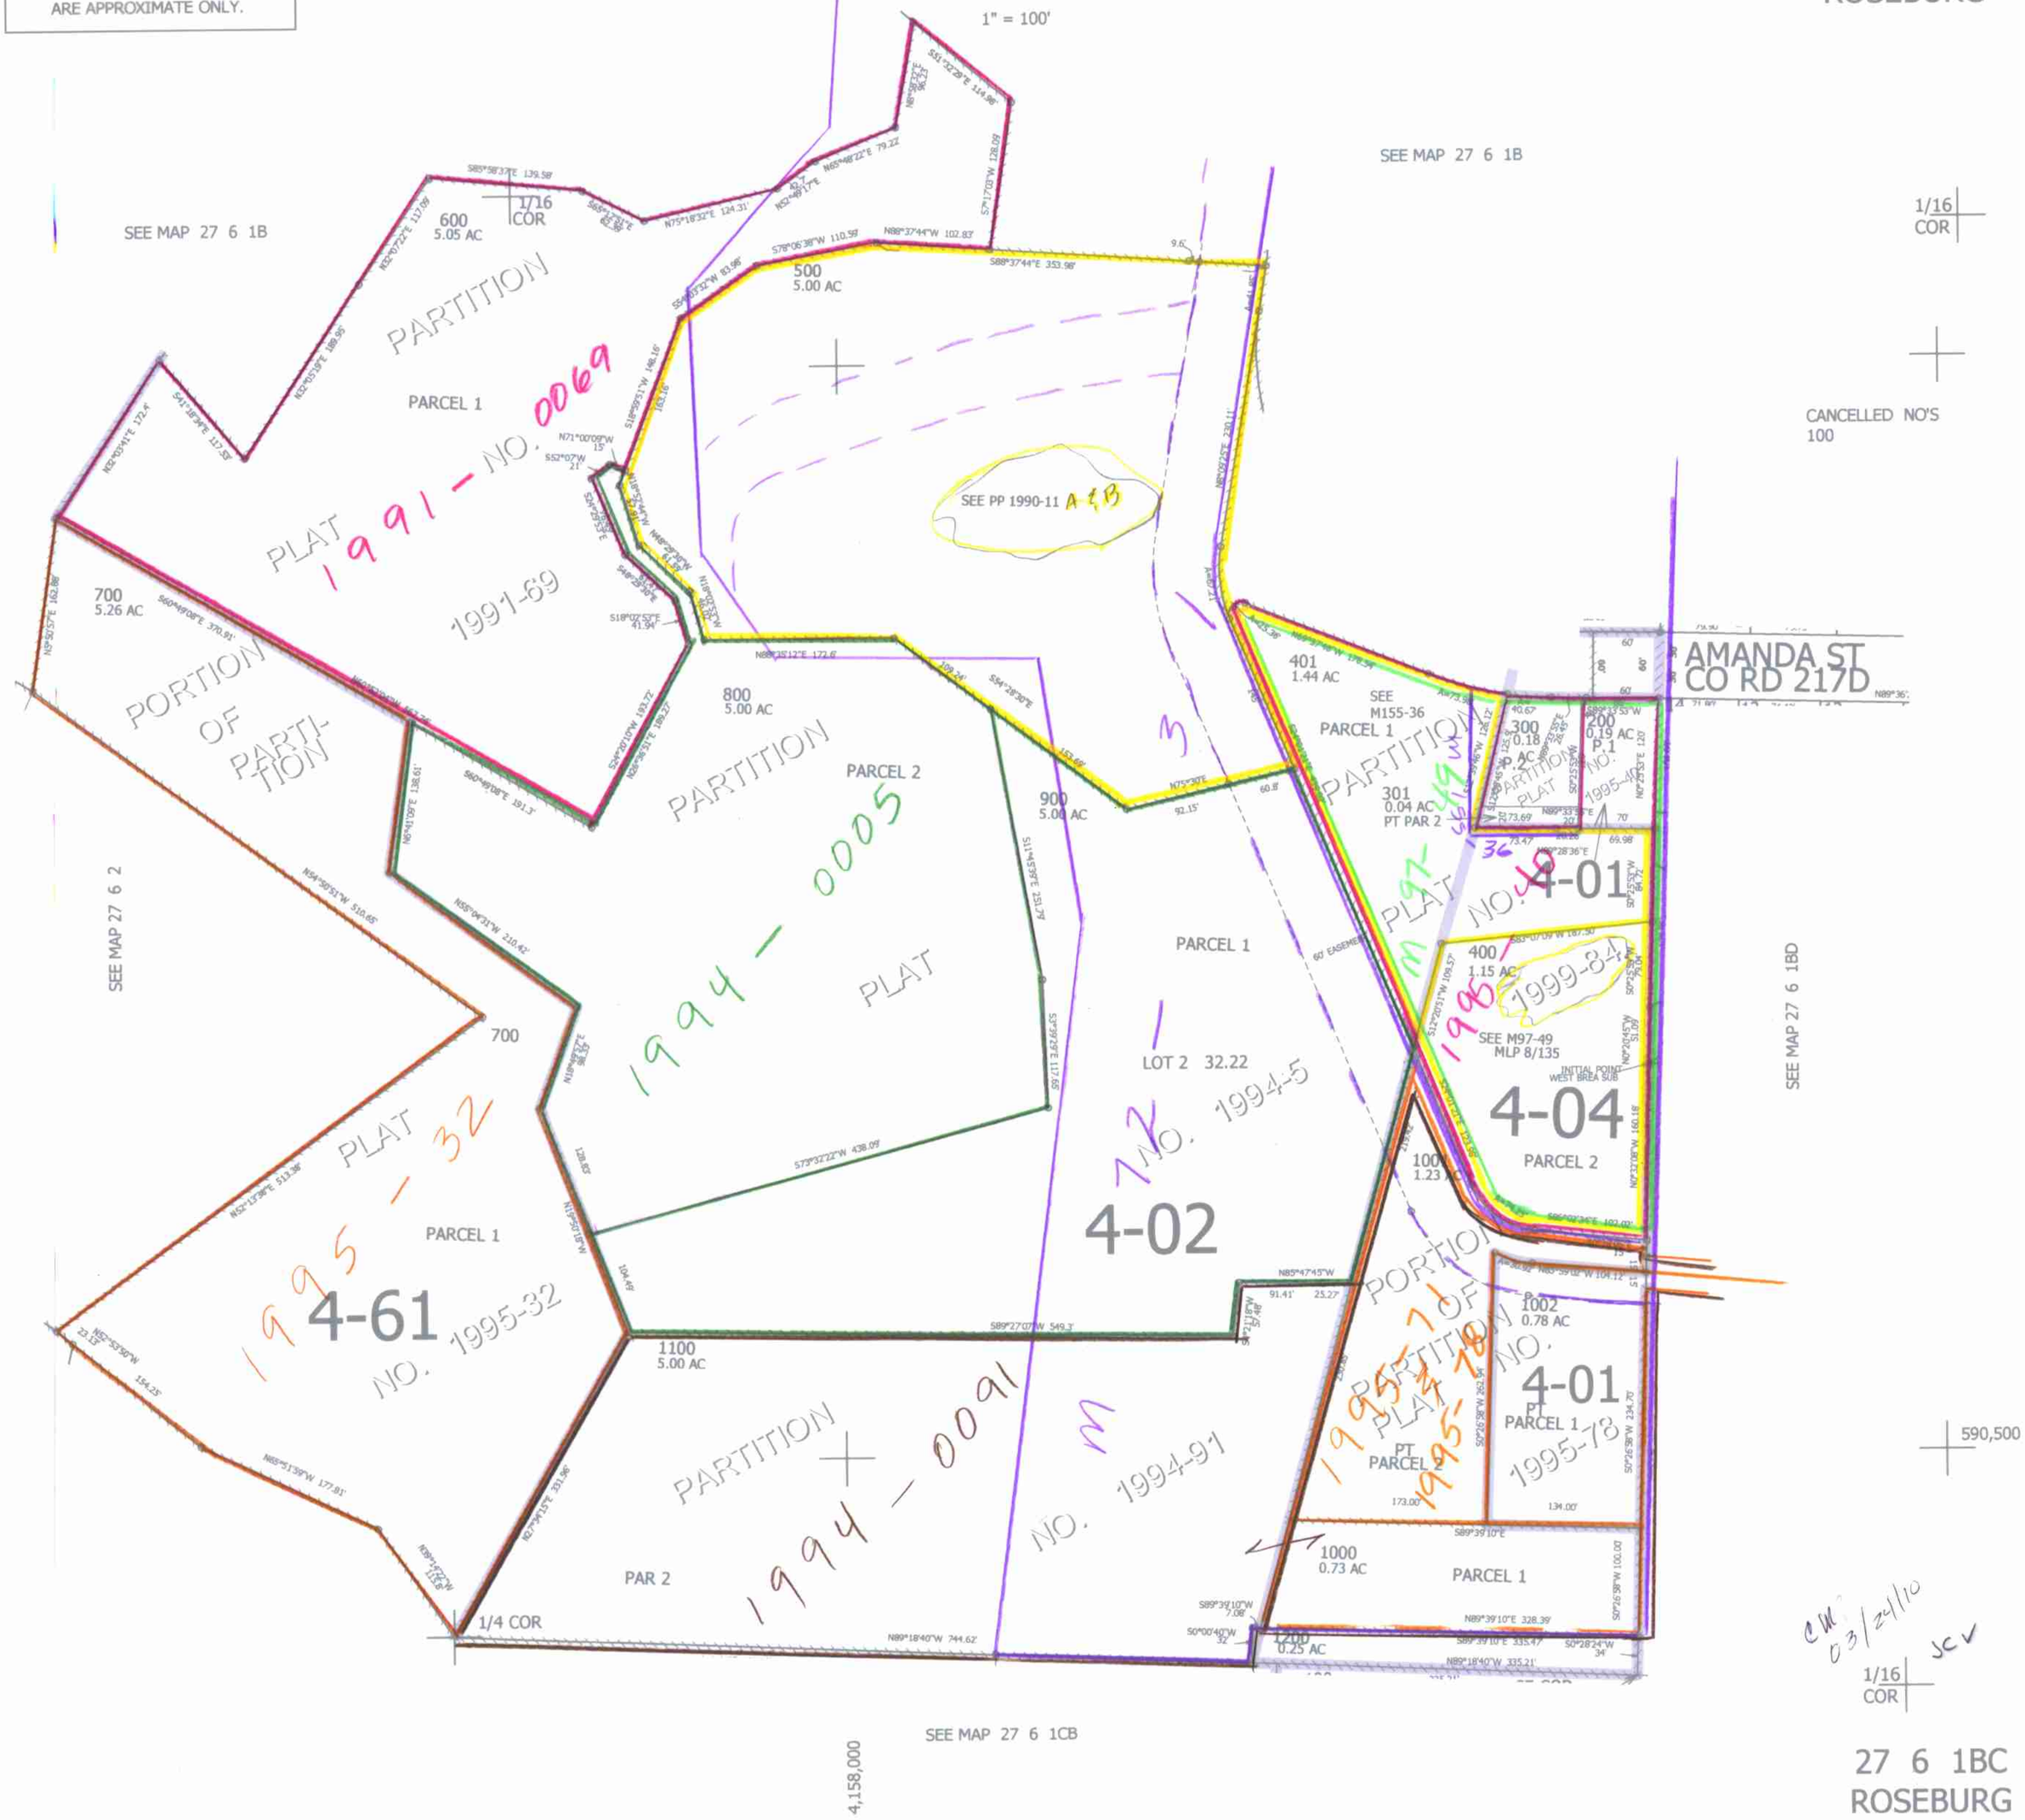

CM 03/24/10 JCV

27 6 1BC
ROSEBURG