

THIS MAP WAS PREPARED FOR ASSESSMENT PURPOSE ONLY.


SEC.7 T30S. R.5W. W.M. DOUGLAS COUNTY

1" = 400'

REVISED ON 5-6-22

30 5 7 & INDEX

CANCELLED NO'S
100A1 2101 900
1900 1000 1100
2000 1200 1300
1400 1500 1600
403 1700 400
404 300 701
702 804

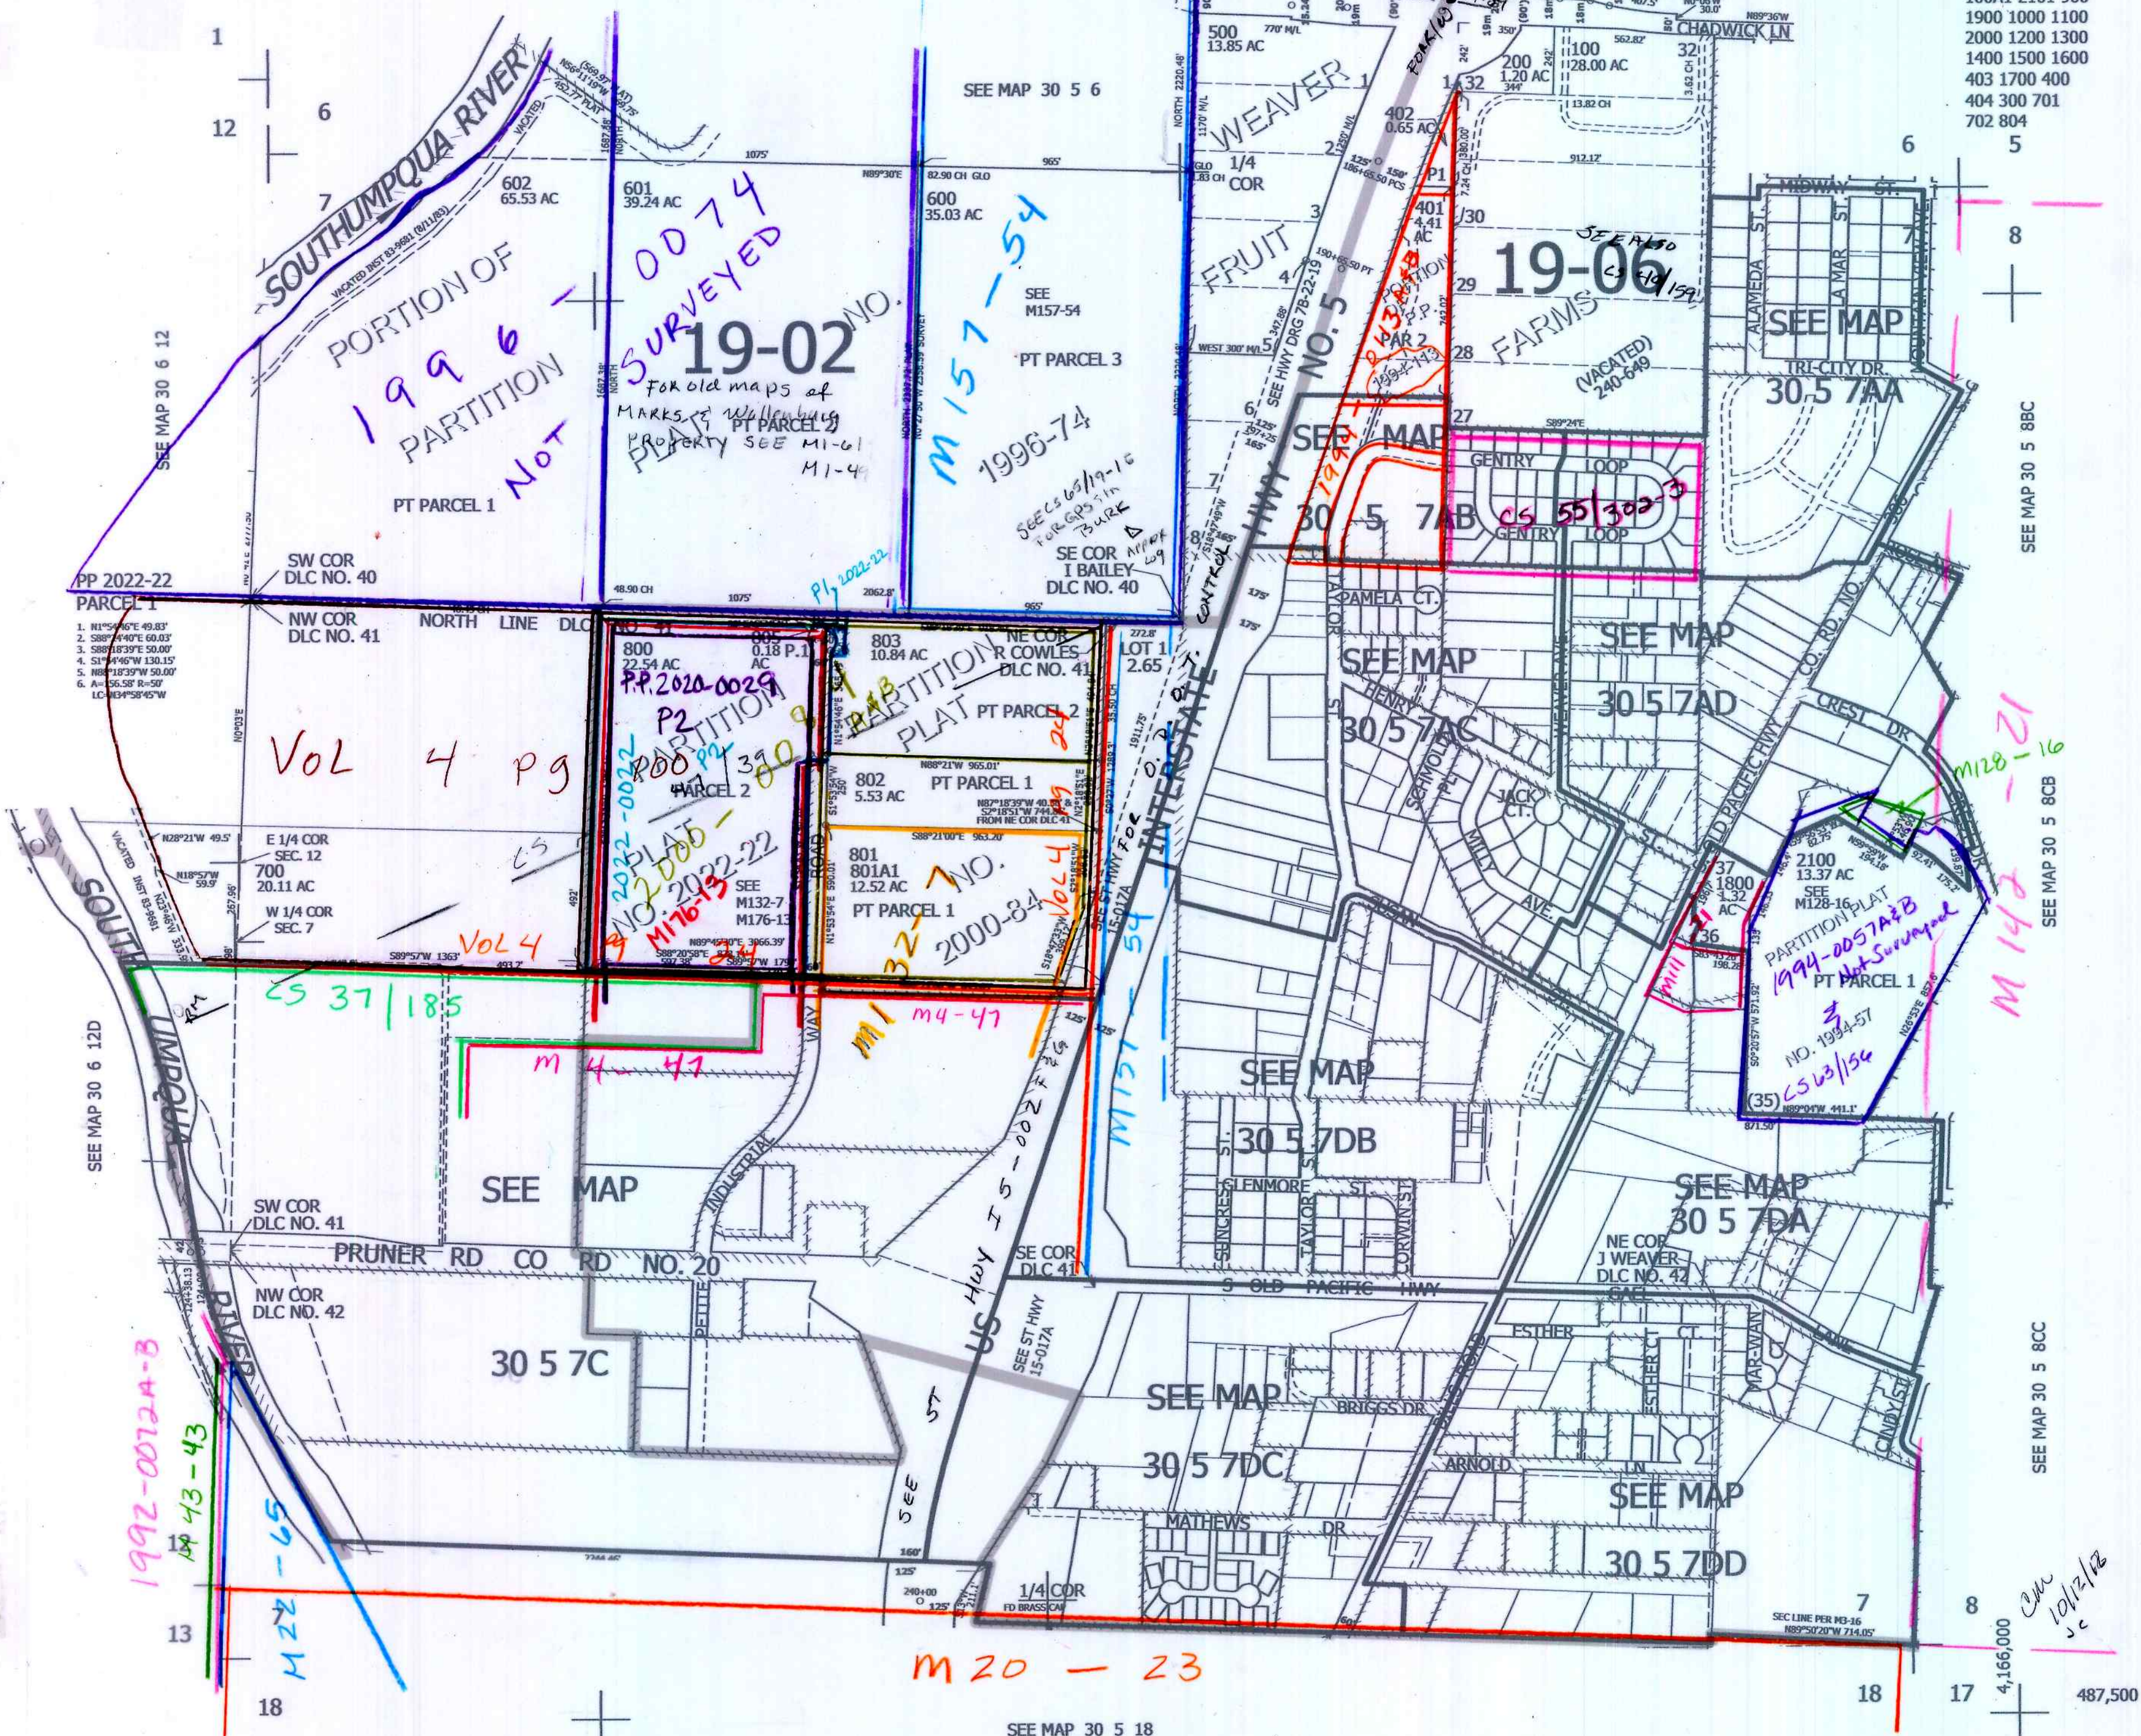

SEE MAP 30 5 18

SEE MAP 30 5 8BC

SEE MAP 30 5 8CB

SEE MAP 30 5 8CC

4,166,000
10/12/12
JC

30 5 7 & INDEX