THIS MAP WAS PREPARED FOR ASSESSMENT PURPOSE ONLY.

SEC.15 T30S. R.5W. W.M.
DOUGLAS COUNTY

1" = 400'

REVISED ON 10-28-20

30 5 15

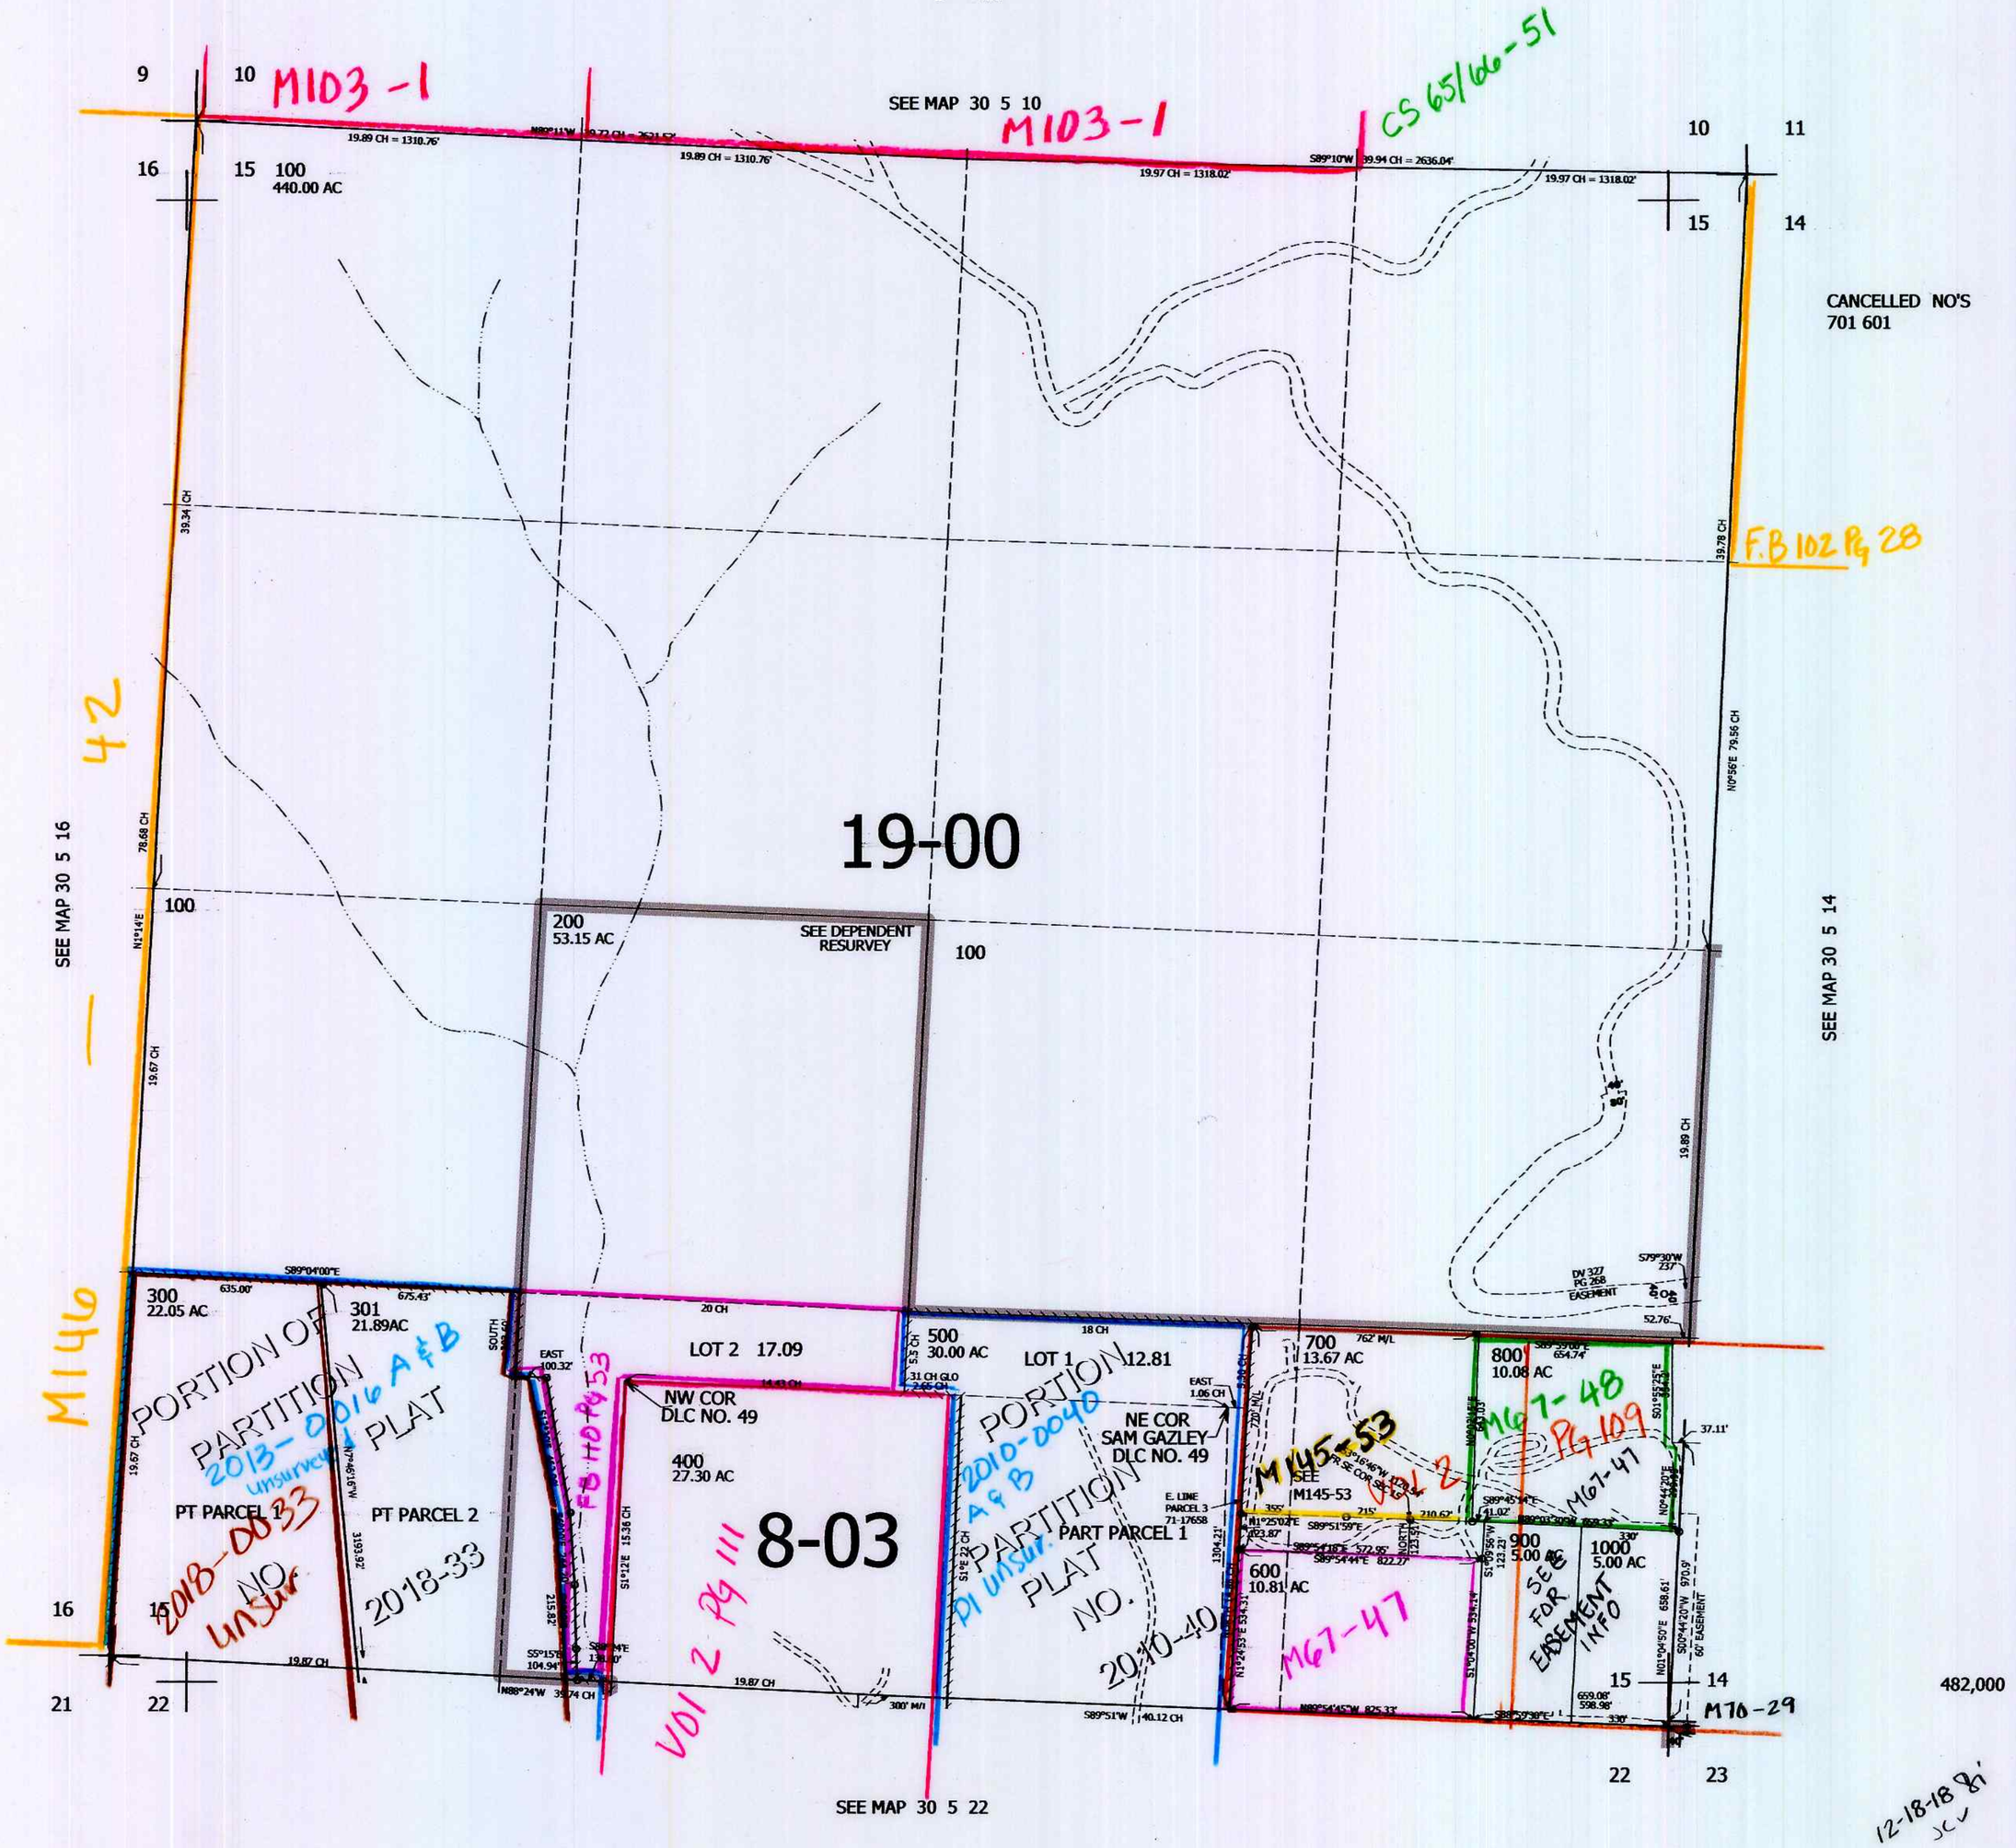

30 5 15