THIS MAP WAS PREPARED FOR ASSESSMENT PURPOSE ONLY.

SEC.16 T30S. R.5W. W.M.
DOUGLAS COUNTY

1" = 400'

REVISED ON 7-29-13

30 5 16

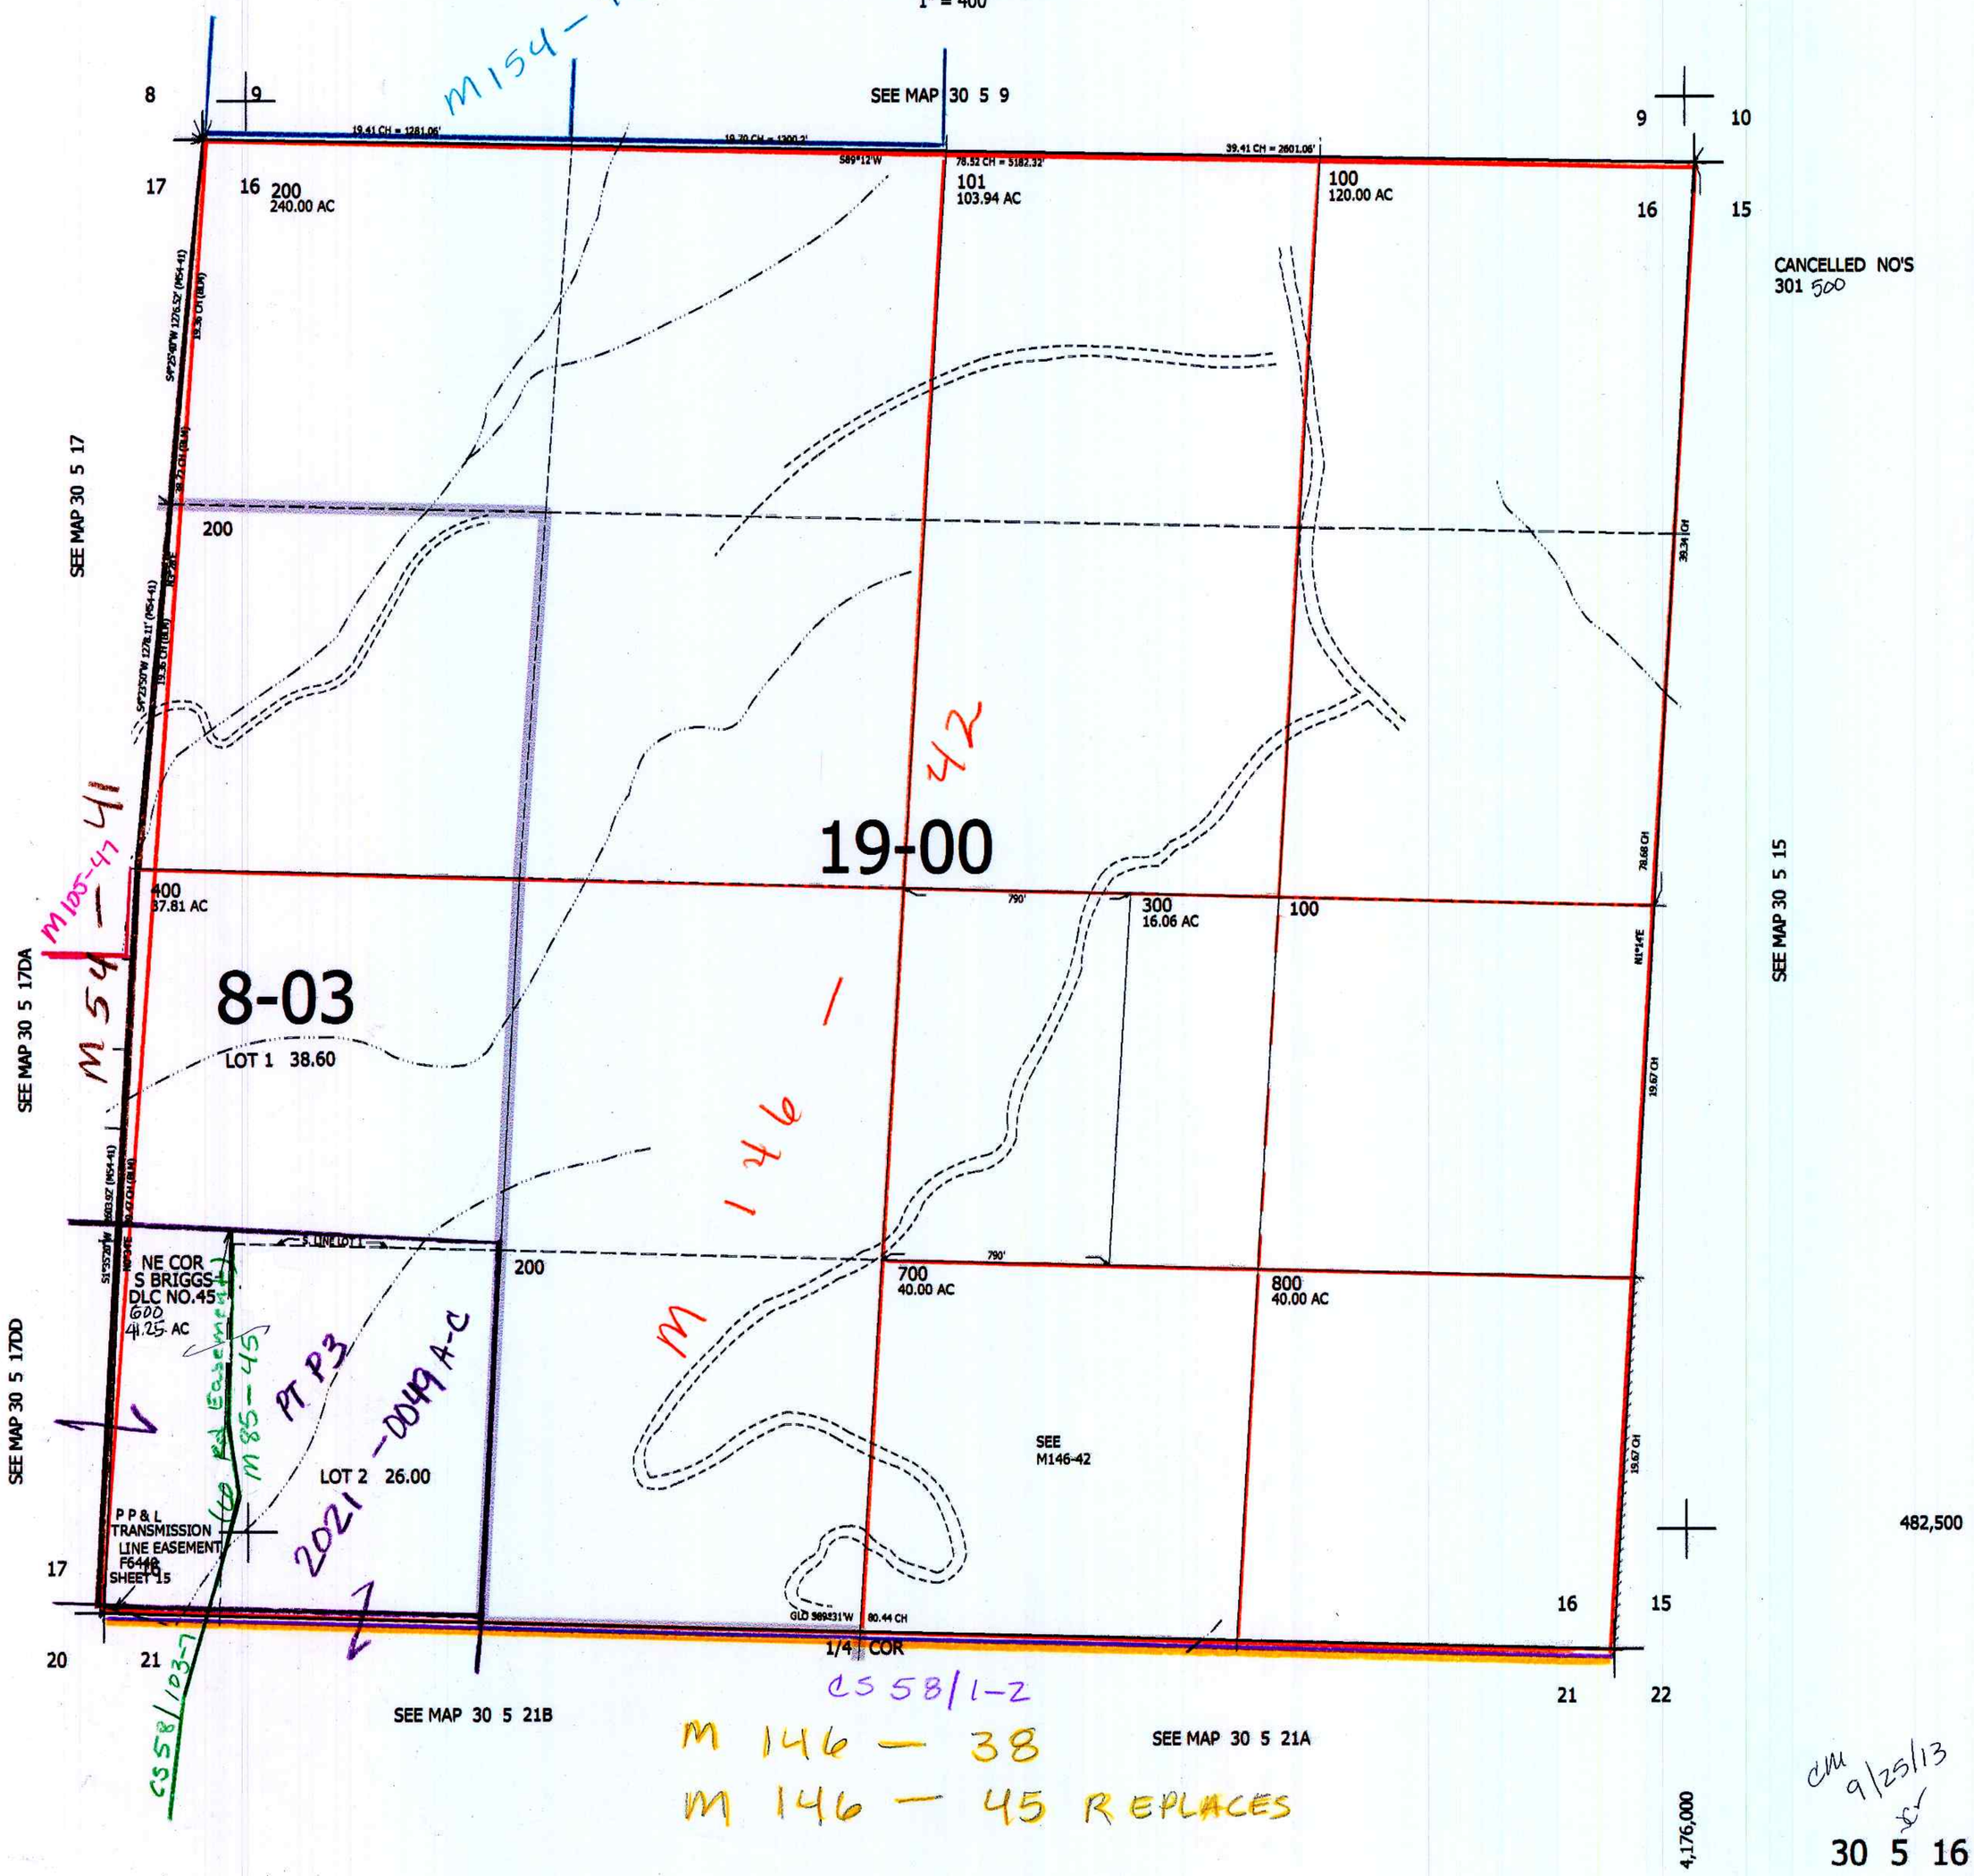

CM 9/25/13

30 5 16