

NW1/4 NE1/4 SEC. 20 T.30S. R.5W. W.M.  
DOUGLAS COUNTY

30 5 20AB


THIS MAP WAS PREPARED FOR  
ASSESSMENT PURPOSE ONLY.

1"=100'

SEE MAP 30 5 17DC

Cancelled #  
800 962 400

M 54-71

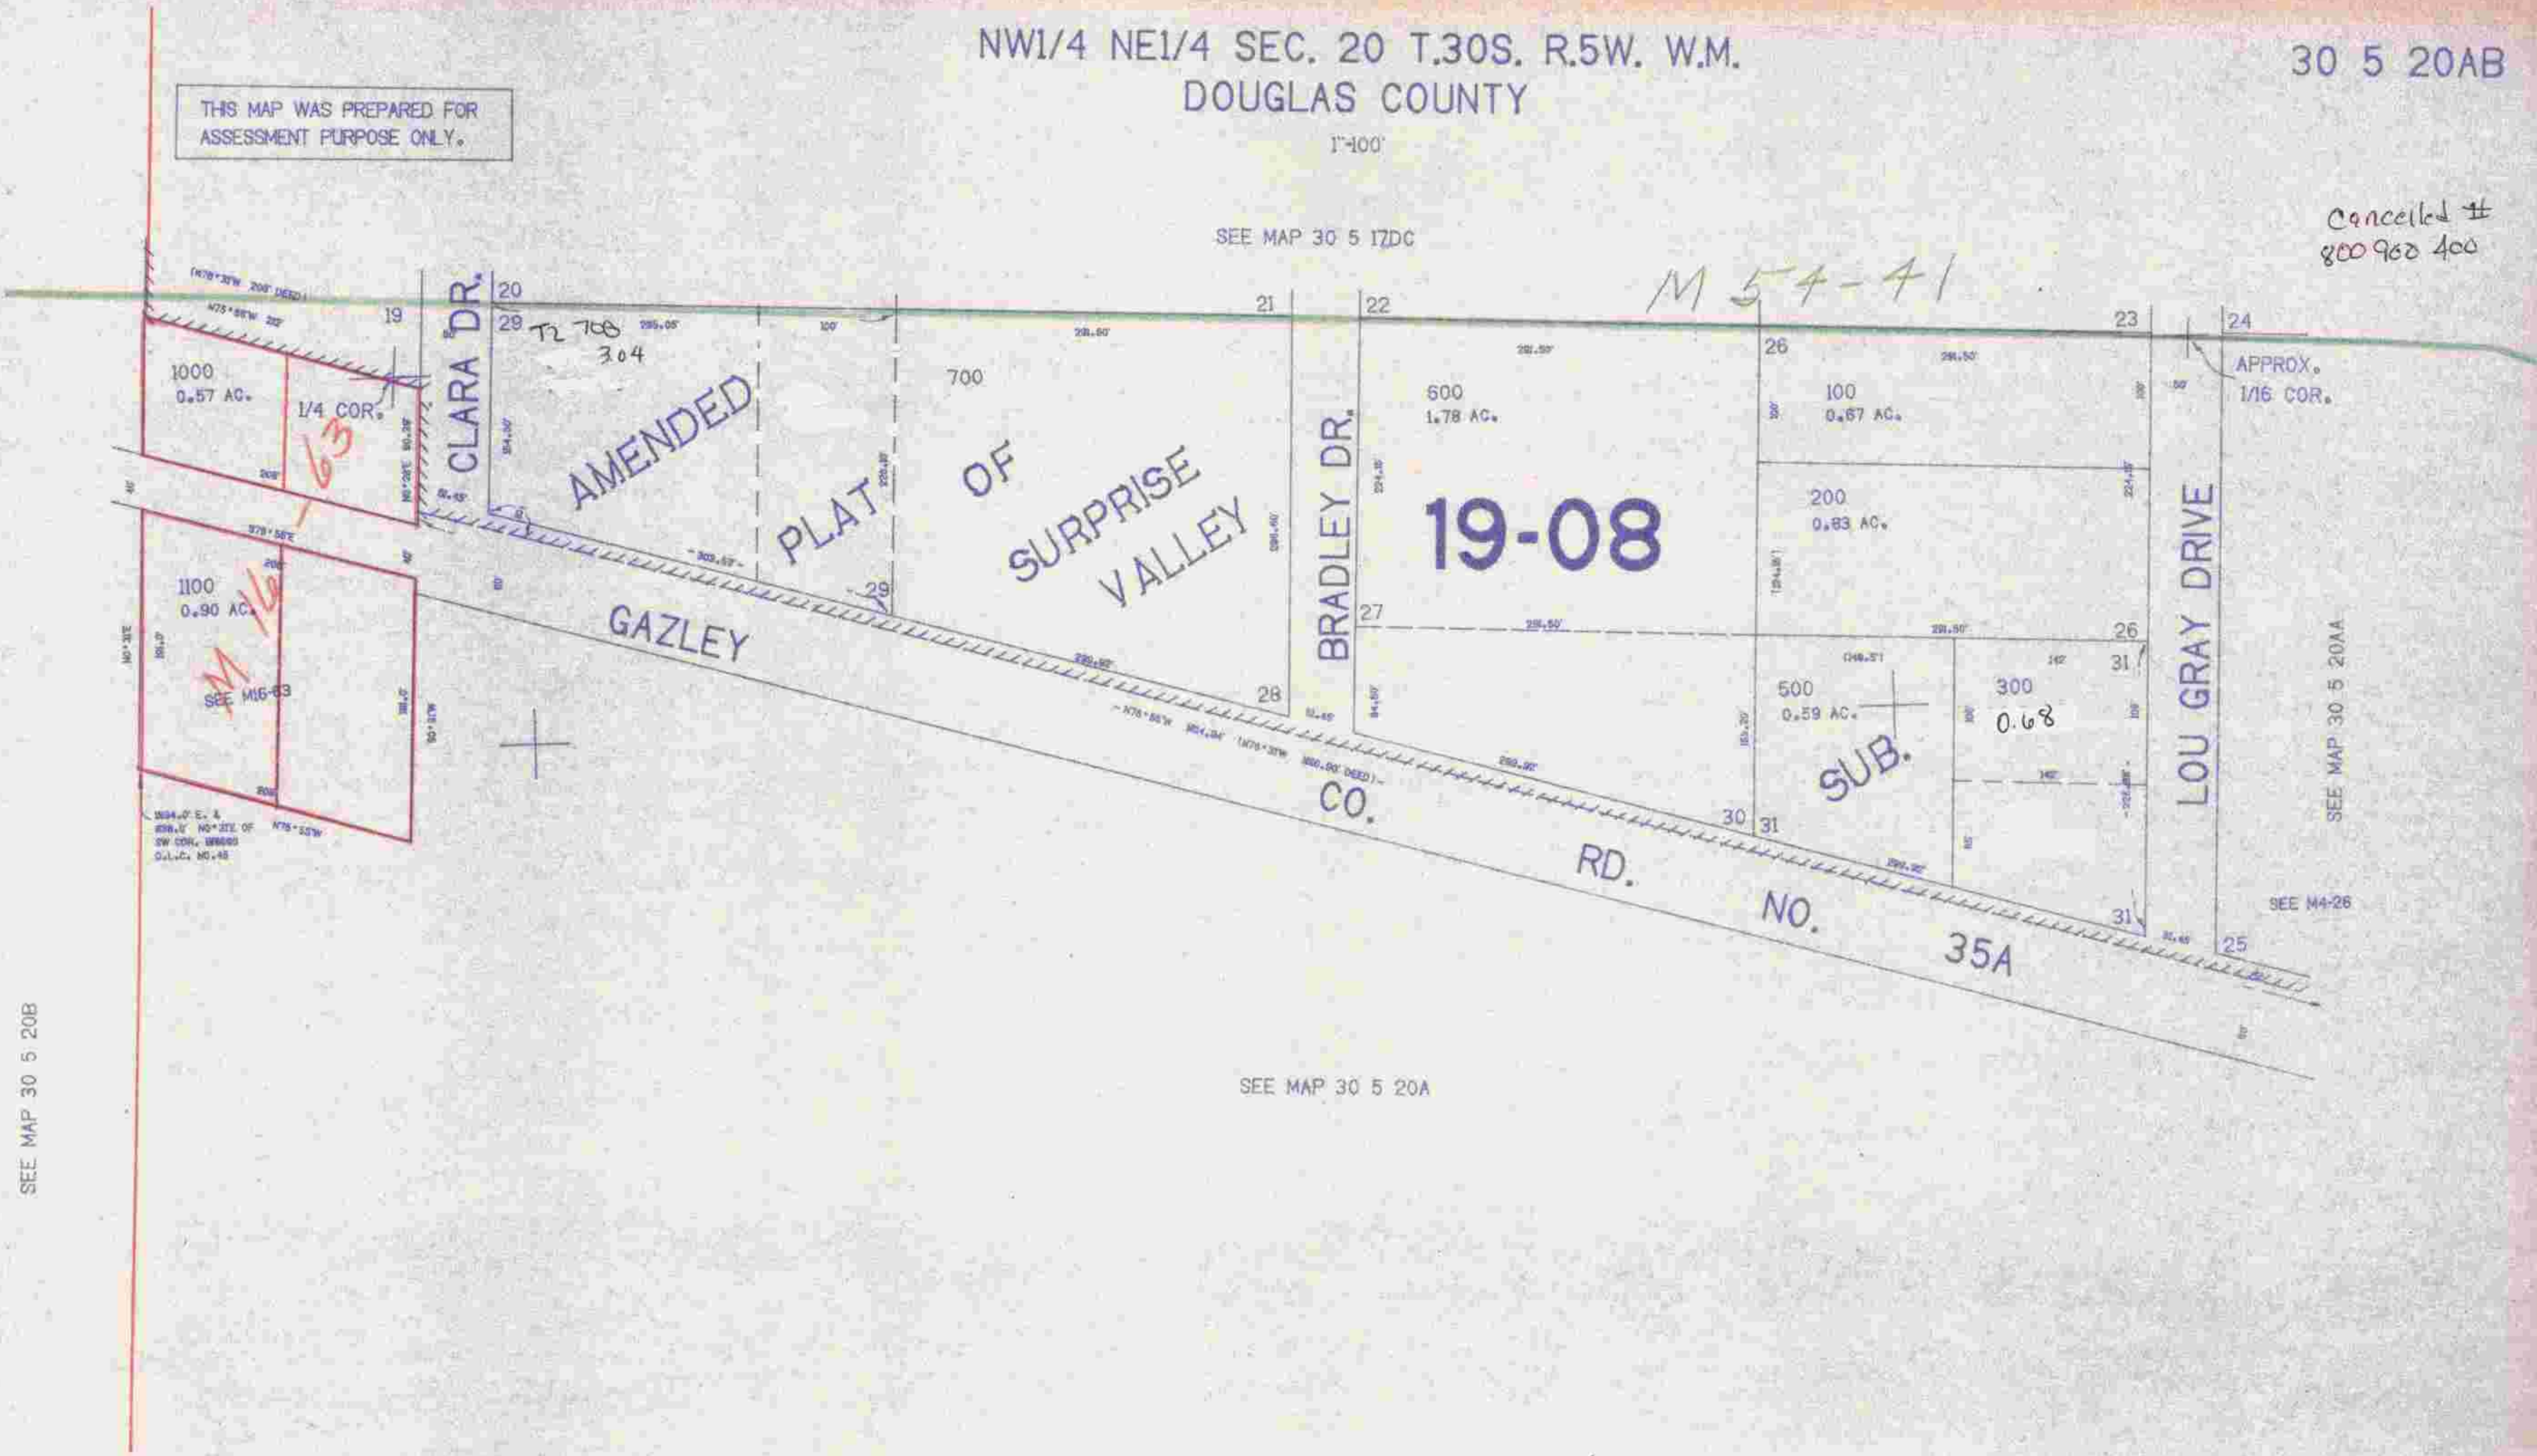

SEE MAP 30 5 20B

SEE MAP 30 5 20A

SEE MAP 30 5 20AA

SEE M4-26

APPROX.  
1/16 COR.

APPROX.  
1/16 COR.

481,000

1248,000

30 5 20AB

8/27/71