


This map was prepared for assessment purpose only.

SECTION 24 T.30S. R. 5 W. W.M.
DOUGLAS COUNTY

REVISED ON
11 - 2 - 93

30 5 24
& INDEX

1" = 400'

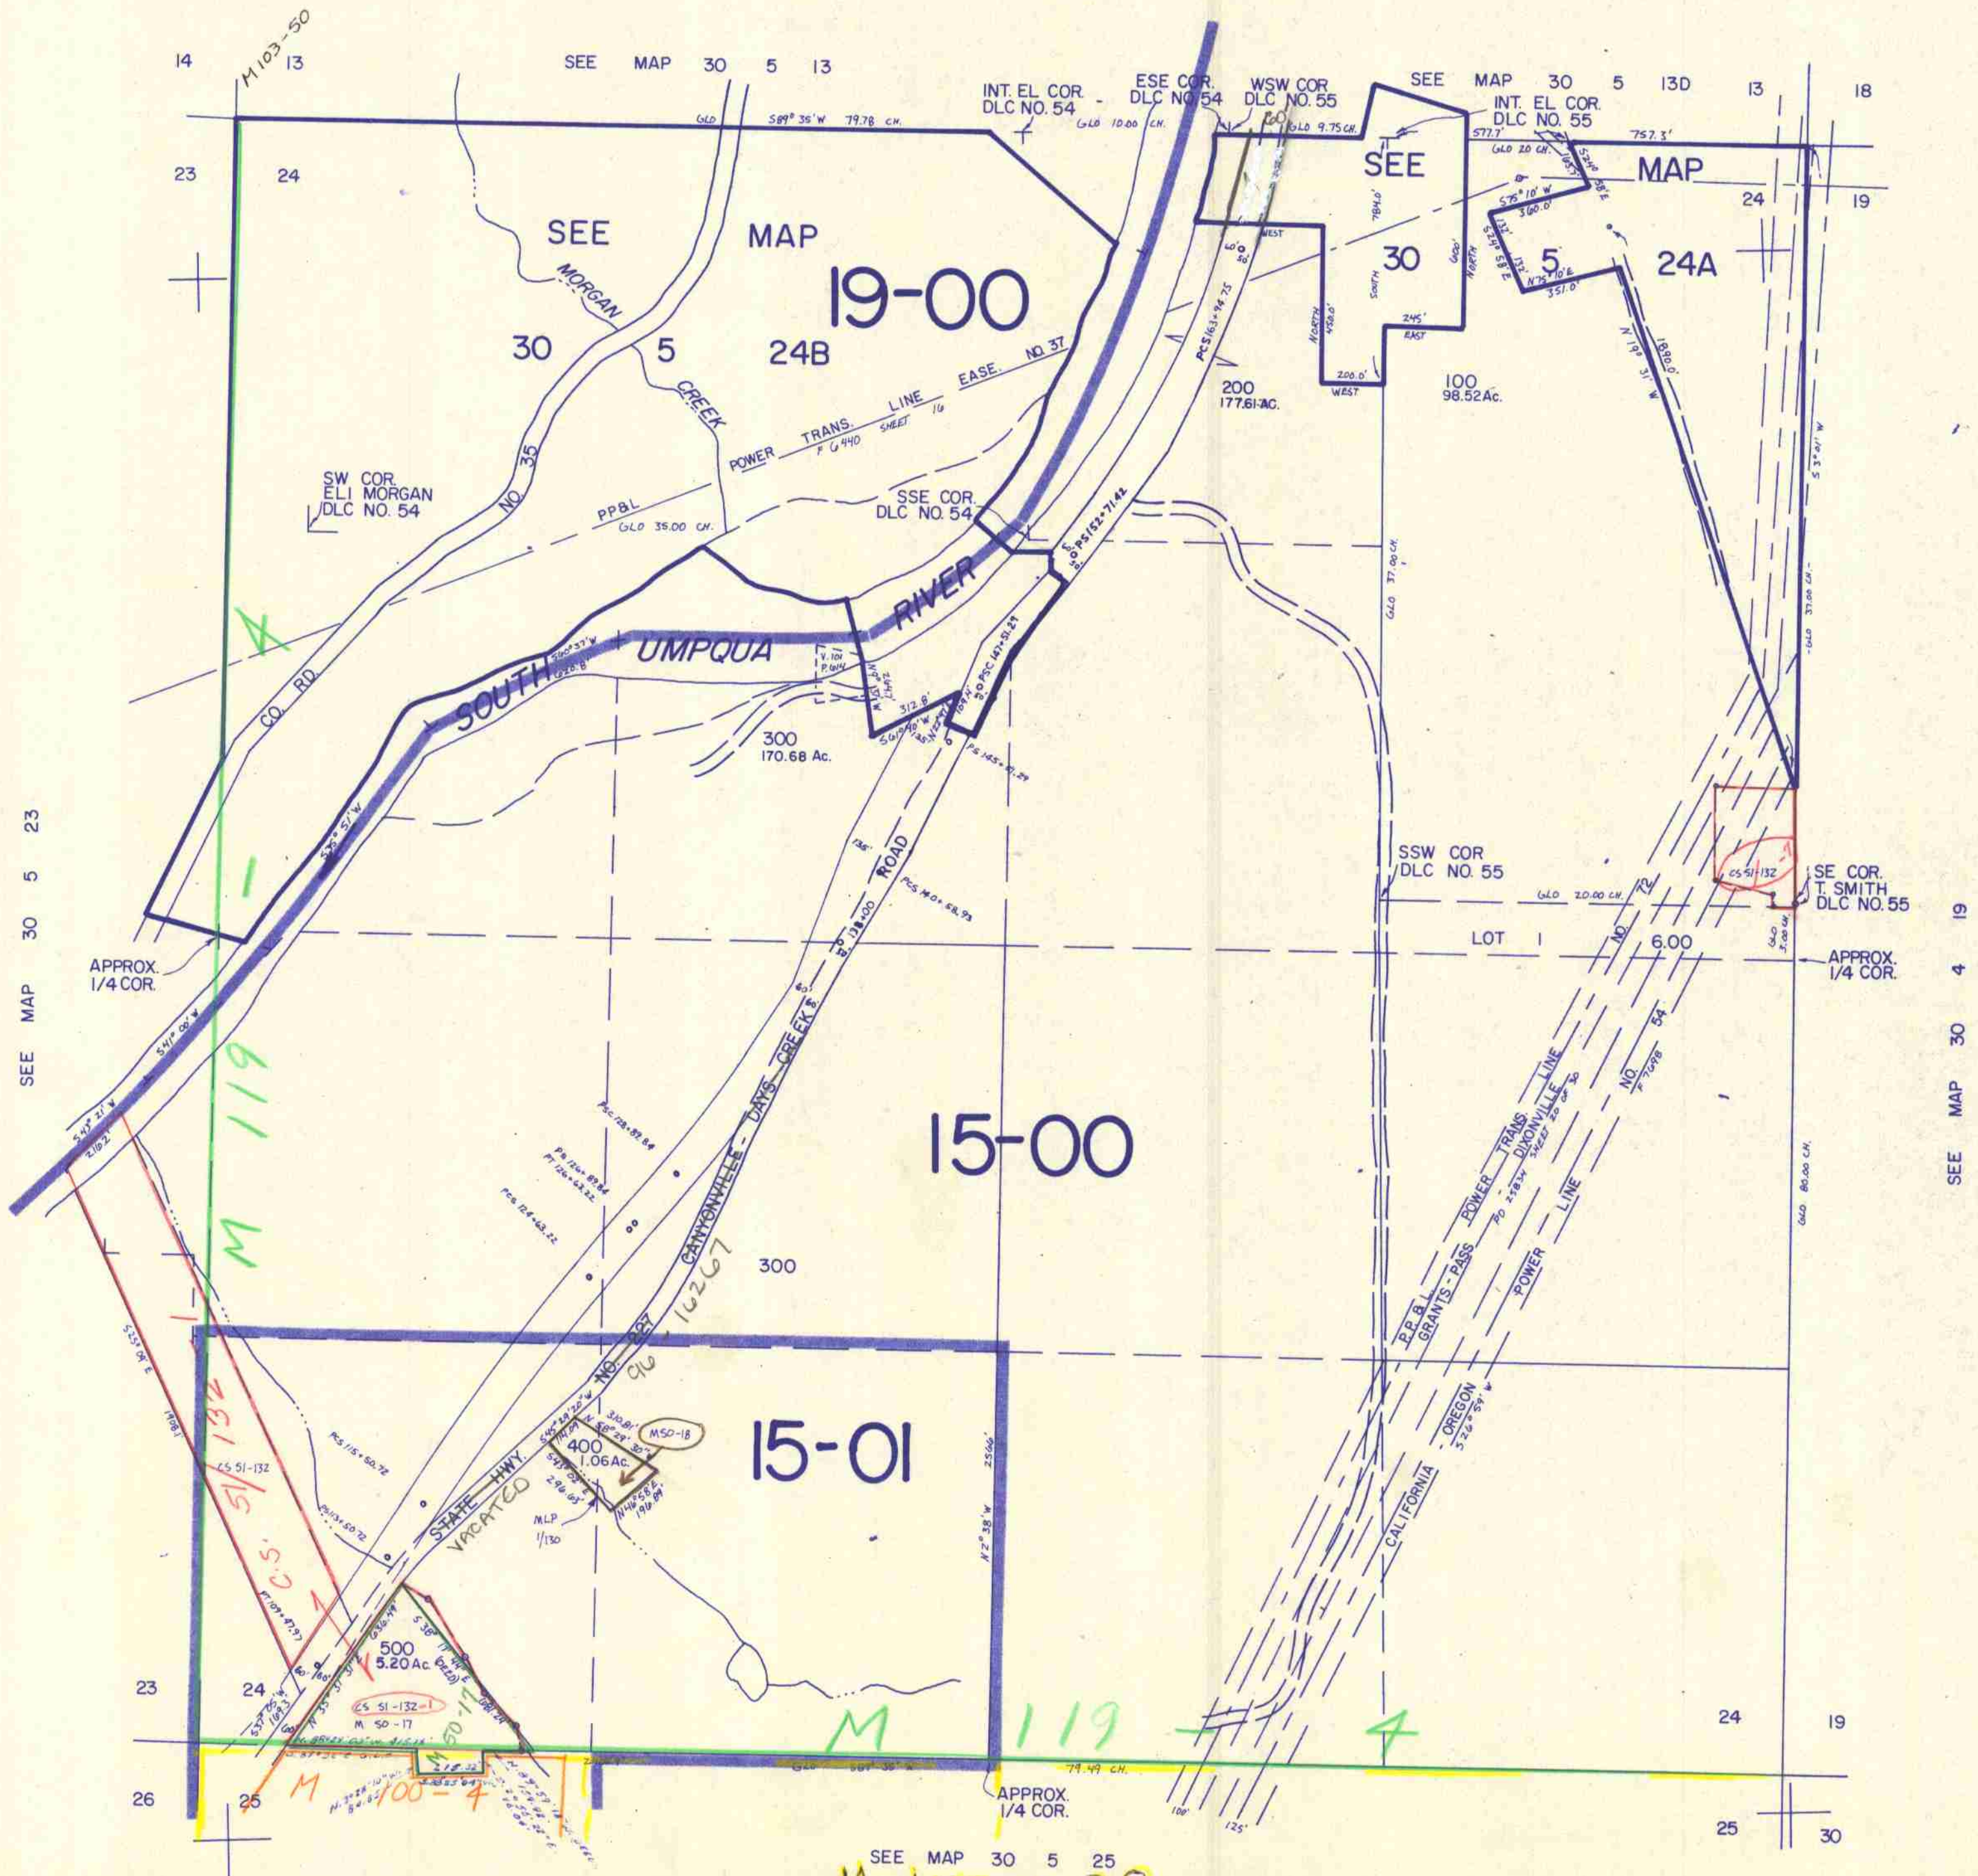

SEE MAP 30 5 25
M 157-28

30 5 24
& INDEX

1193