


SECTION 25 T.30S. R.5W. W.M.
DOUGLAS COUNTY

30 5 25

This map was prepared for
assessment purpose only.

1" = 400'

CANCELLED PARCEL NO'S
201 - 204

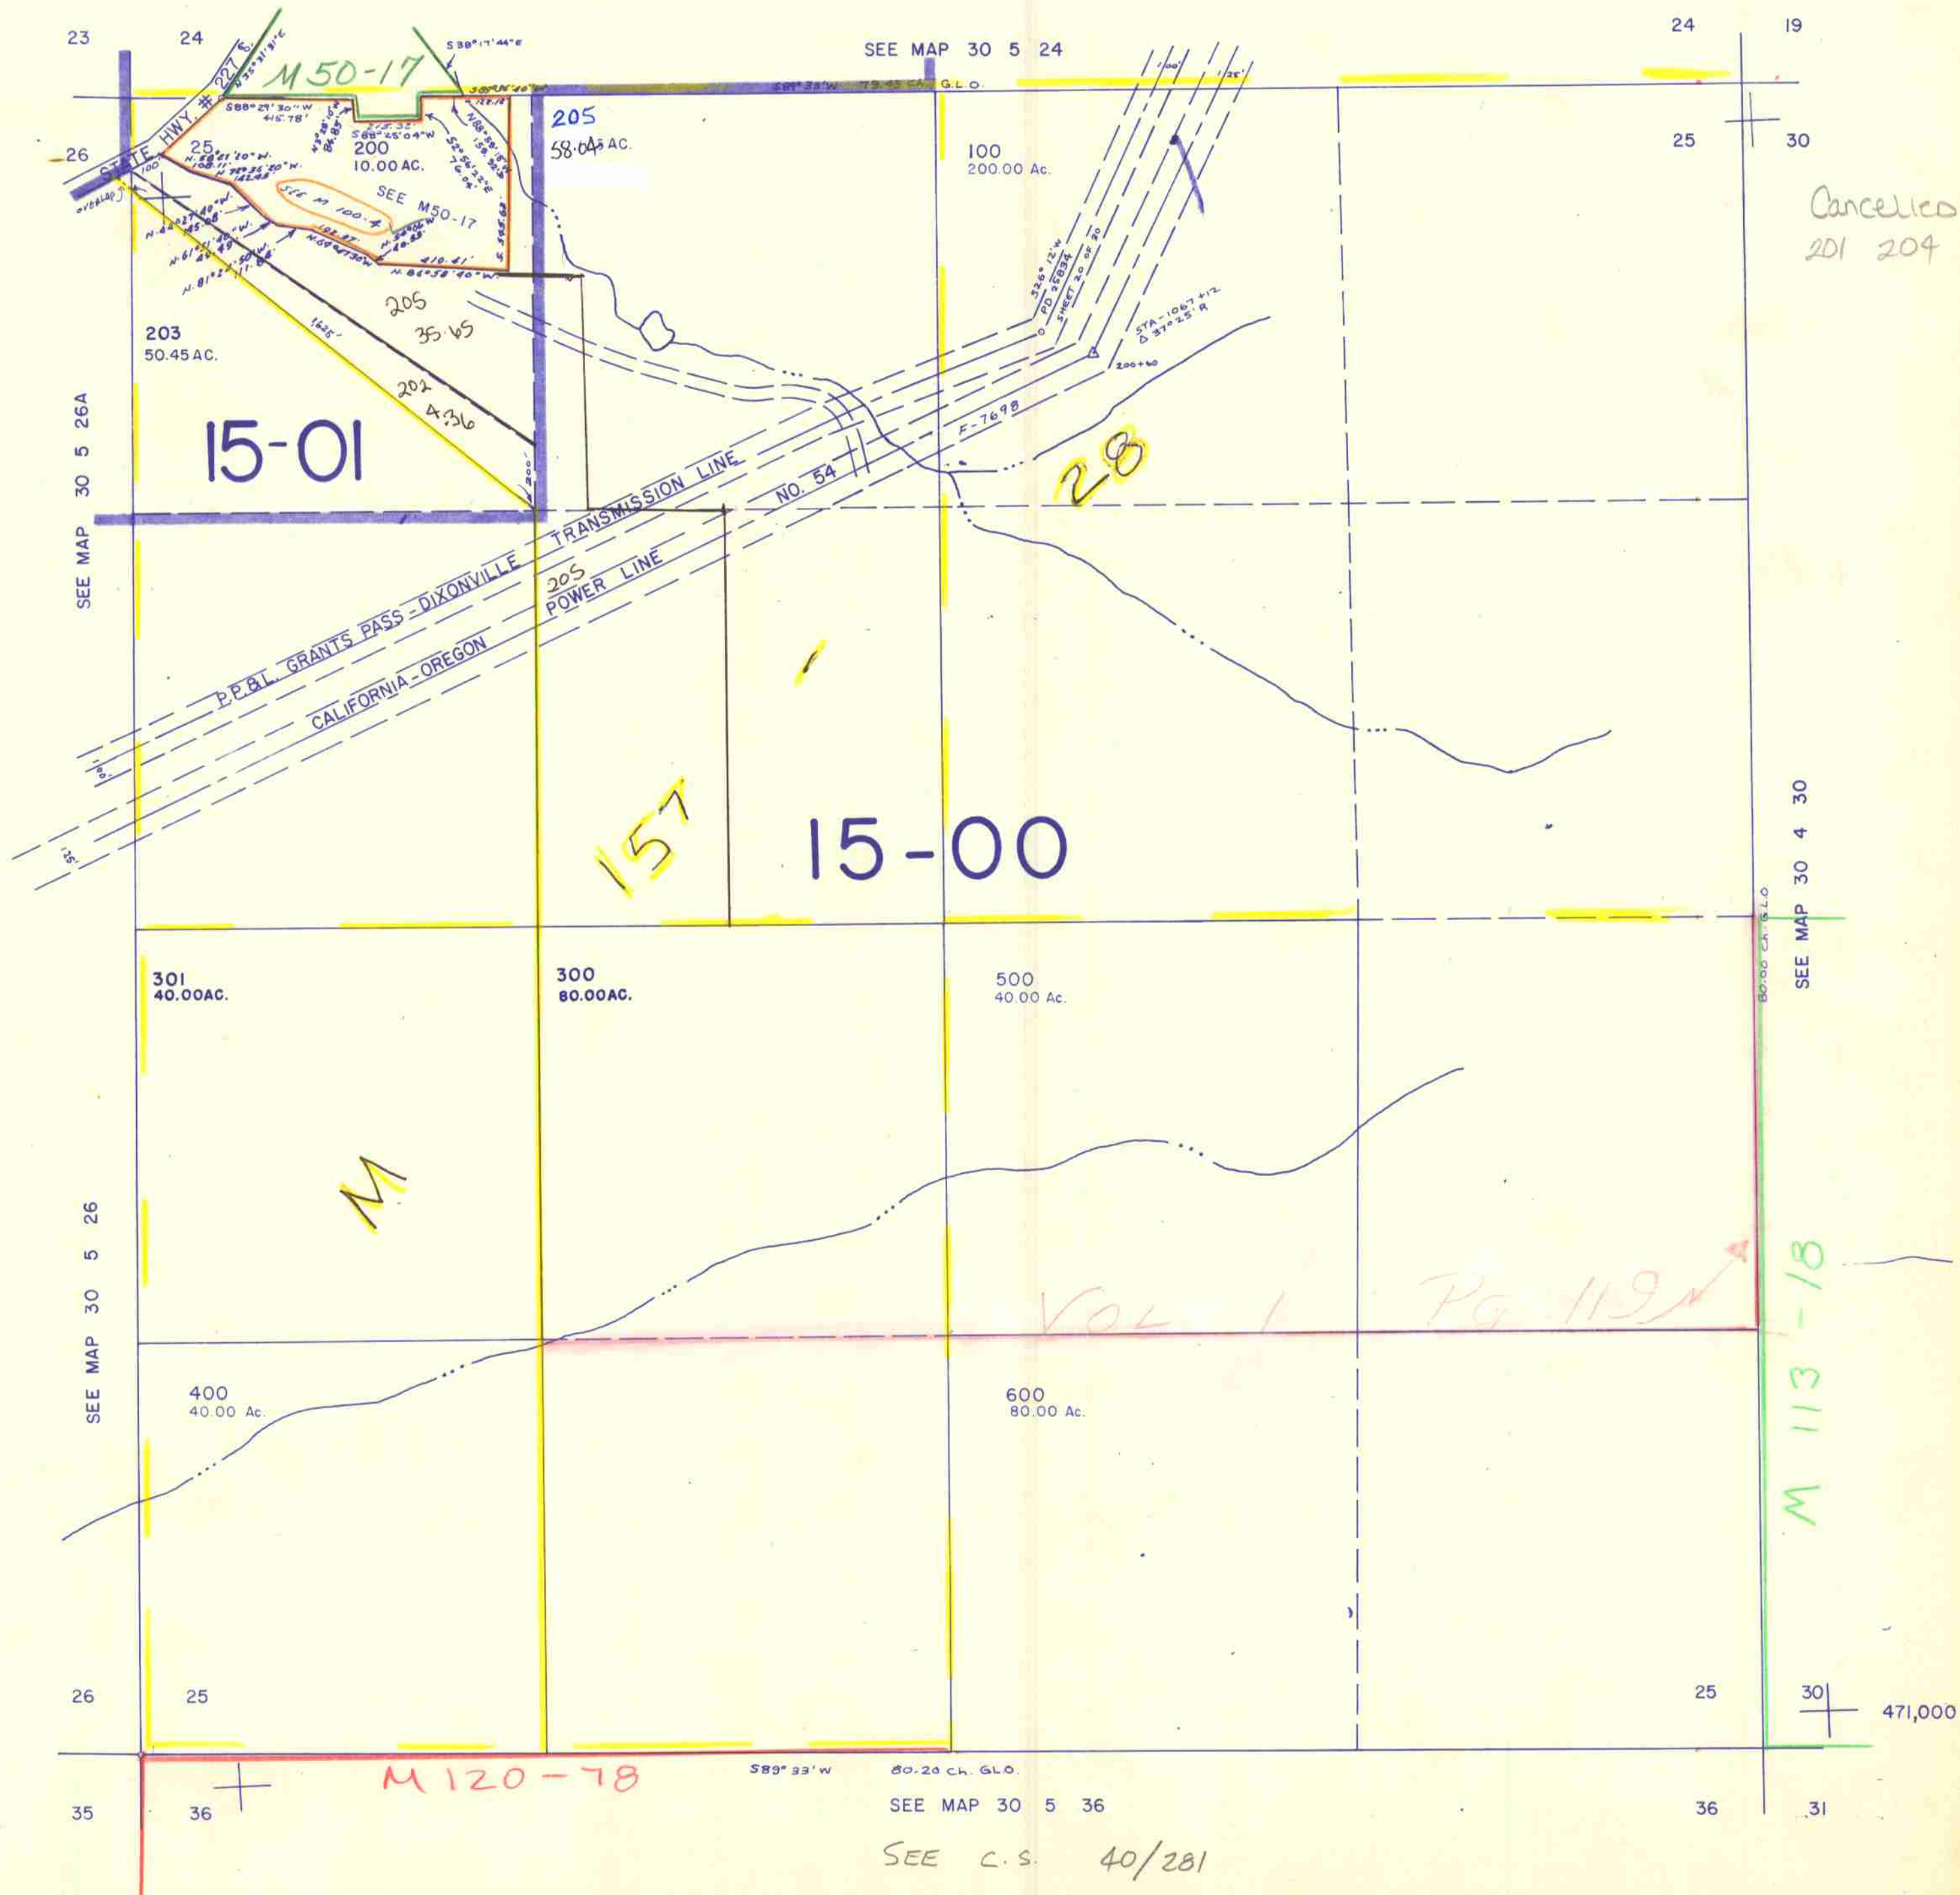

Cancelled No's
201 204

SEE MAP 30 4 30

M 113-18

471,000

SEE C.S. 40/281

30 5 25

11/90
C.S.