


This map was prepared for assessment purpose only.

SECTION 8 T.30S. R. 6 W. W.M.
DOUGLAS COUNTY

30 6 8

1" = 400'

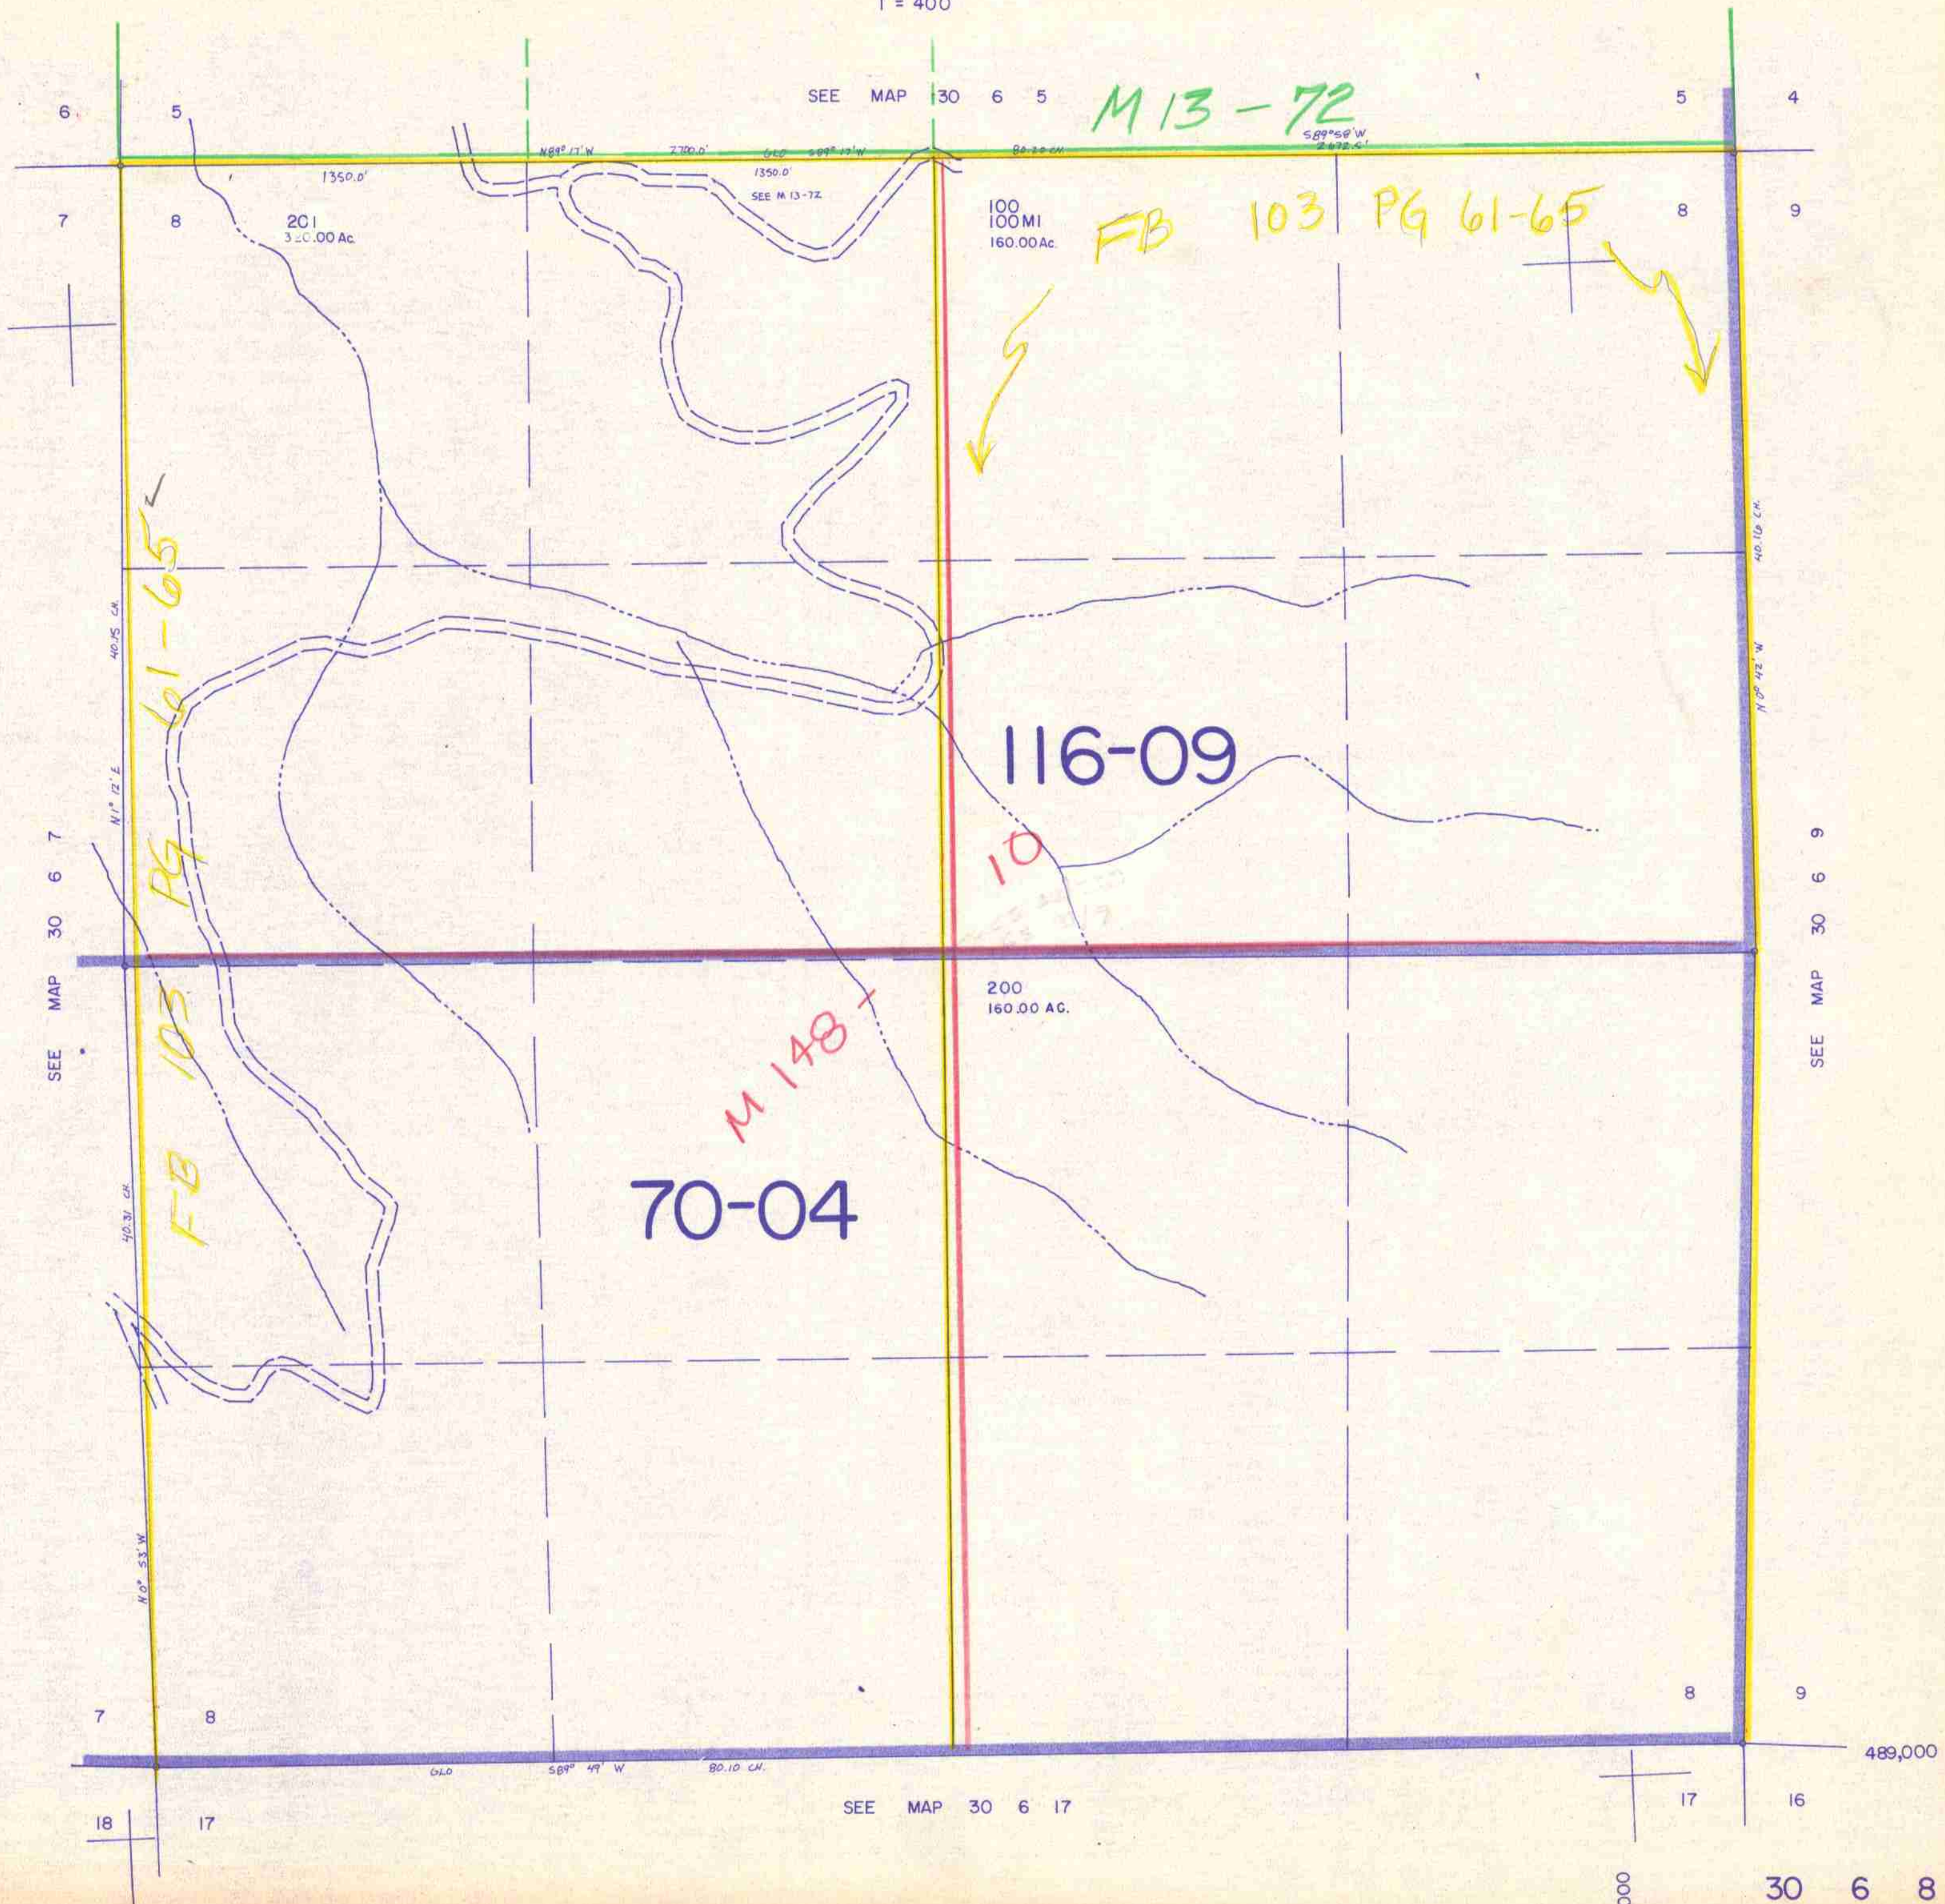

1,217,000

30 6 8

12185
CMO