


SECTION 13 T.30S. R.6W. W.M.  
DOUGLAS COUNTY

30 6 13  
& INDEX

THIS MAP WAS PREPARED FOR  
ASSESSMENT PURPOSE ONLY.

1"=400'

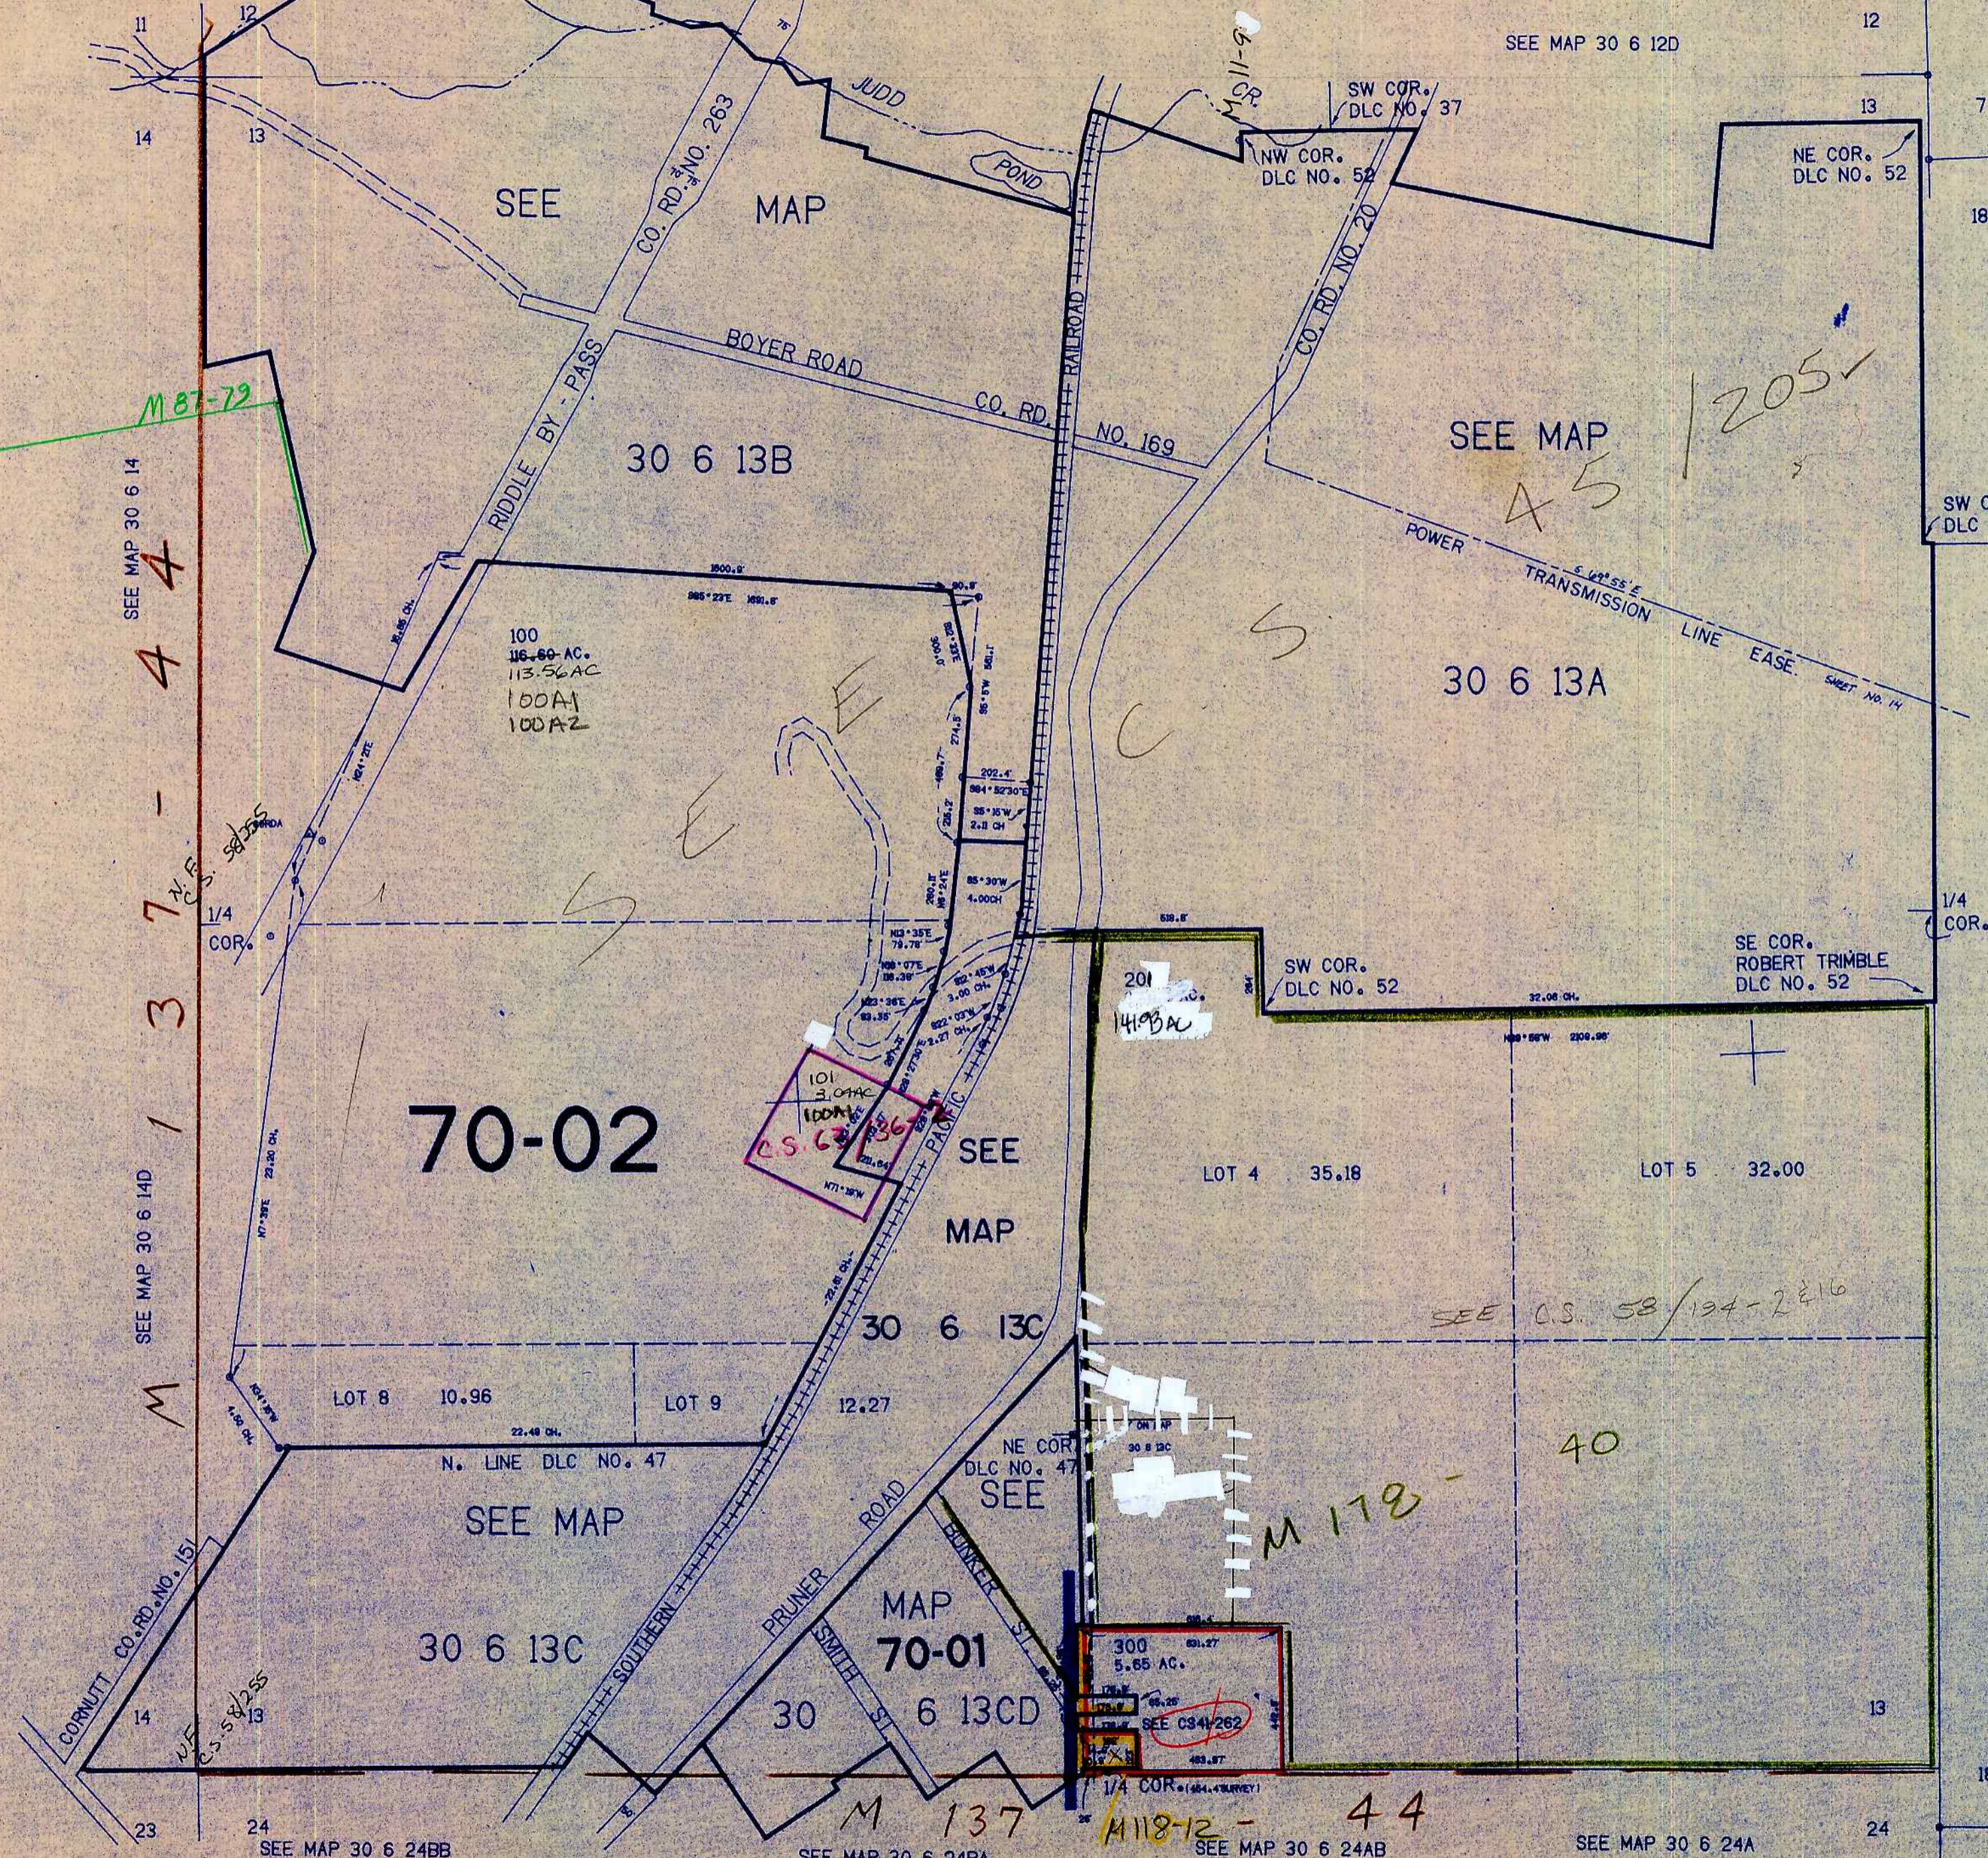

Cancelled  
#s

- 202
- 203
- 204
- 200

SEE MAP 30 6 14  
4  
4  
4  
1  
3  
7  
1  
3  
7  
M  
C.S. 58/134-2E16

SEE MAP 30 5 18

485.000

30 6 13  
& INDEX

11/83  
88