This map was prepared for assessment purpose only.

SECTION 21 T.30S. R. 6 W. W.M.
DOUGLAS COUNTY
1" = 400'
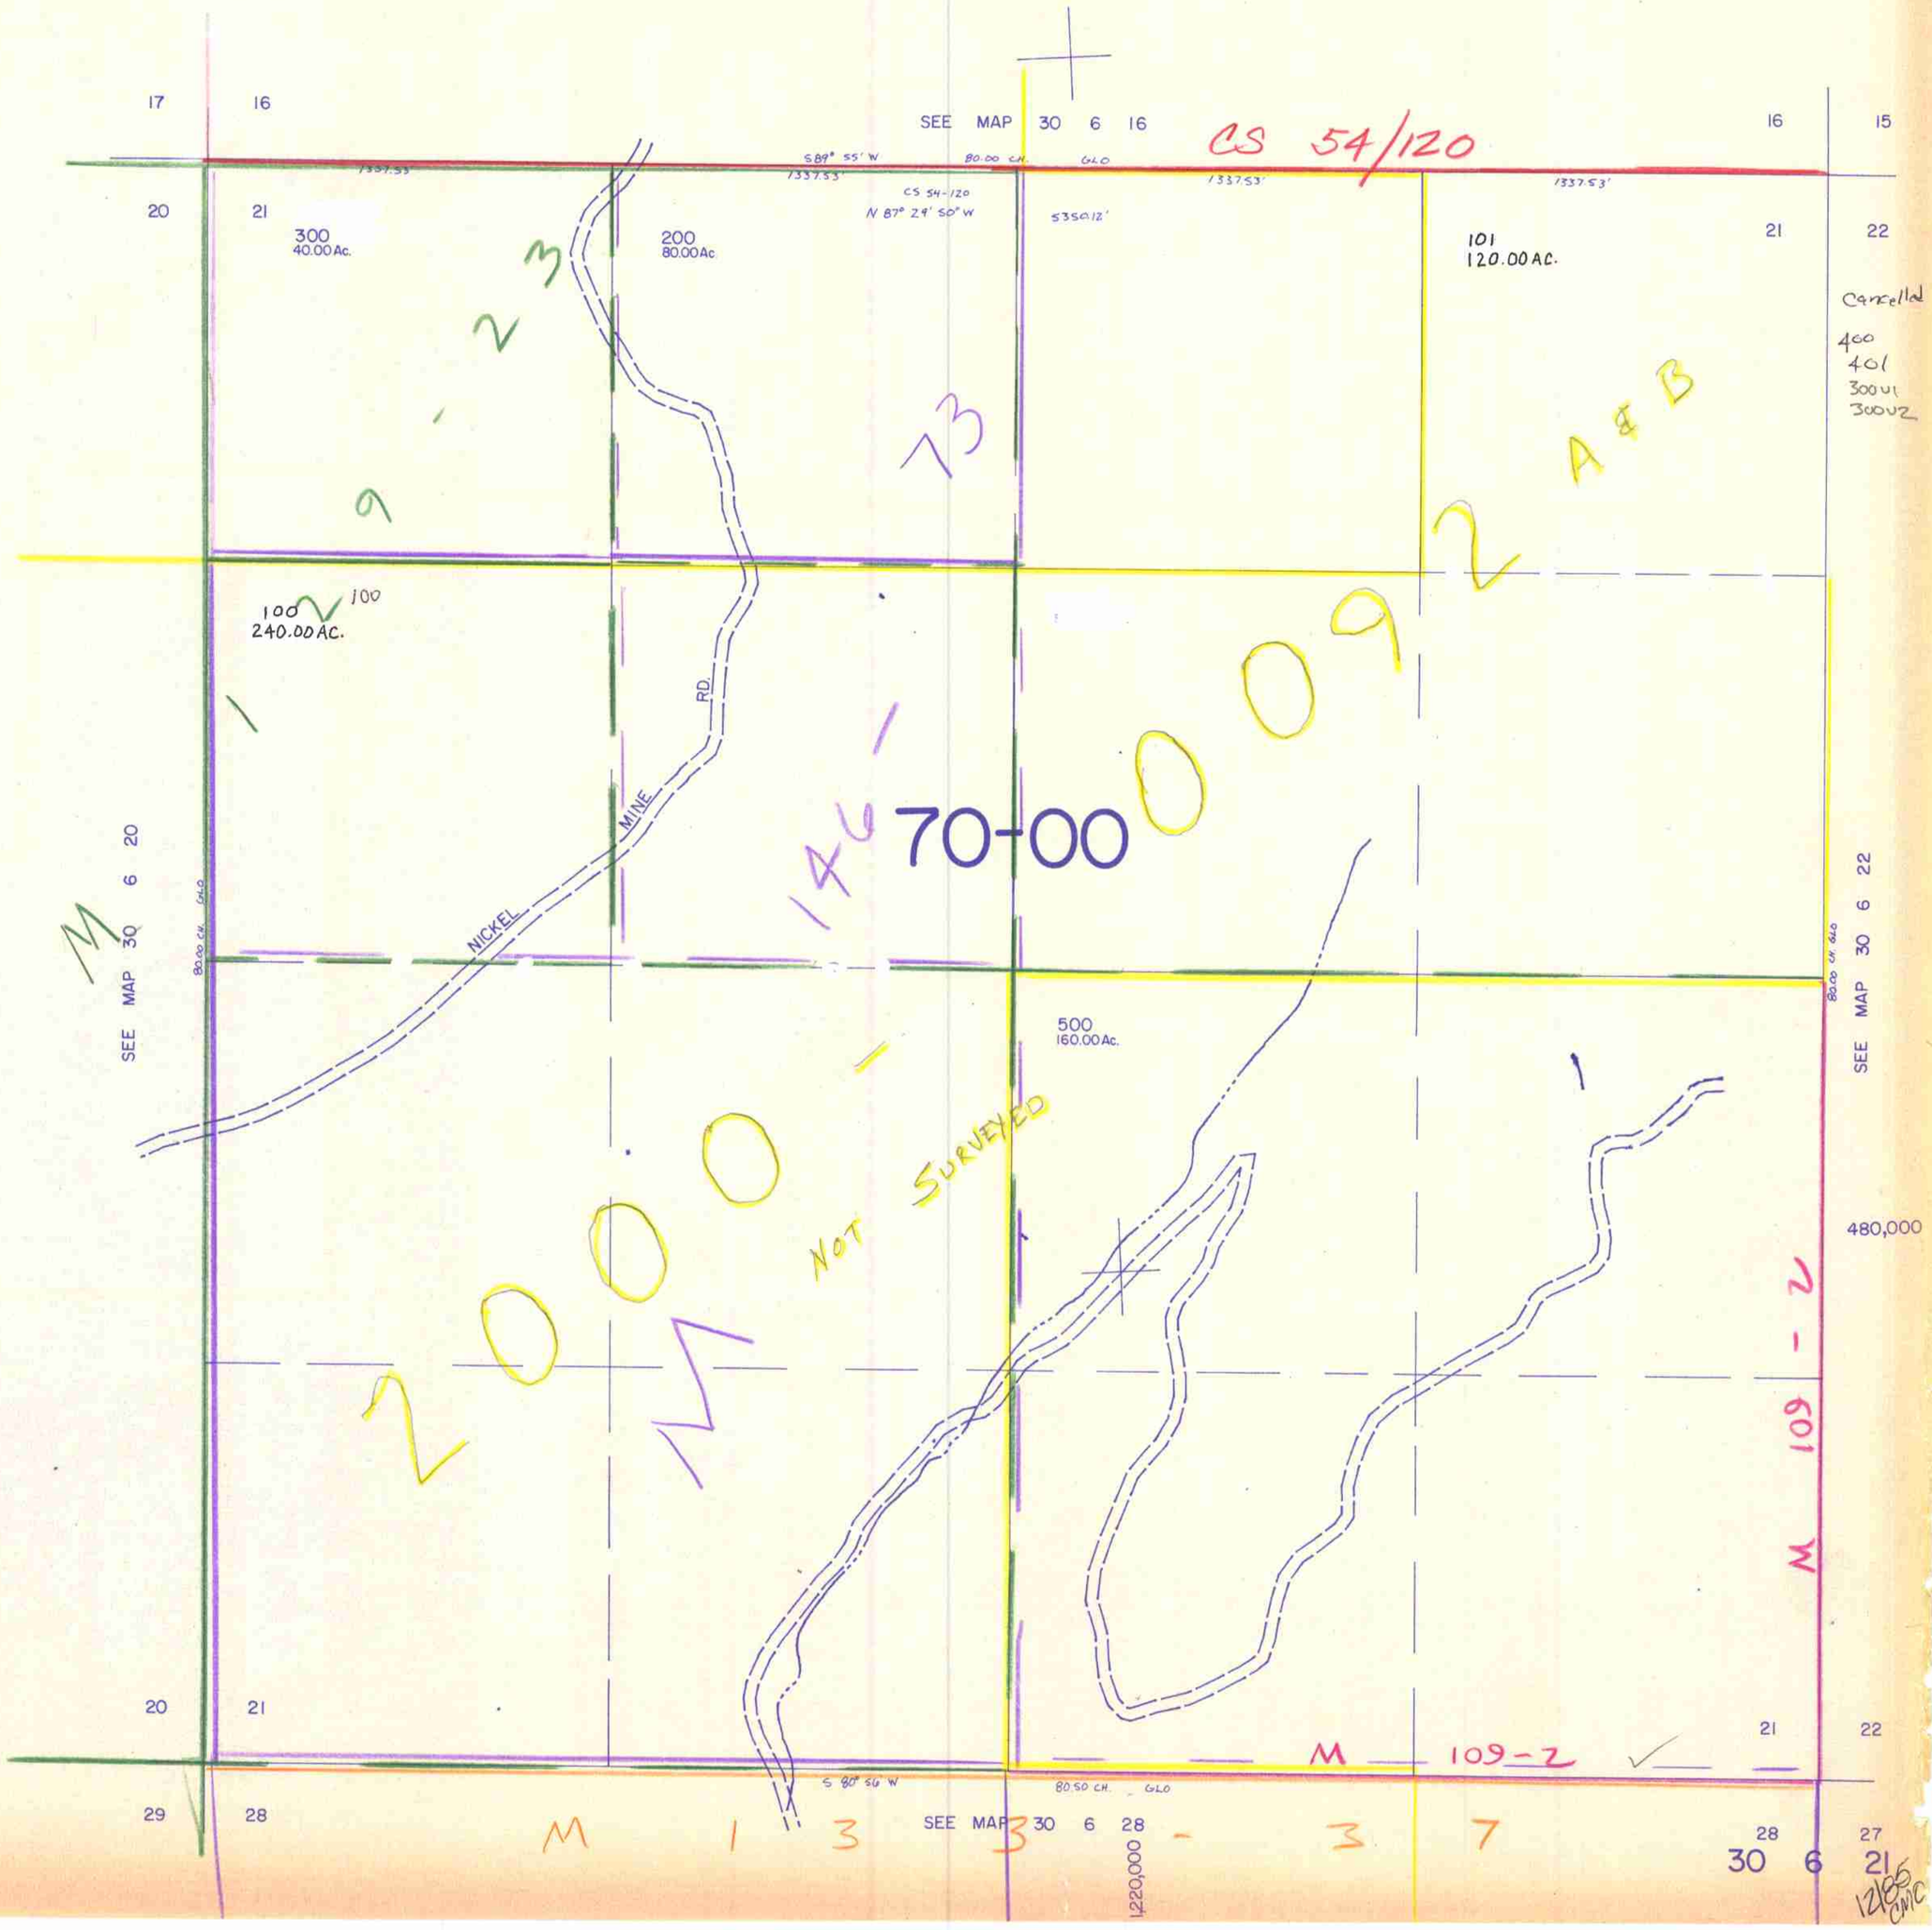
30 6 21