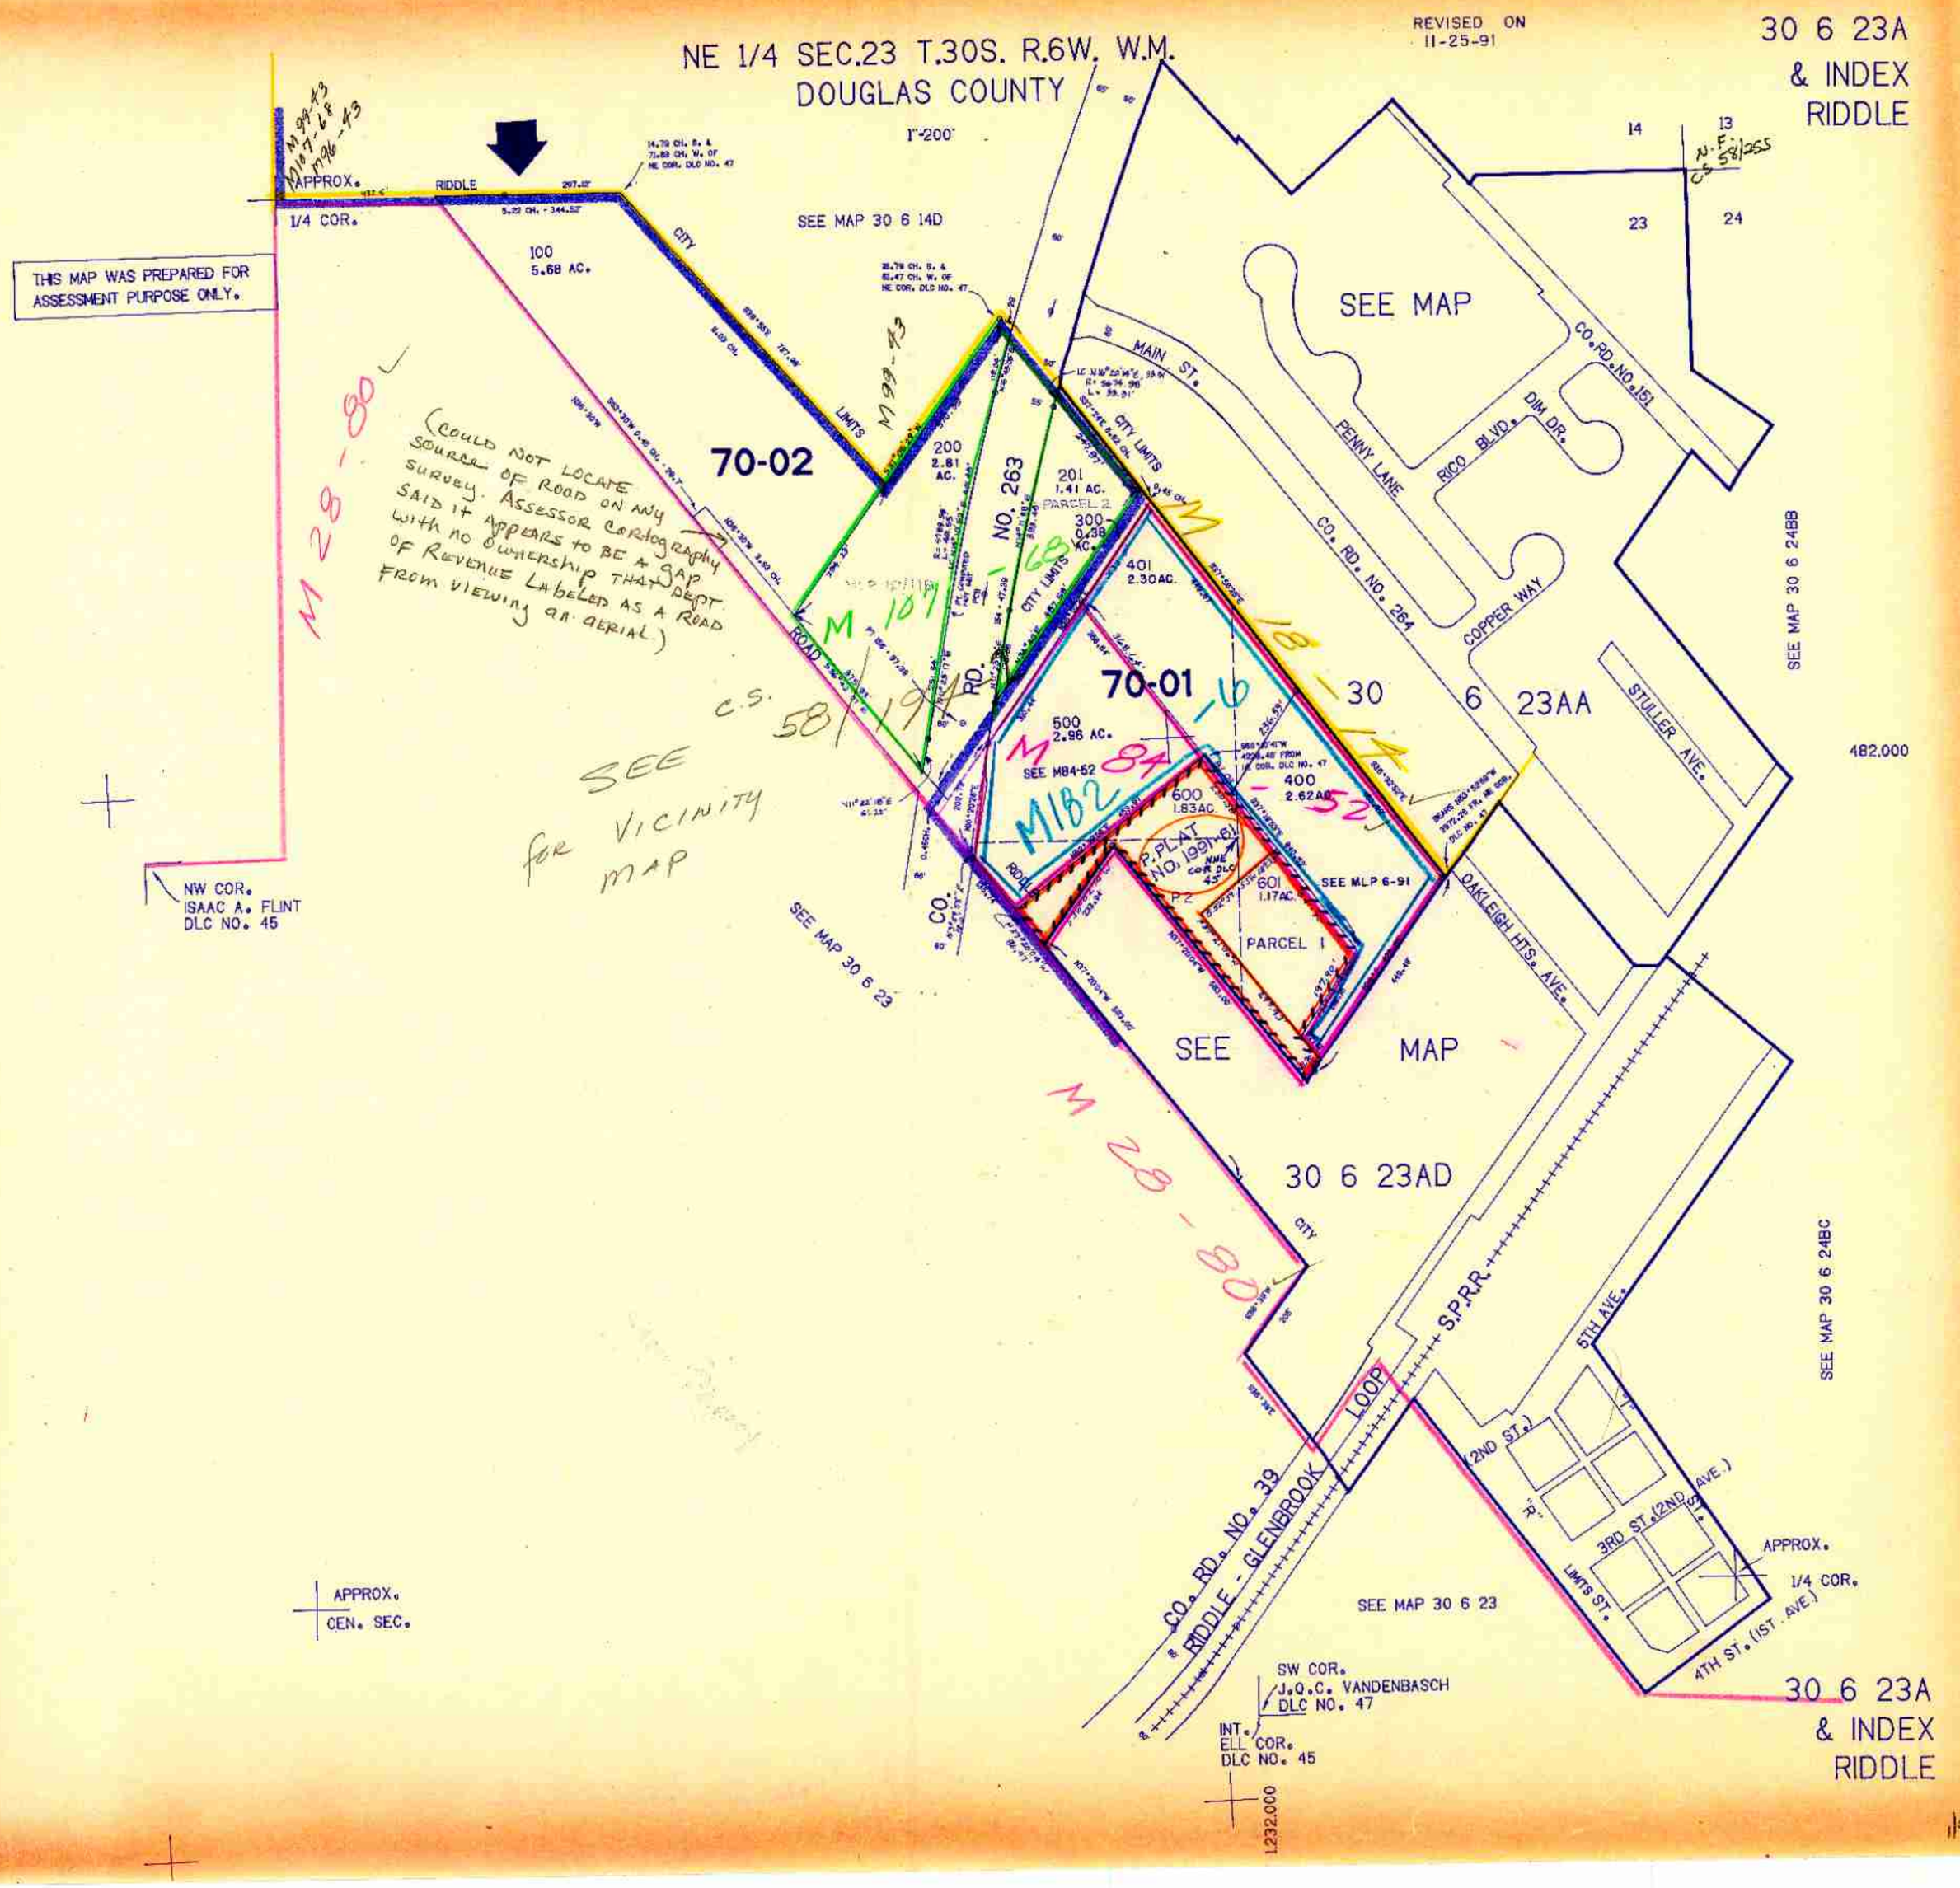

NE 1/4 SEC.23 T.30S. R.6W. W.M.
DOUGLAS COUNTY
REVISED ON 11-25-91
30 6 23A & INDEX RIDDLE
1"=200'
THIS MAP WAS PREPARED FOR ASSESSMENT PURPOSE ONLY.
APPROX. 1/4 COR.
RIDDLE
CITY LIMITS
SEE MAP 30 6 14D
100 5.68 AC.
70-02
200 2.81 AC.
201 1.41 AC.
PARCEL 2
300 0.38 AC.
401 2.30 AC.
70-01
500 2.96 AC.
SEE M84-52
600 1.83 AC.
400 2.62 AC.
601 1.17 AC.
SEE MLP 6-91
PARCEL 1
P.PLAT NO. 1991-61
NO. 263
RD.
CO.
ROAD
SEE MAP
MAIN ST.
PENNY LANE
RICO BLVD.
DIM DR.
CO. RD. NO. 151
CO. RD. NO. 264
COPPER WAY
STULLER AVE.
OAKLEIGH HTS. AVE.
30 6 23AA
SEE MAP 30 6 24BB
482,000
SEE MAP 30 6 23
SEE MAP
30 6 23AD
S.P.R.R.
LOOP
CO. RD. NO. 39
RIDDLE - GLENBROOK
5TH AVE.
(2ND ST.)
3RD ST. (2ND AVE.)
LIMITS ST.
4TH ST. (1ST AVE.)
APPROX. 1/4 COR.
SEE MAP 30 6 24BC
SEE MAP 30 6 23
SW COR. J.O.C. VANDENBASCH DLC NO. 47
INT. ELL COR. DLC NO. 45
1,232,000
NW COR. ISAAC A. FLINT DLC NO. 45
APPROX. CEN. SEC.
(COULD NOT LOCATE SOURCE OF ROAD ON ANY SURVEY. ASSESSOR CARTOGRAPHY SAID IT APPEARS TO BE A GAP WITH NO OWNERSHIP THAT DEPT. OF REVENUE LABELED AS A ROAD FROM VIEWING AN AERIAL)
SEE C.S. 58/191 for VICINITY MAP
M 28-80
M 107-68
M 18-14
M 84-52
M182
M 99-43
M107-68
M96-43
N.F. C.S. 58/255