


THIS MAP WAS PREPARED FOR ASSESSMENT PURPOSE ONLY.

NW1/4 SEC.24 T.30S. R.6W. W.M. DOUGLAS COUNTY

30 6 24B & INDEX RIDDLE

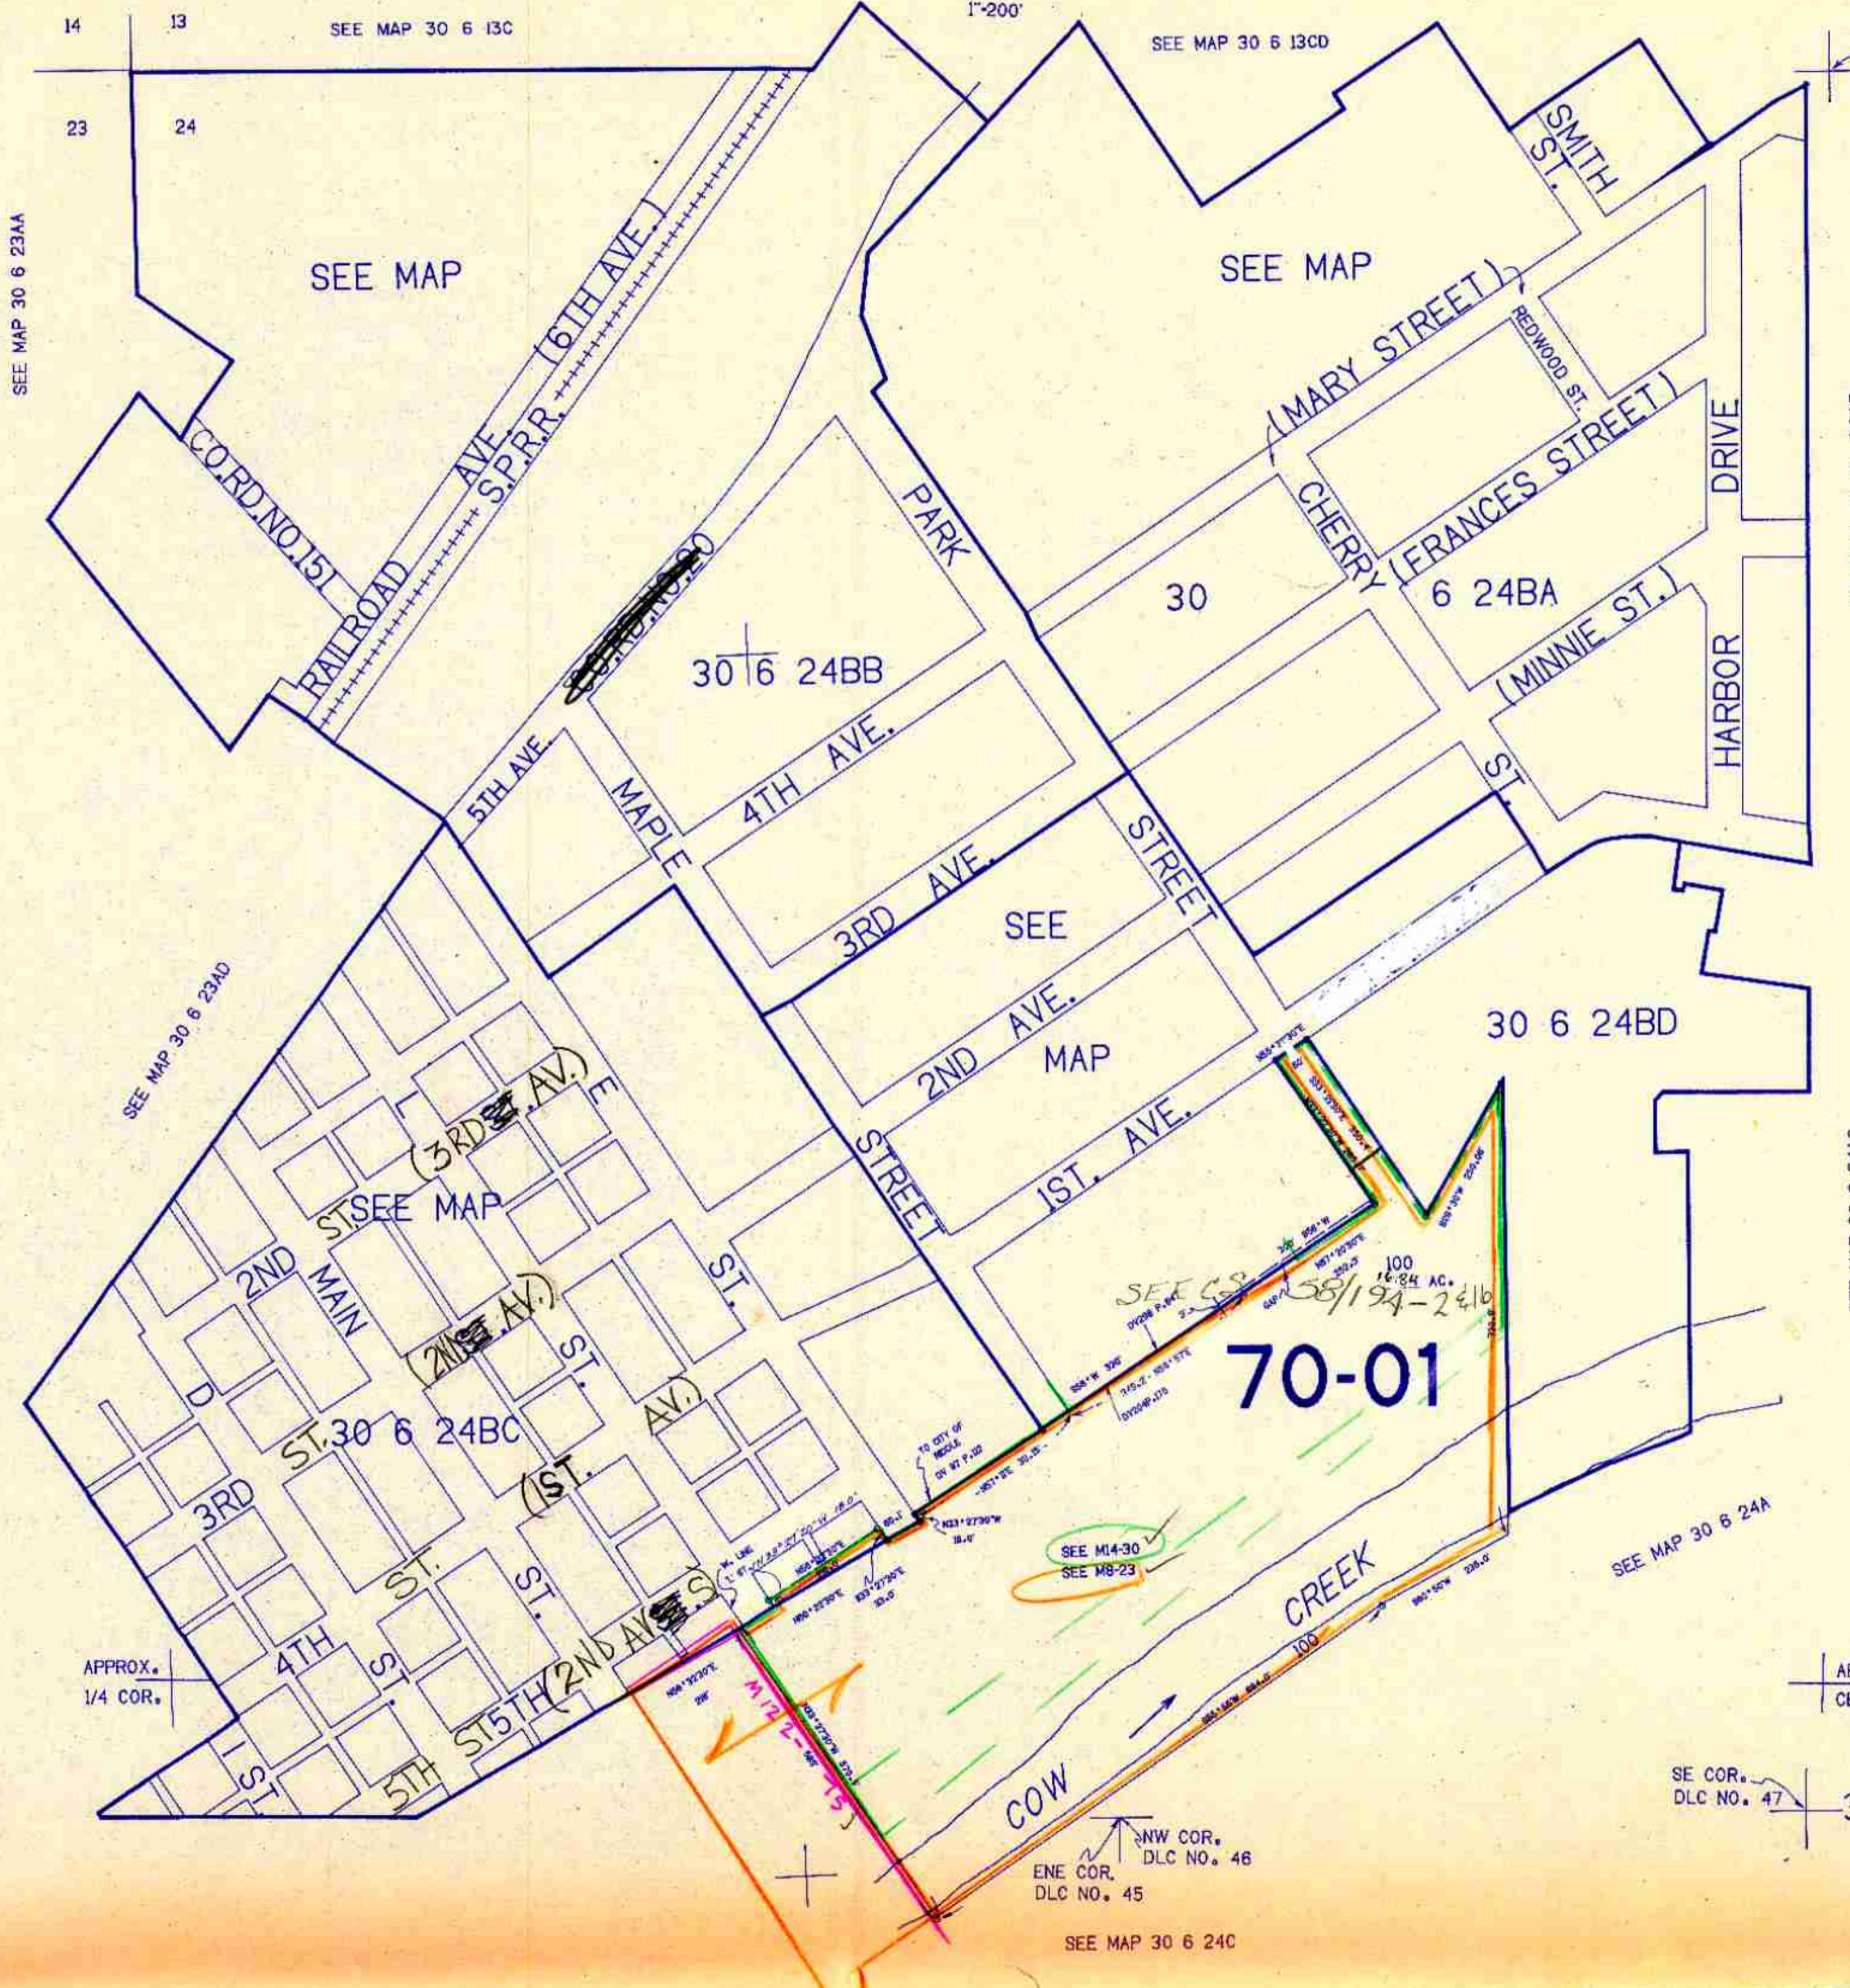

SEE MAP 30 6 23AA

SEE MAP 30 6 13C

SEE MAP 30 6 13CD

SEE MAP 30 6 23AD

SEE MAP

SEE MAP

SEE MAP 30 6 24AB

SEE MAP 30 6 24AC

SEE MAP 30 6 24A

SEE MAP 30 6 24C

CONTROL LAYOUT TRACED CHECKED

APPROX. 1/4 COR.

APPROX. CEN. SEC.

SE COR. DLC NO. 47

NW COR. DLC NO. 46
ENE COR. DLC NO. 45

30 6 24B & INDEX RIDDLE

6/197 J.B.