

SE 1/4 SEC. 24 T.30S. R. 6 W. W.M.
DOUGLAS COUNTY


30 6 24D

THIS MAP WAS PREPARED FOR
ASSESSMENT PURPOSE ONLY.

1"=200'

APPROX.
CEN. SEC.

SE COR.
DLC NO. 47

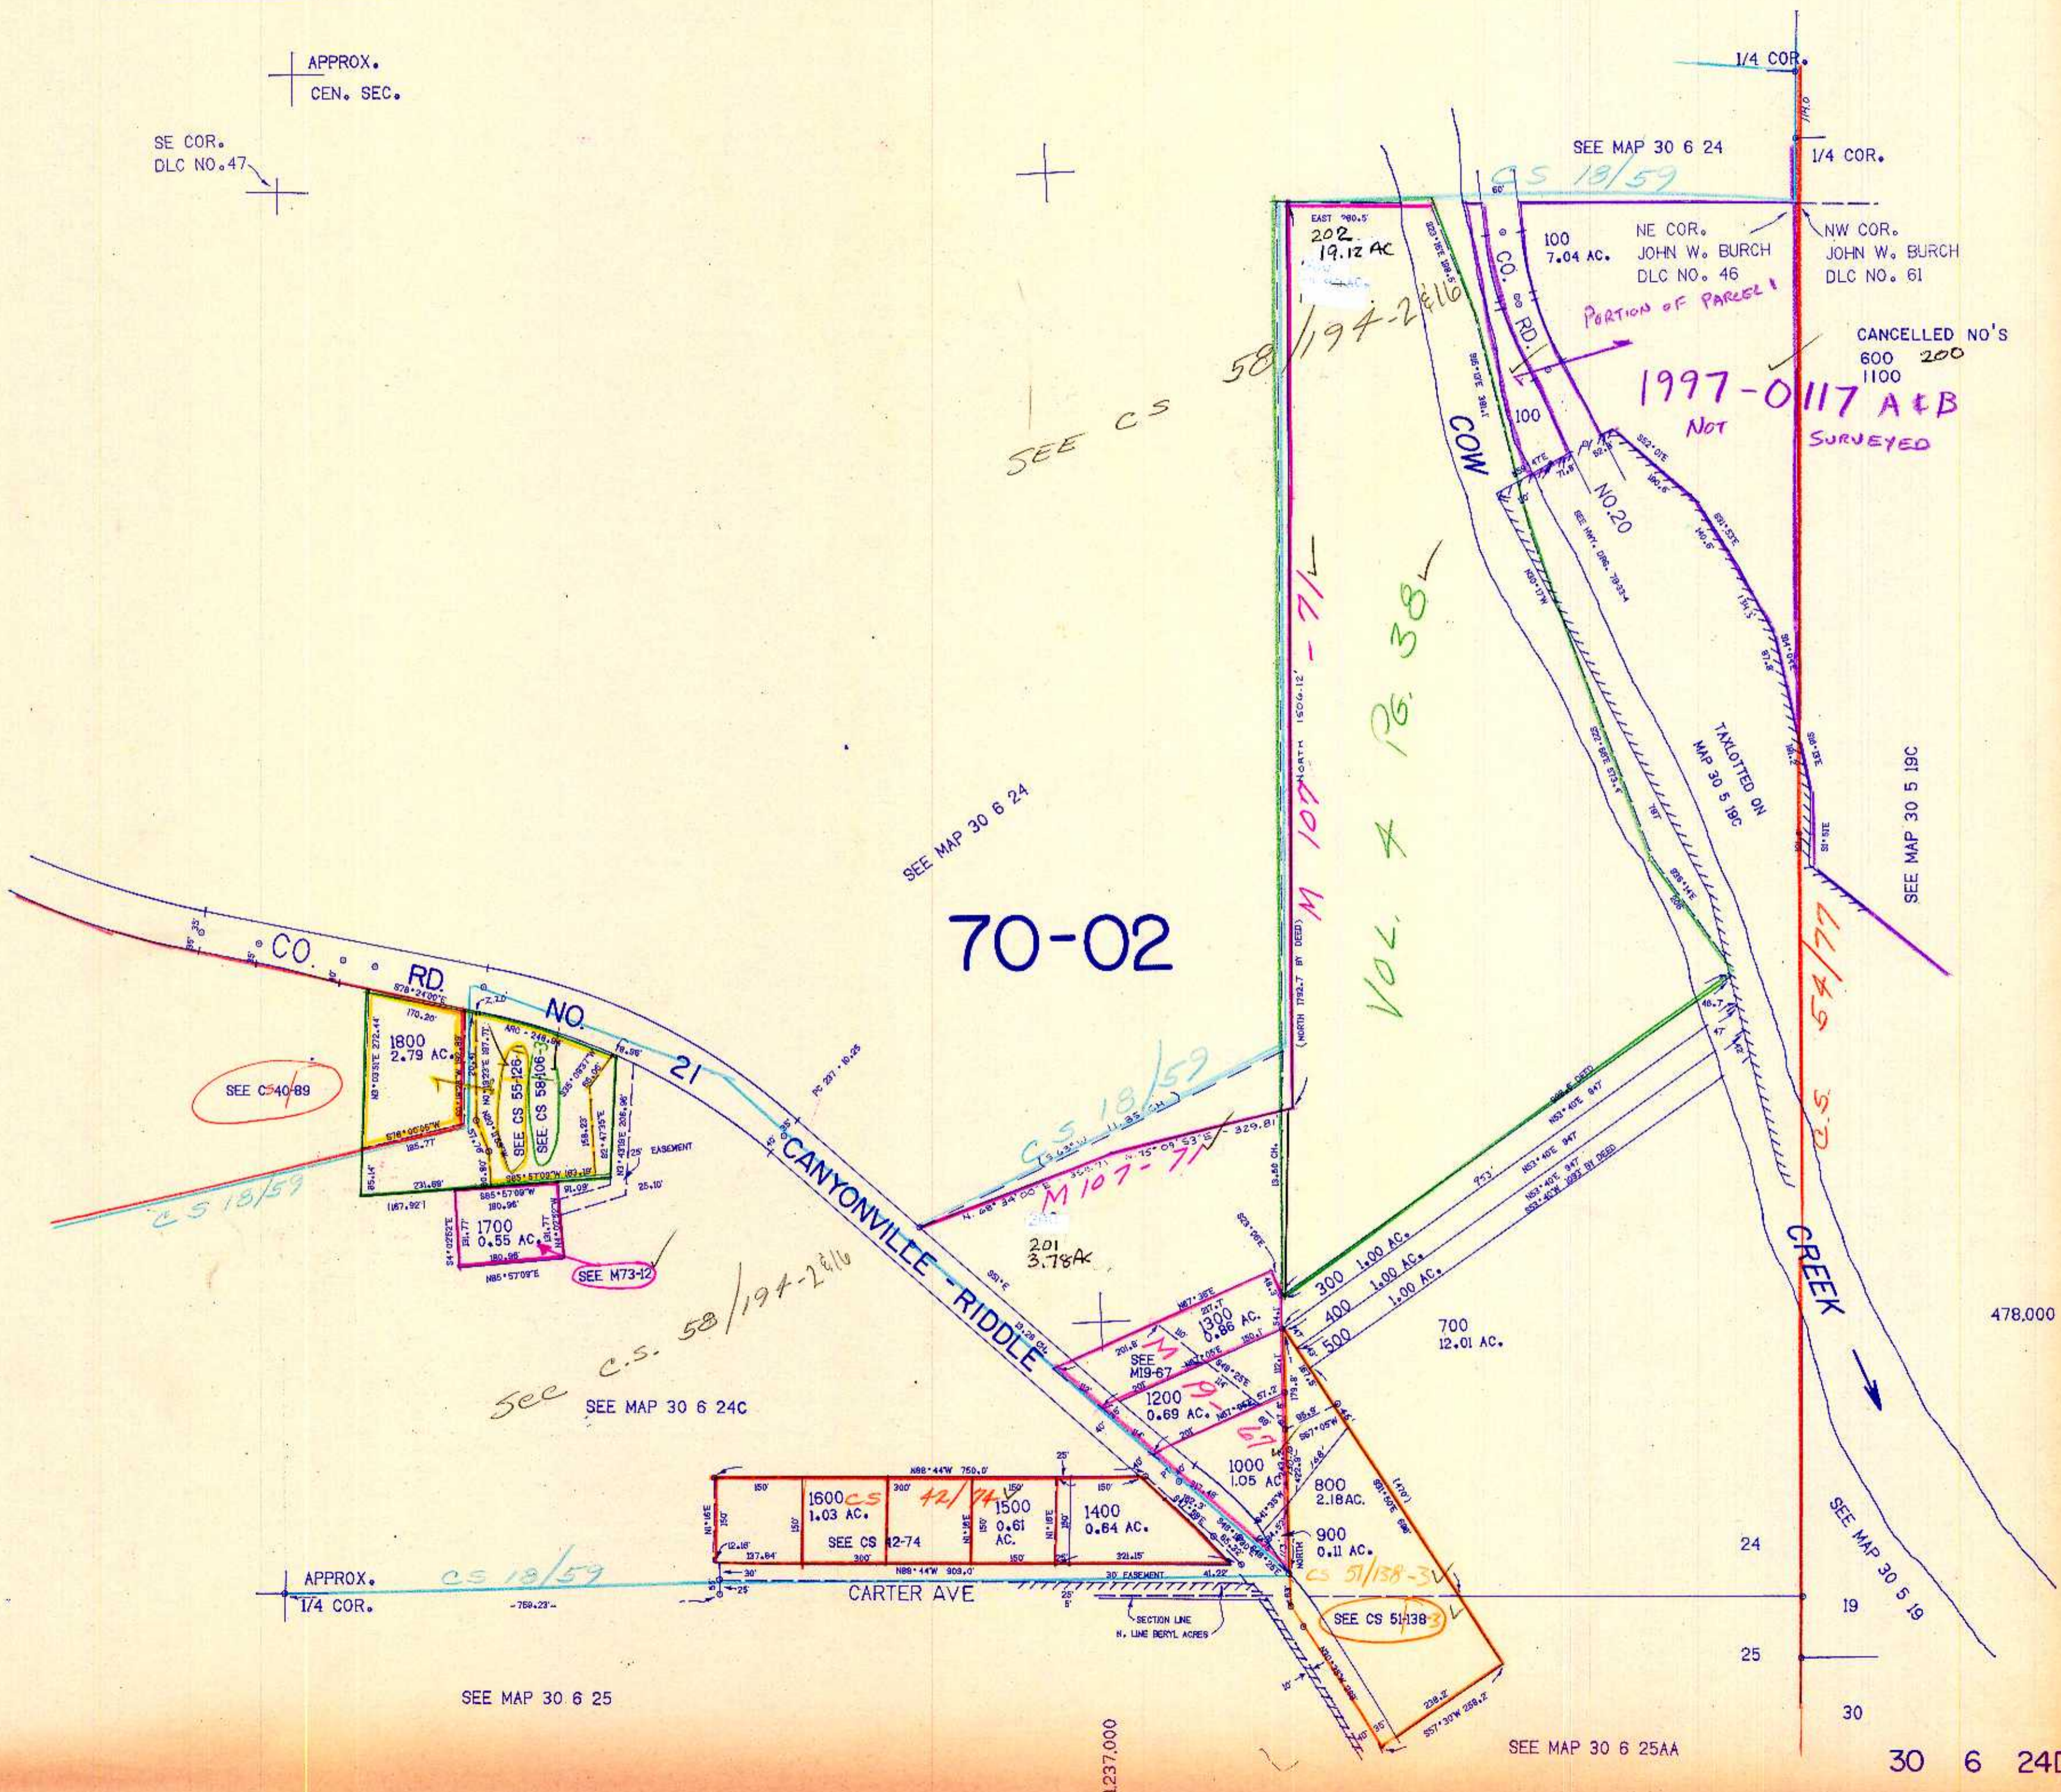

70-02

SEE CS 40-89

SEE CS 58/194-2816
SEE MAP 30 6 24C

CS 18/59

SEE MAP 30 6 25

SEE CS 58/194-2816

Vol. 4 Pg. 38

1997-0117 A+B
NOT SURVEYED


30 6 24D

