


This map was prepared for
assessment purpose only

SECTION 26 T.30S. R.6W. W.M.
DOUGLAS COUNTY

1" = 400'

30 6 26
& INDEX

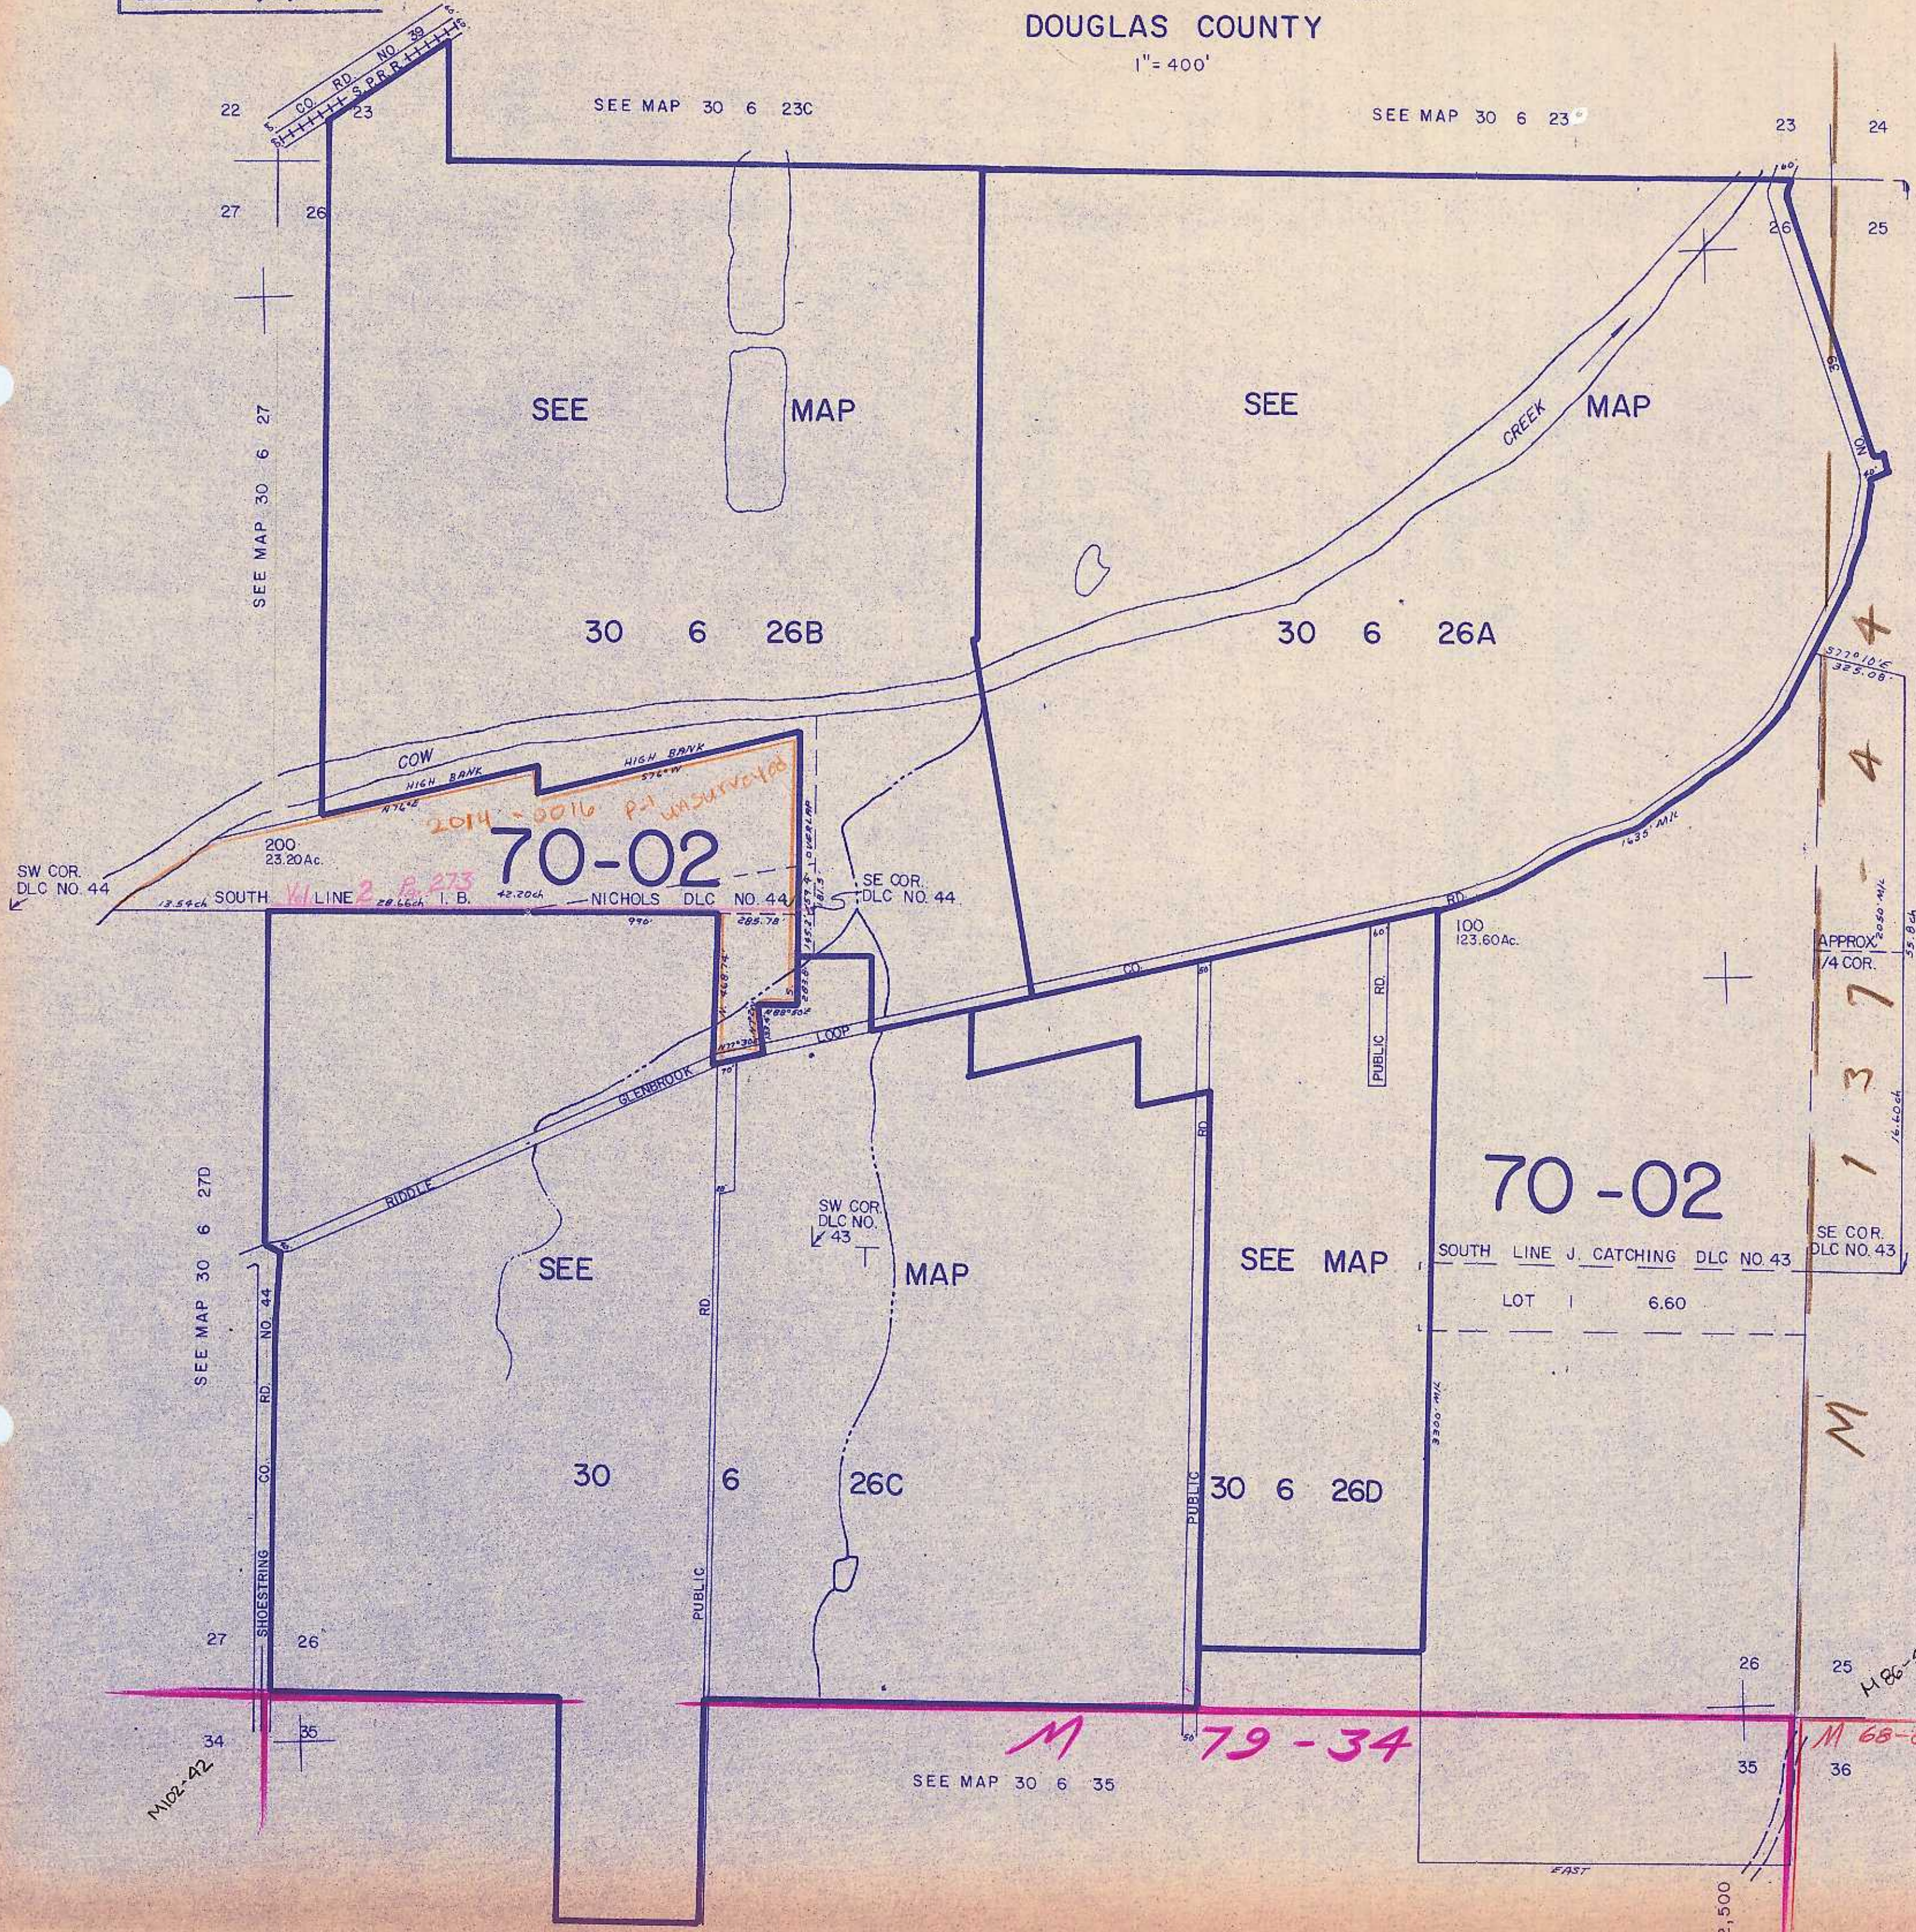

477,500

SEE MAP 30 6 25B

SEE MAP 30 6 25

30 6 26
& INDEX

12/83
68