


SECTION 1 T.30S. R.7W. W.M.  
DOUGLAS COUNTY

30 7 1

THIS MAP WAS PREPARED FOR  
ASSESSMENT PURPOSE ONLY.

1"=400'

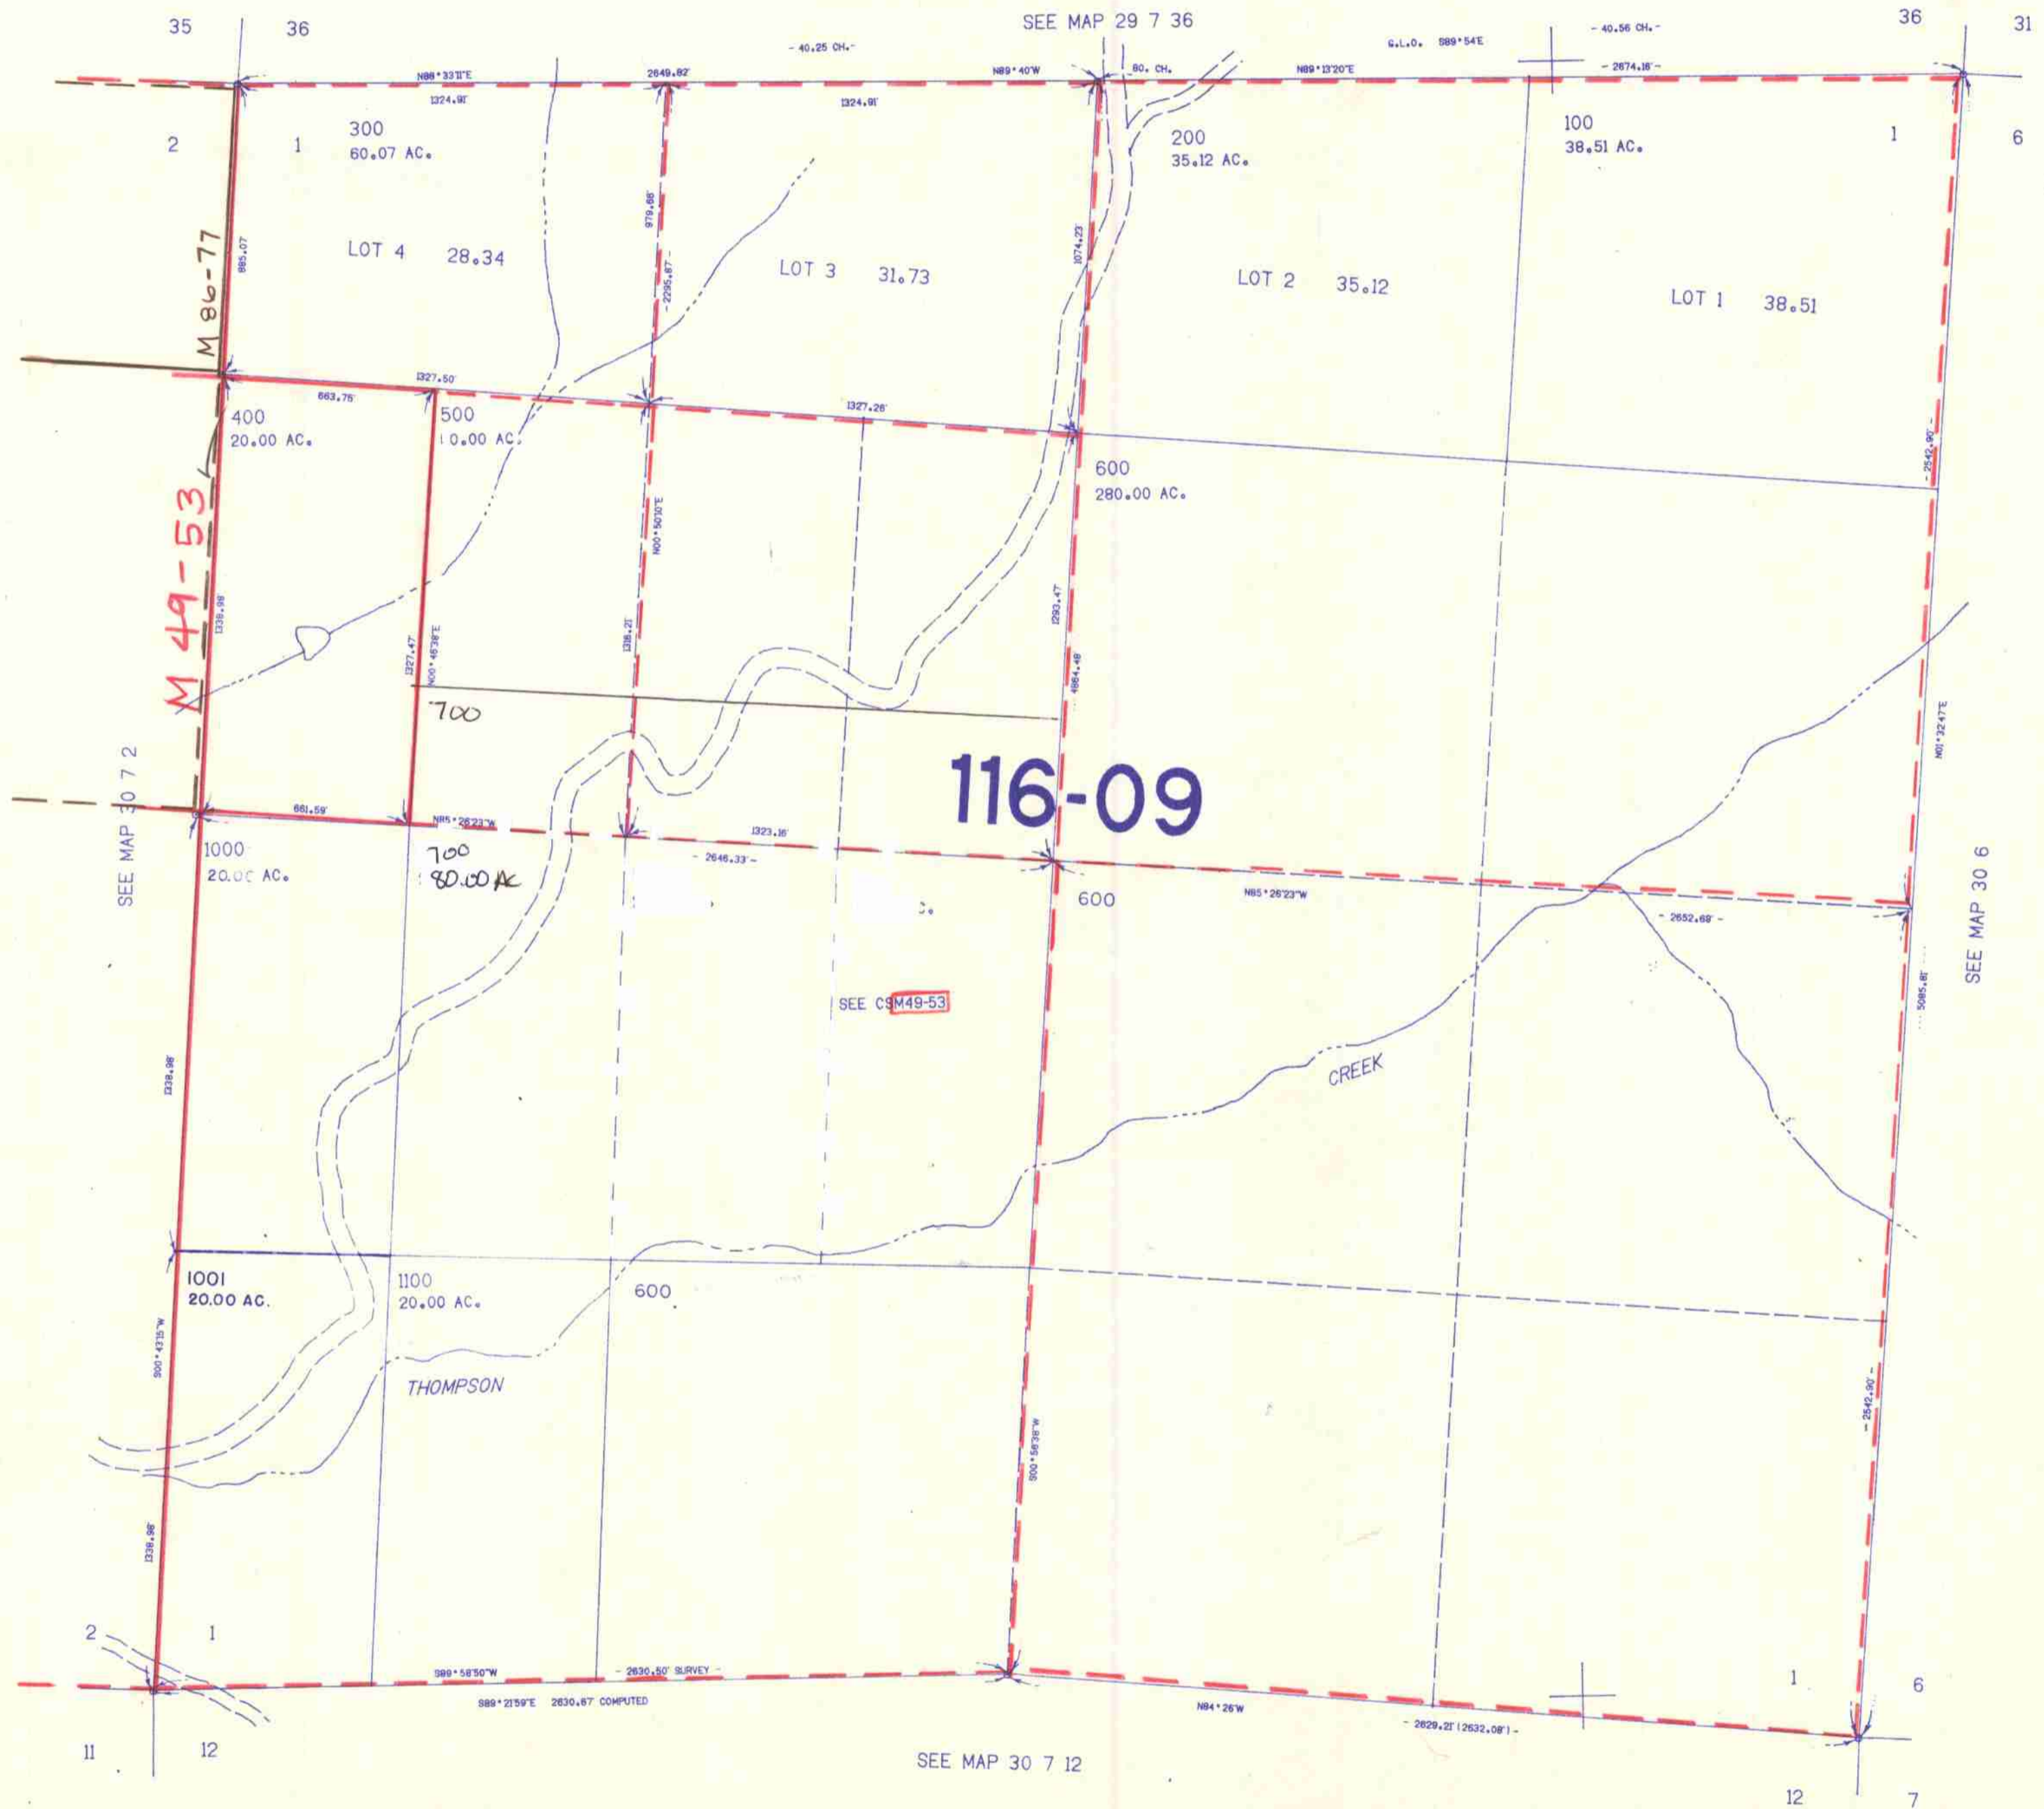

Cancelled  
501  
800  
900

SEE MAP 30 6

116-09

SEE CSM 49-53

M 49-53

M 86-77

495.000

SEE MAP 30 7 12

30 7 1

6/95  
SM

1.206.000