


SECTION 26 T.30S. R.7W. W.M.  
DOUGLAS COUNTY

30 7 26

THIS MAP WAS PREPARED FOR  
ASSESSMENT PURPOSE ONLY.

1"=400'

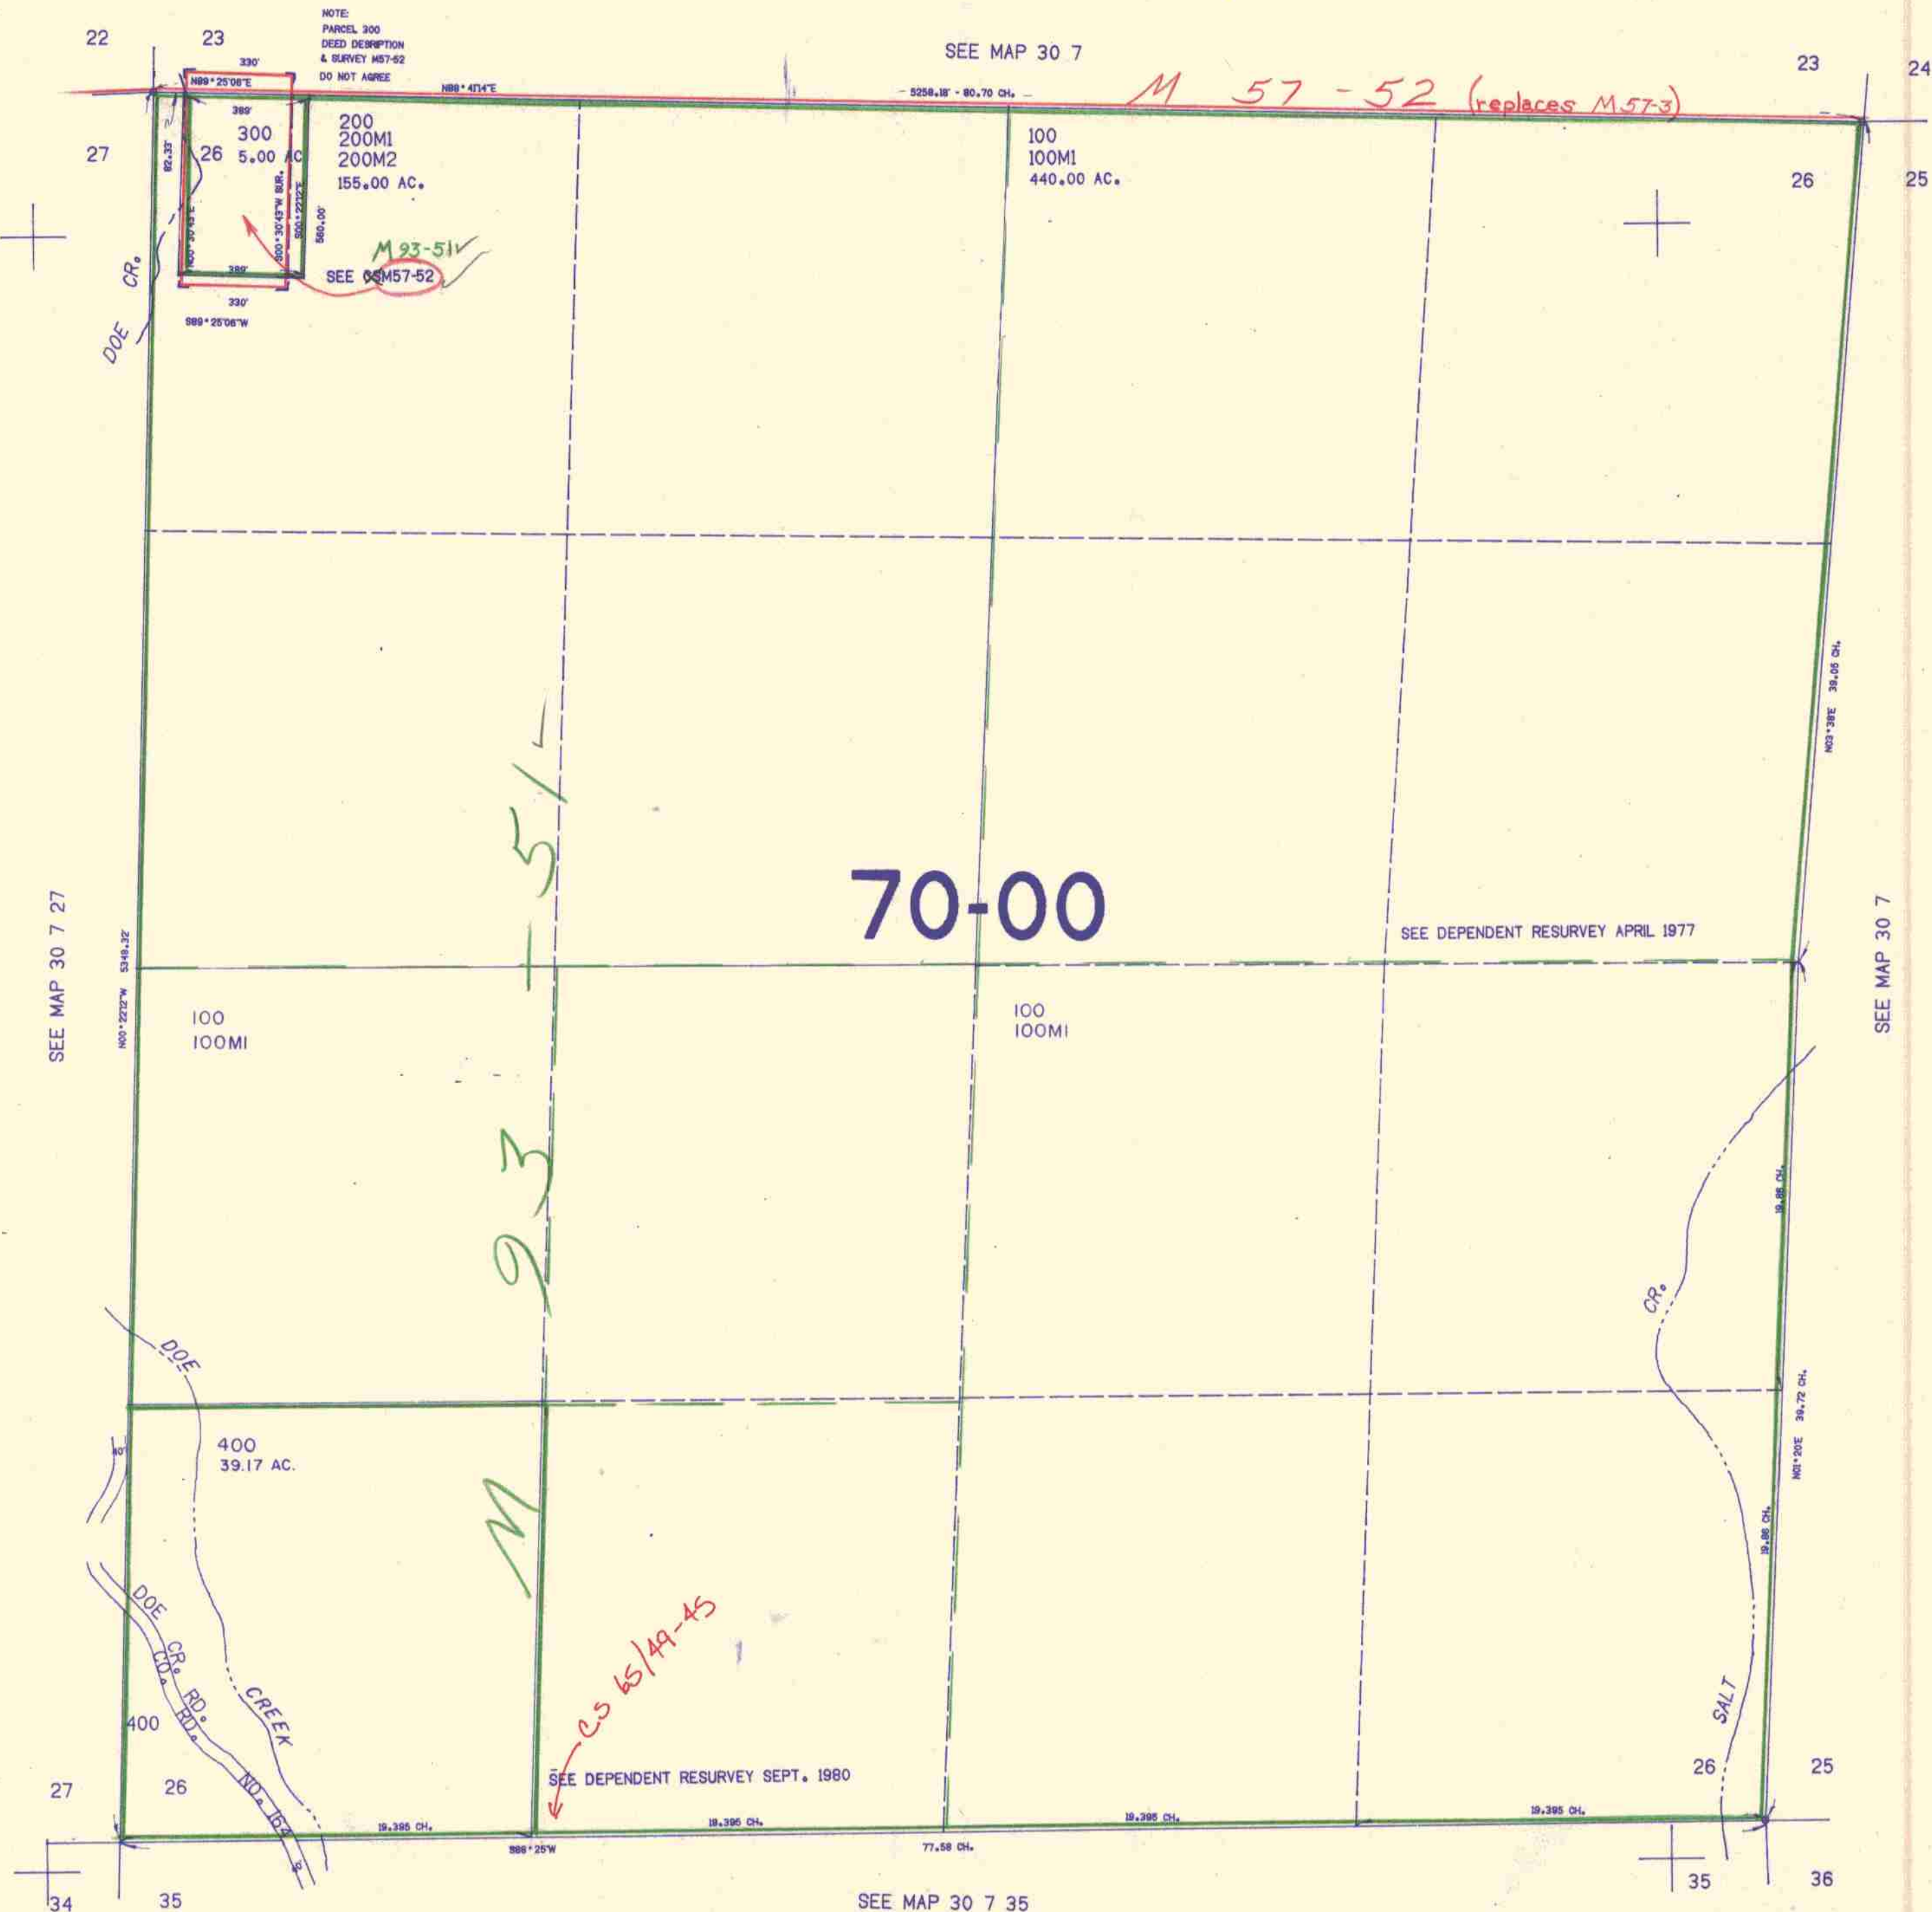

474.000

SEE MAP 30 7 35

1,200,000

30 7 26  
7/84  
B8