


SECTION 36 T.30S. R.7W. W.M.  
DOUGLAS COUNTY

30 7 36

THIS MAP WAS PREPARED FOR  
ASSESSMENT PURPOSE ONLY.

1"=400'

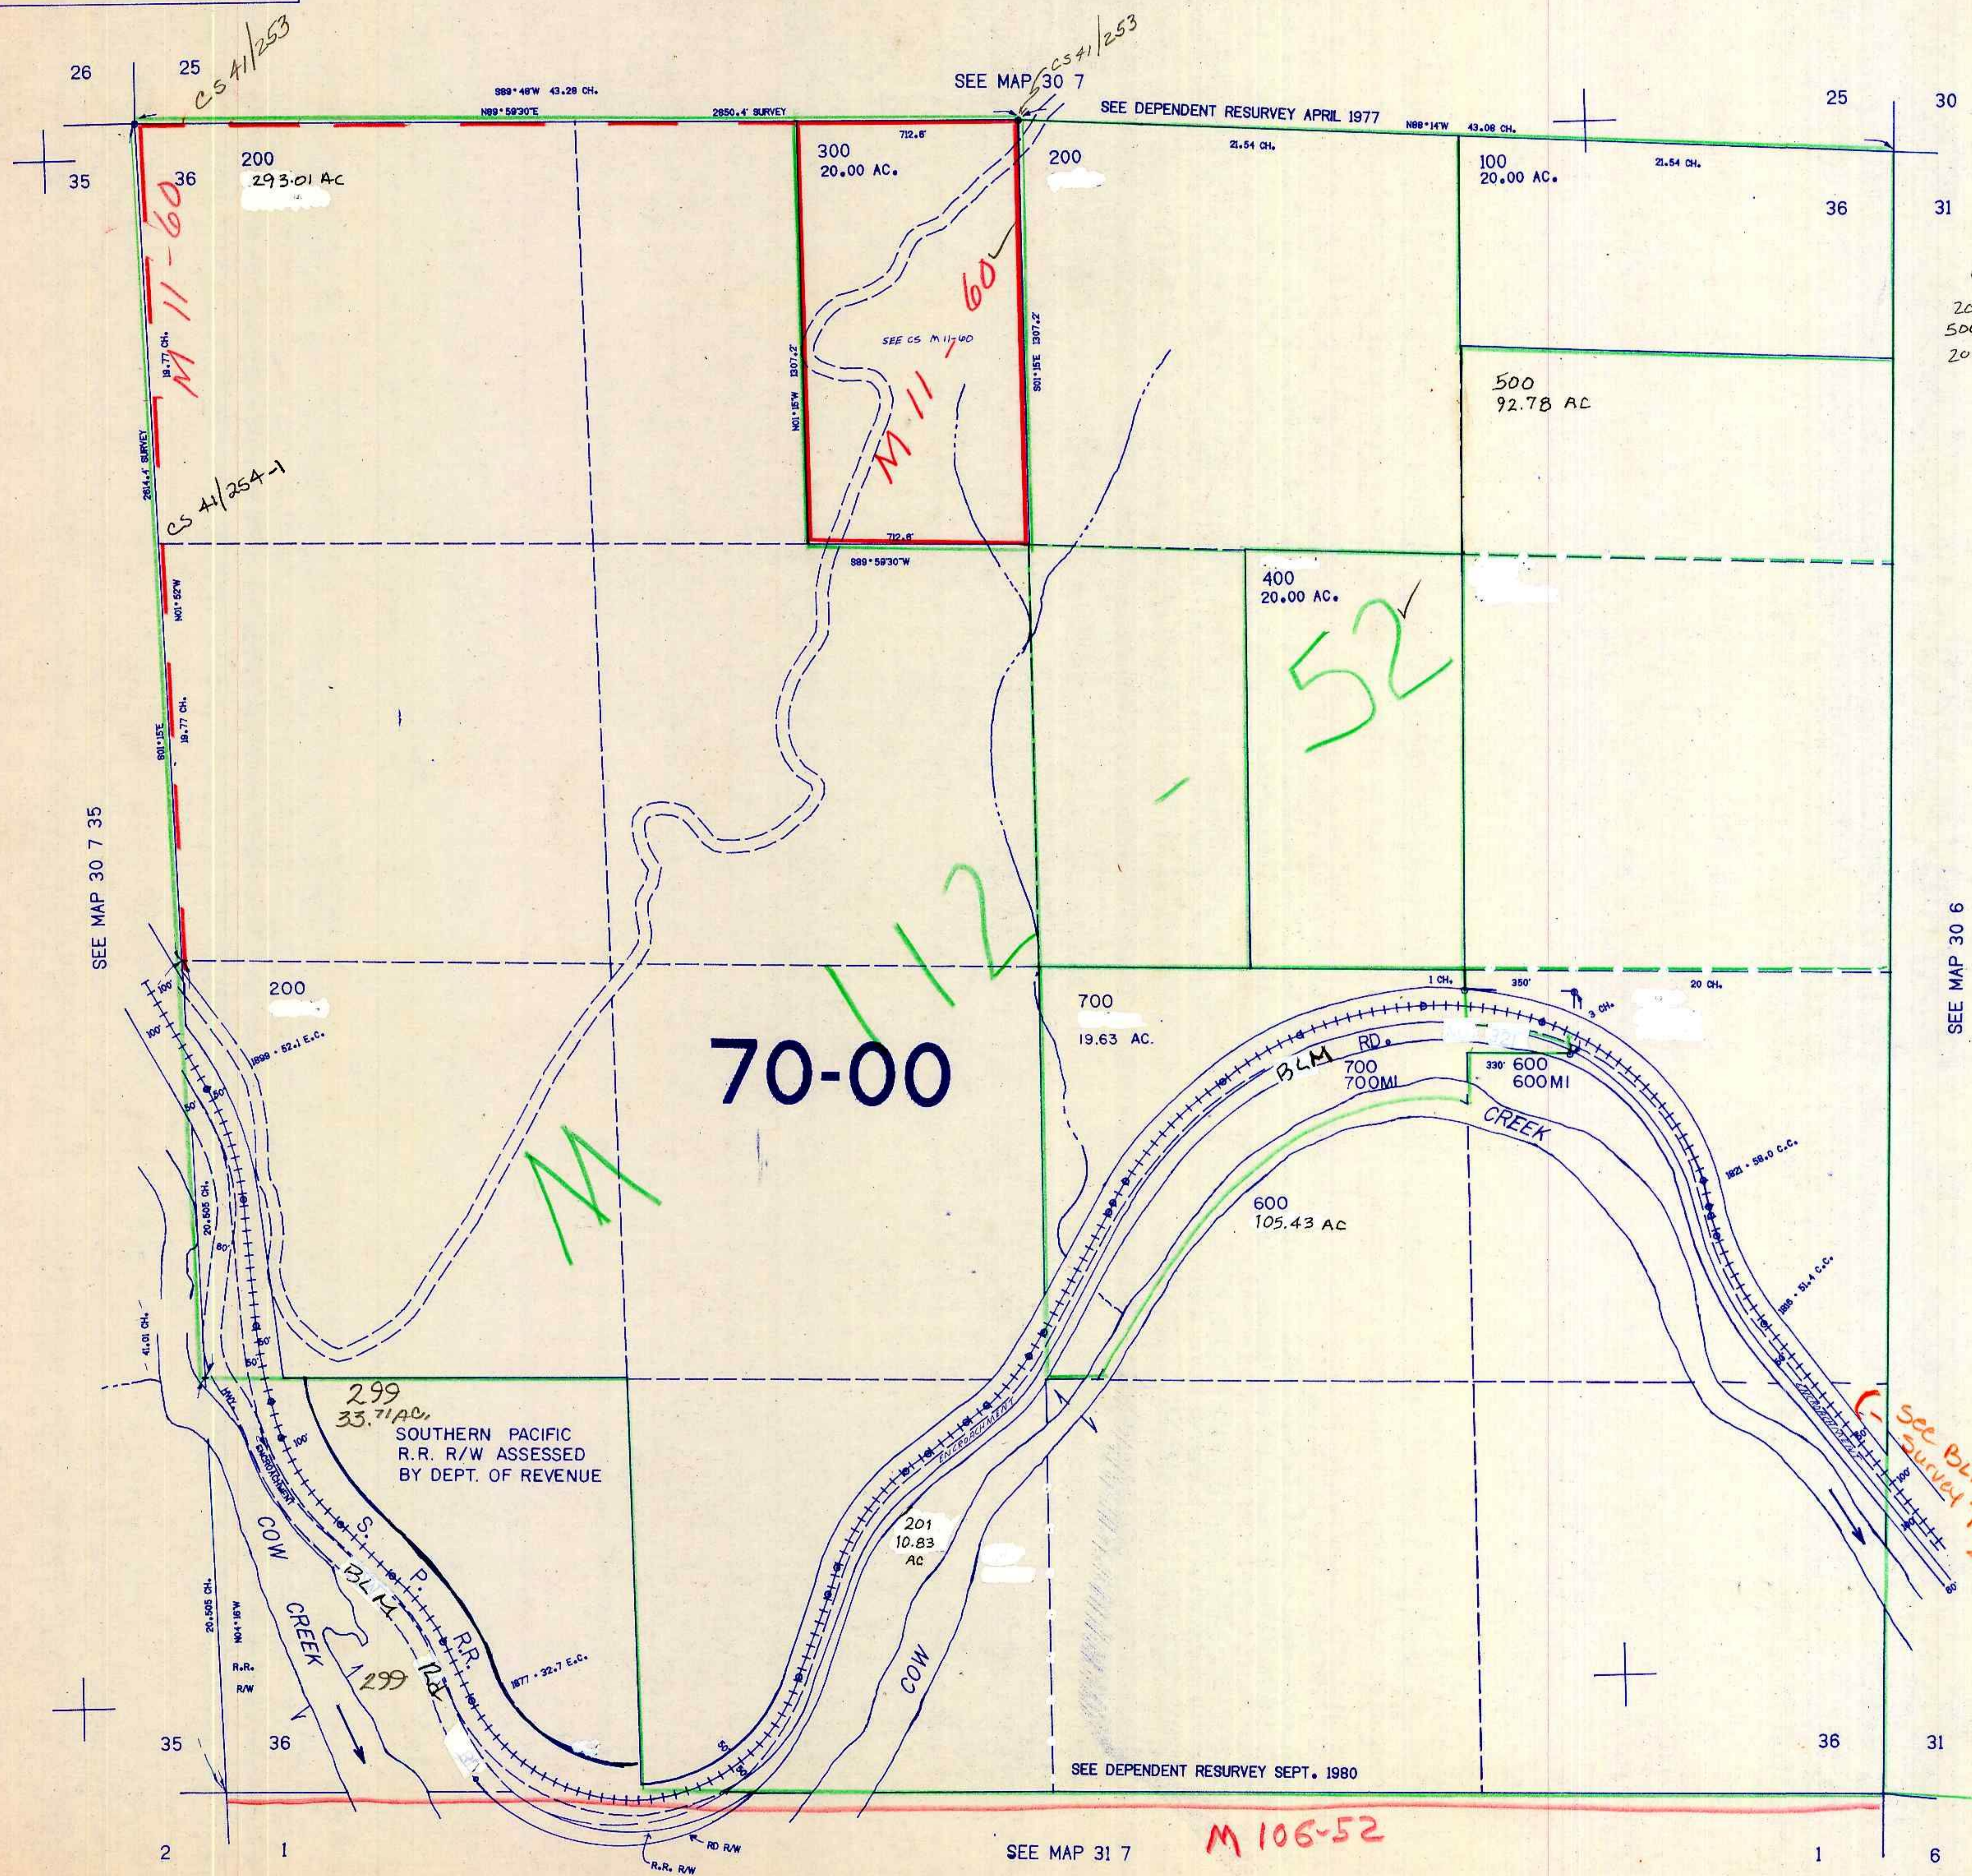

CANCELLED  
200mi 299mi 400mi  
500mi 600mi 700mi  
202 203 601 602

See BLM Plat  
Survey T30-7  
2020-1

469,000

30 7 36

1:205,000

3/199