


SEE MAP 30 1 00 1" = 2000'

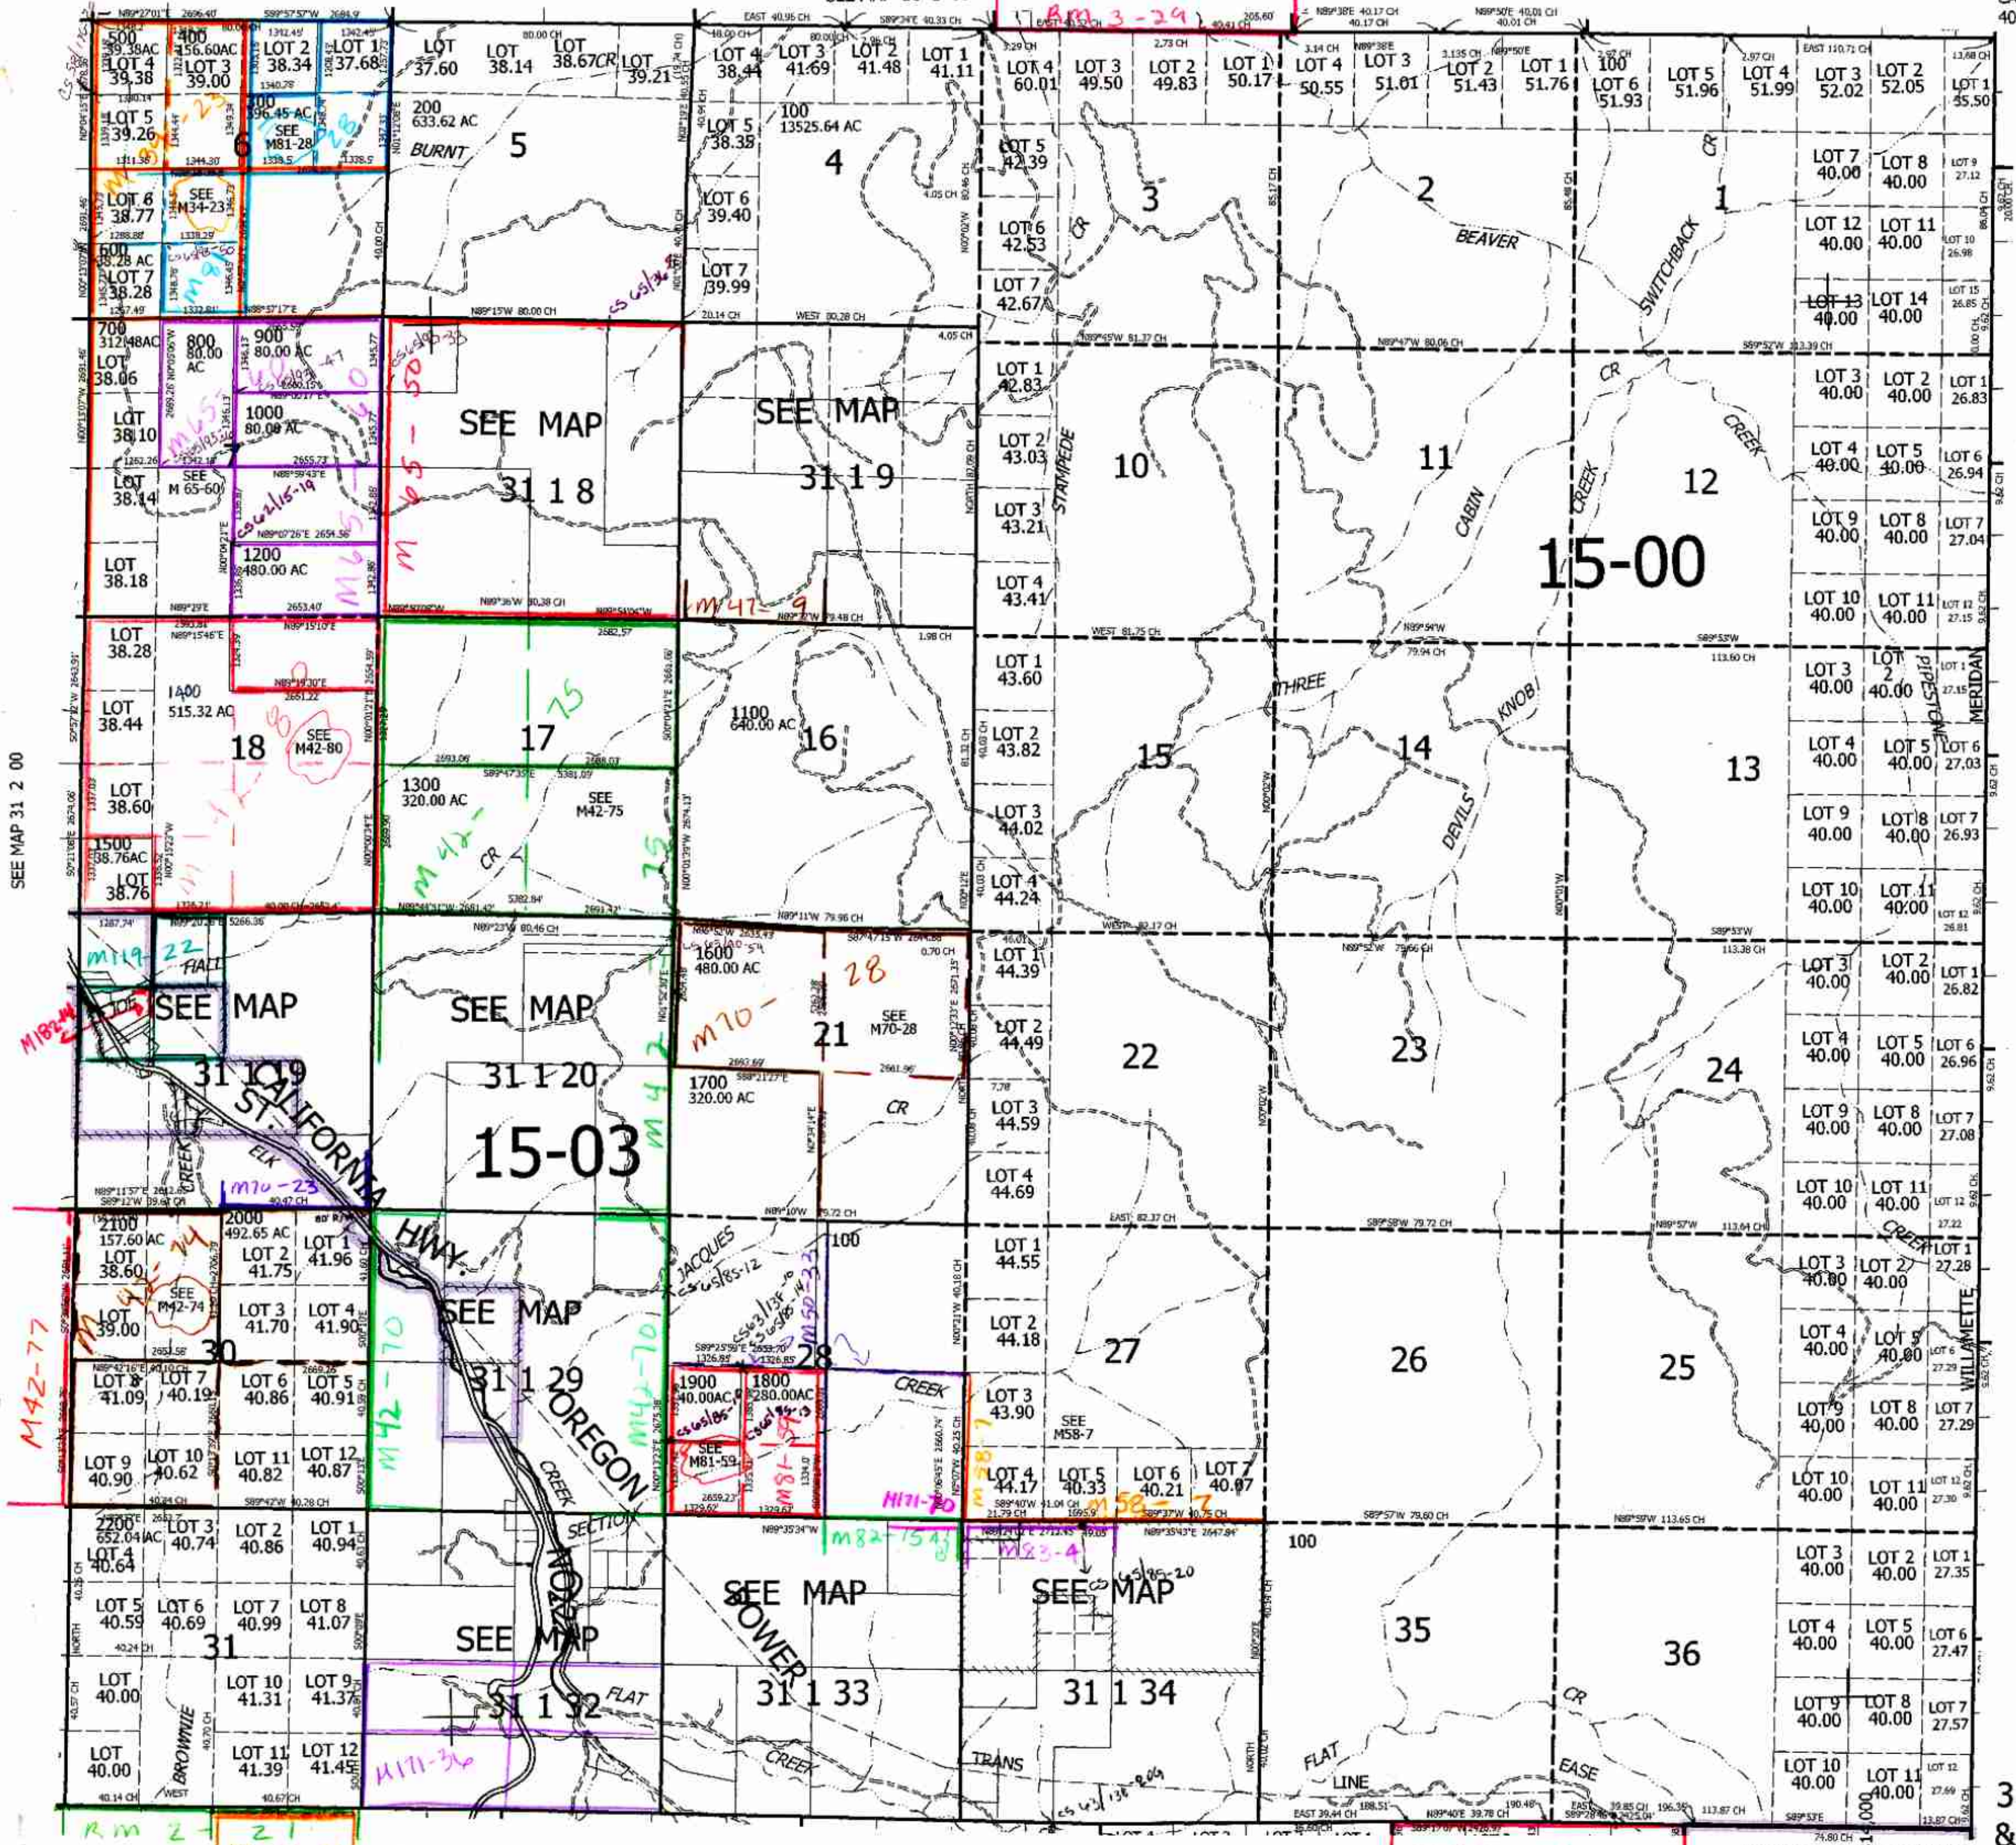

SEE MAP 31 2 00

SEE MAP 31 1E 00

SEE MAP 32 1 00

JACKSON COUNTY

434,000