SECTION 20 T.31 S. R. 1 W. W.M.
DOUGLAS COUNTY
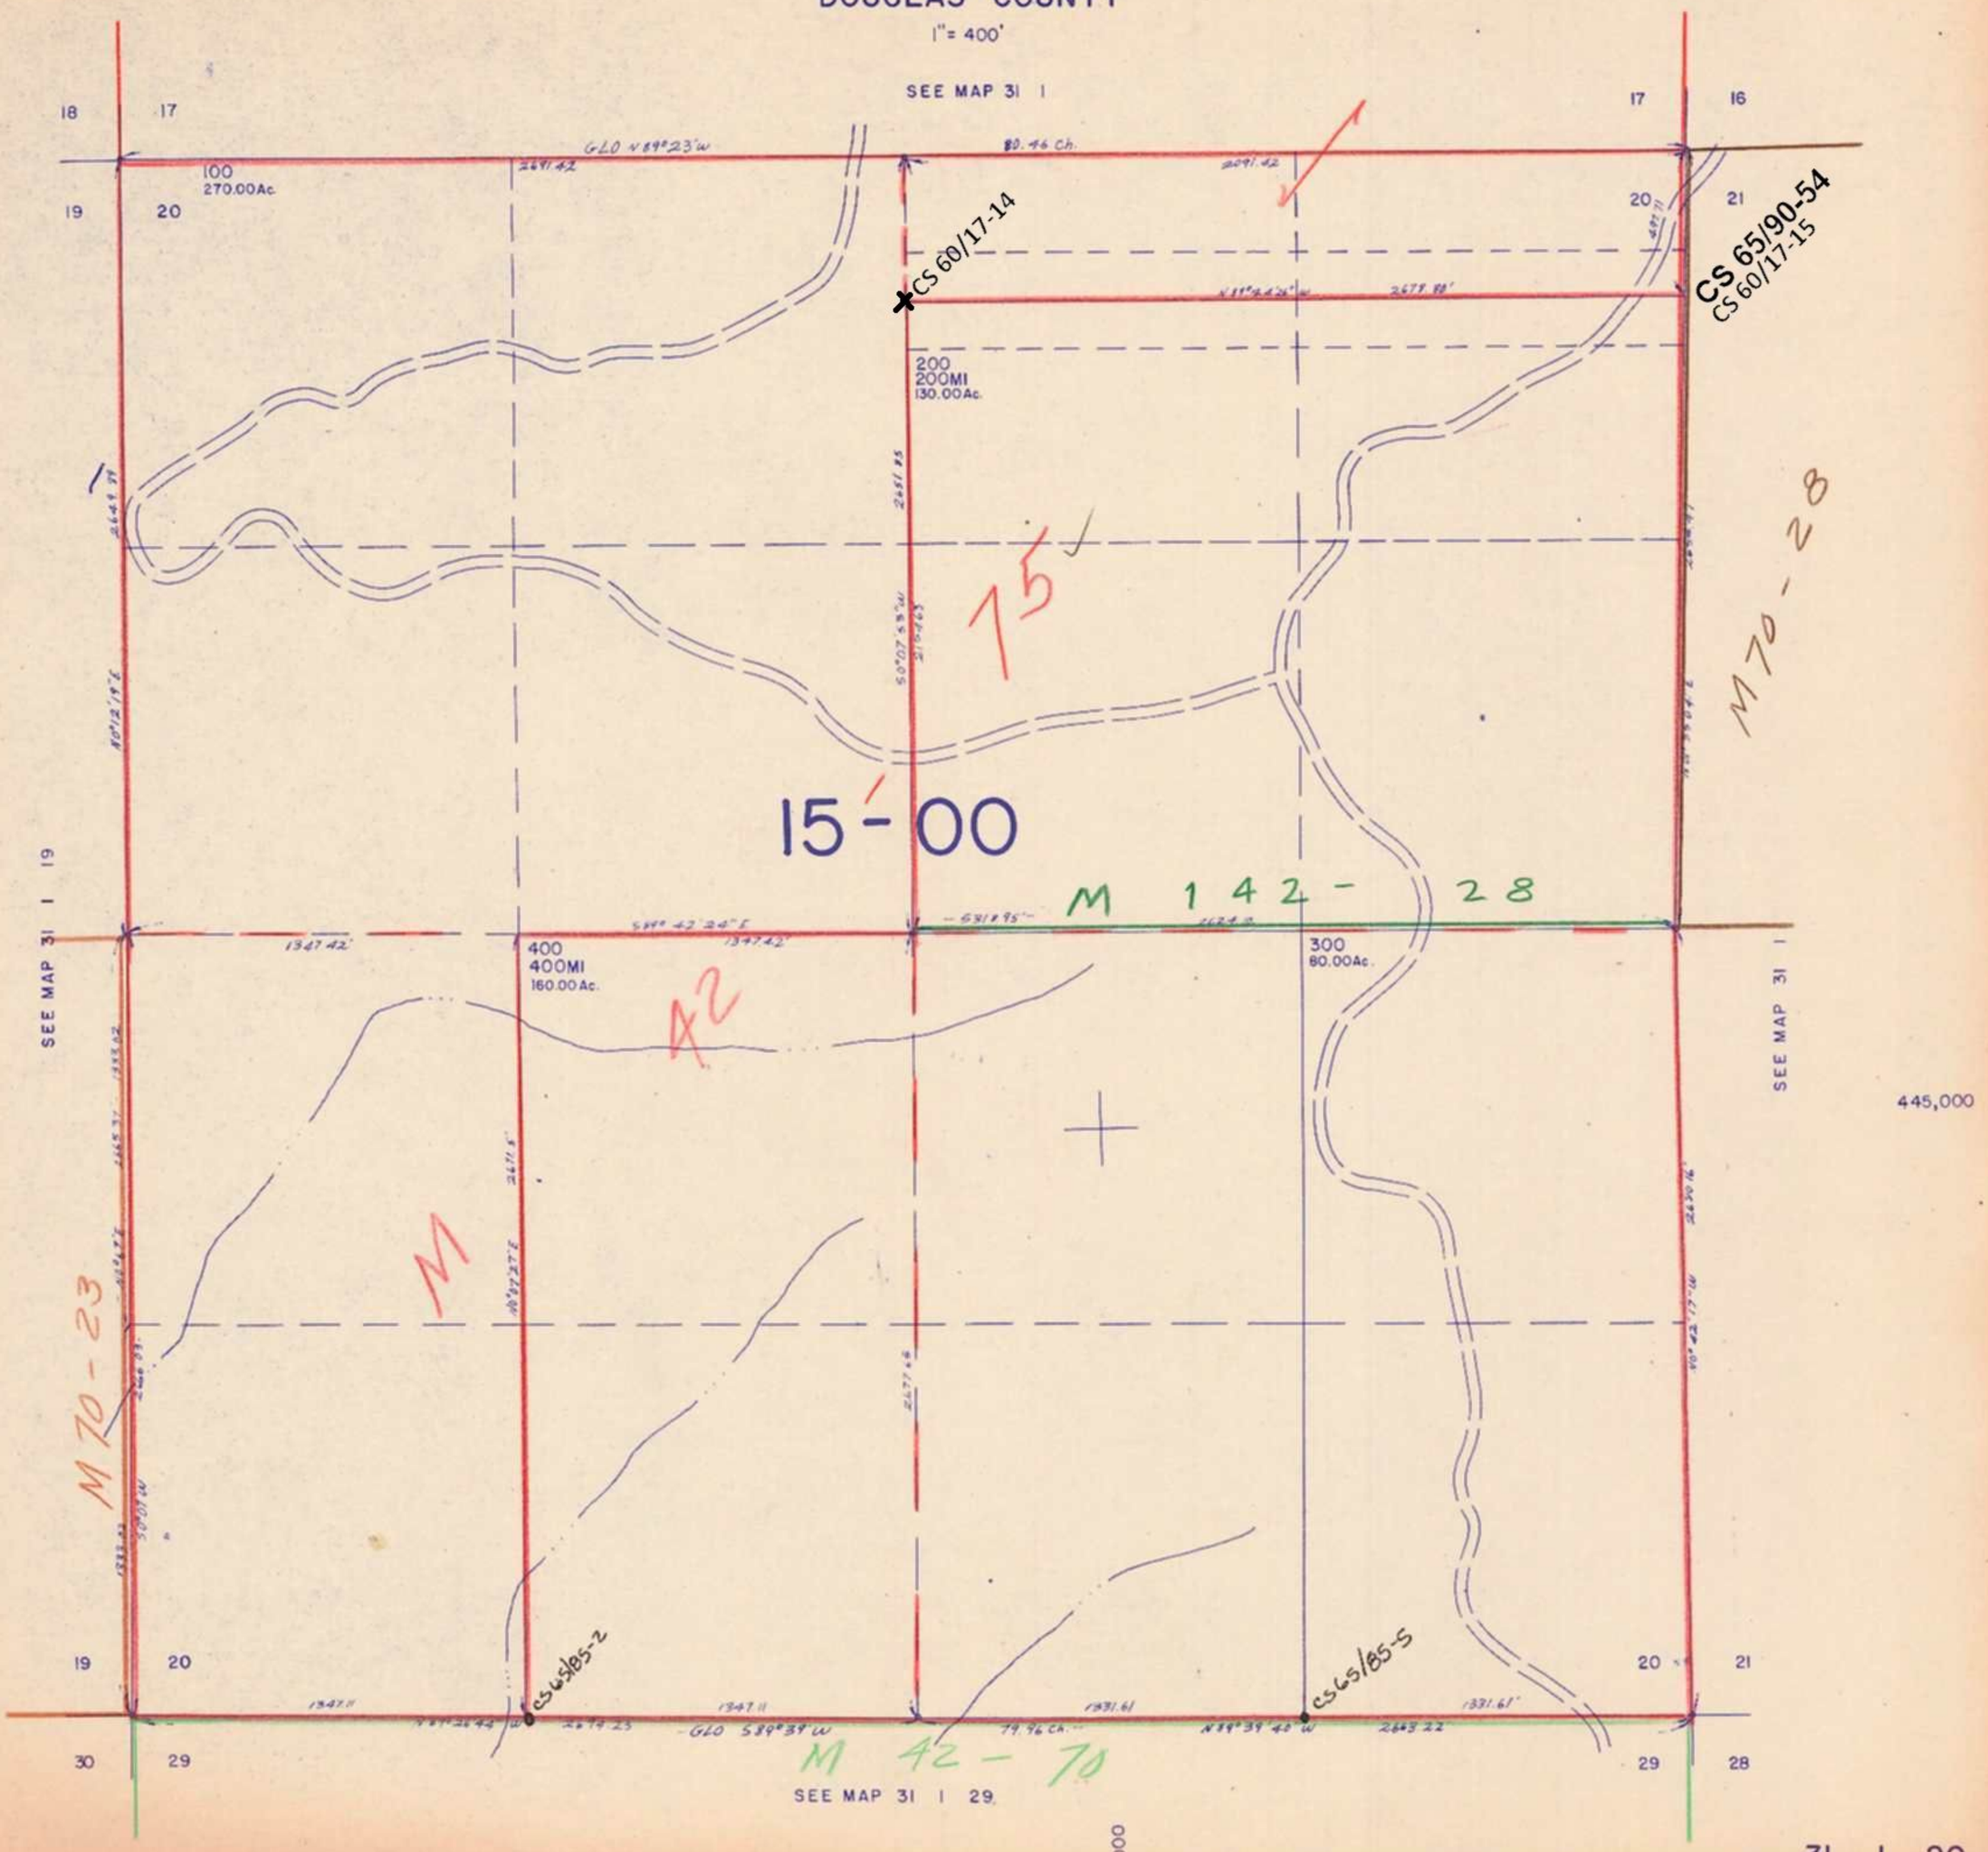
1" = 400'