SECTION 1 T.31S. R.2W. W.M.
DOUGLAS COUNTY

1"-400'
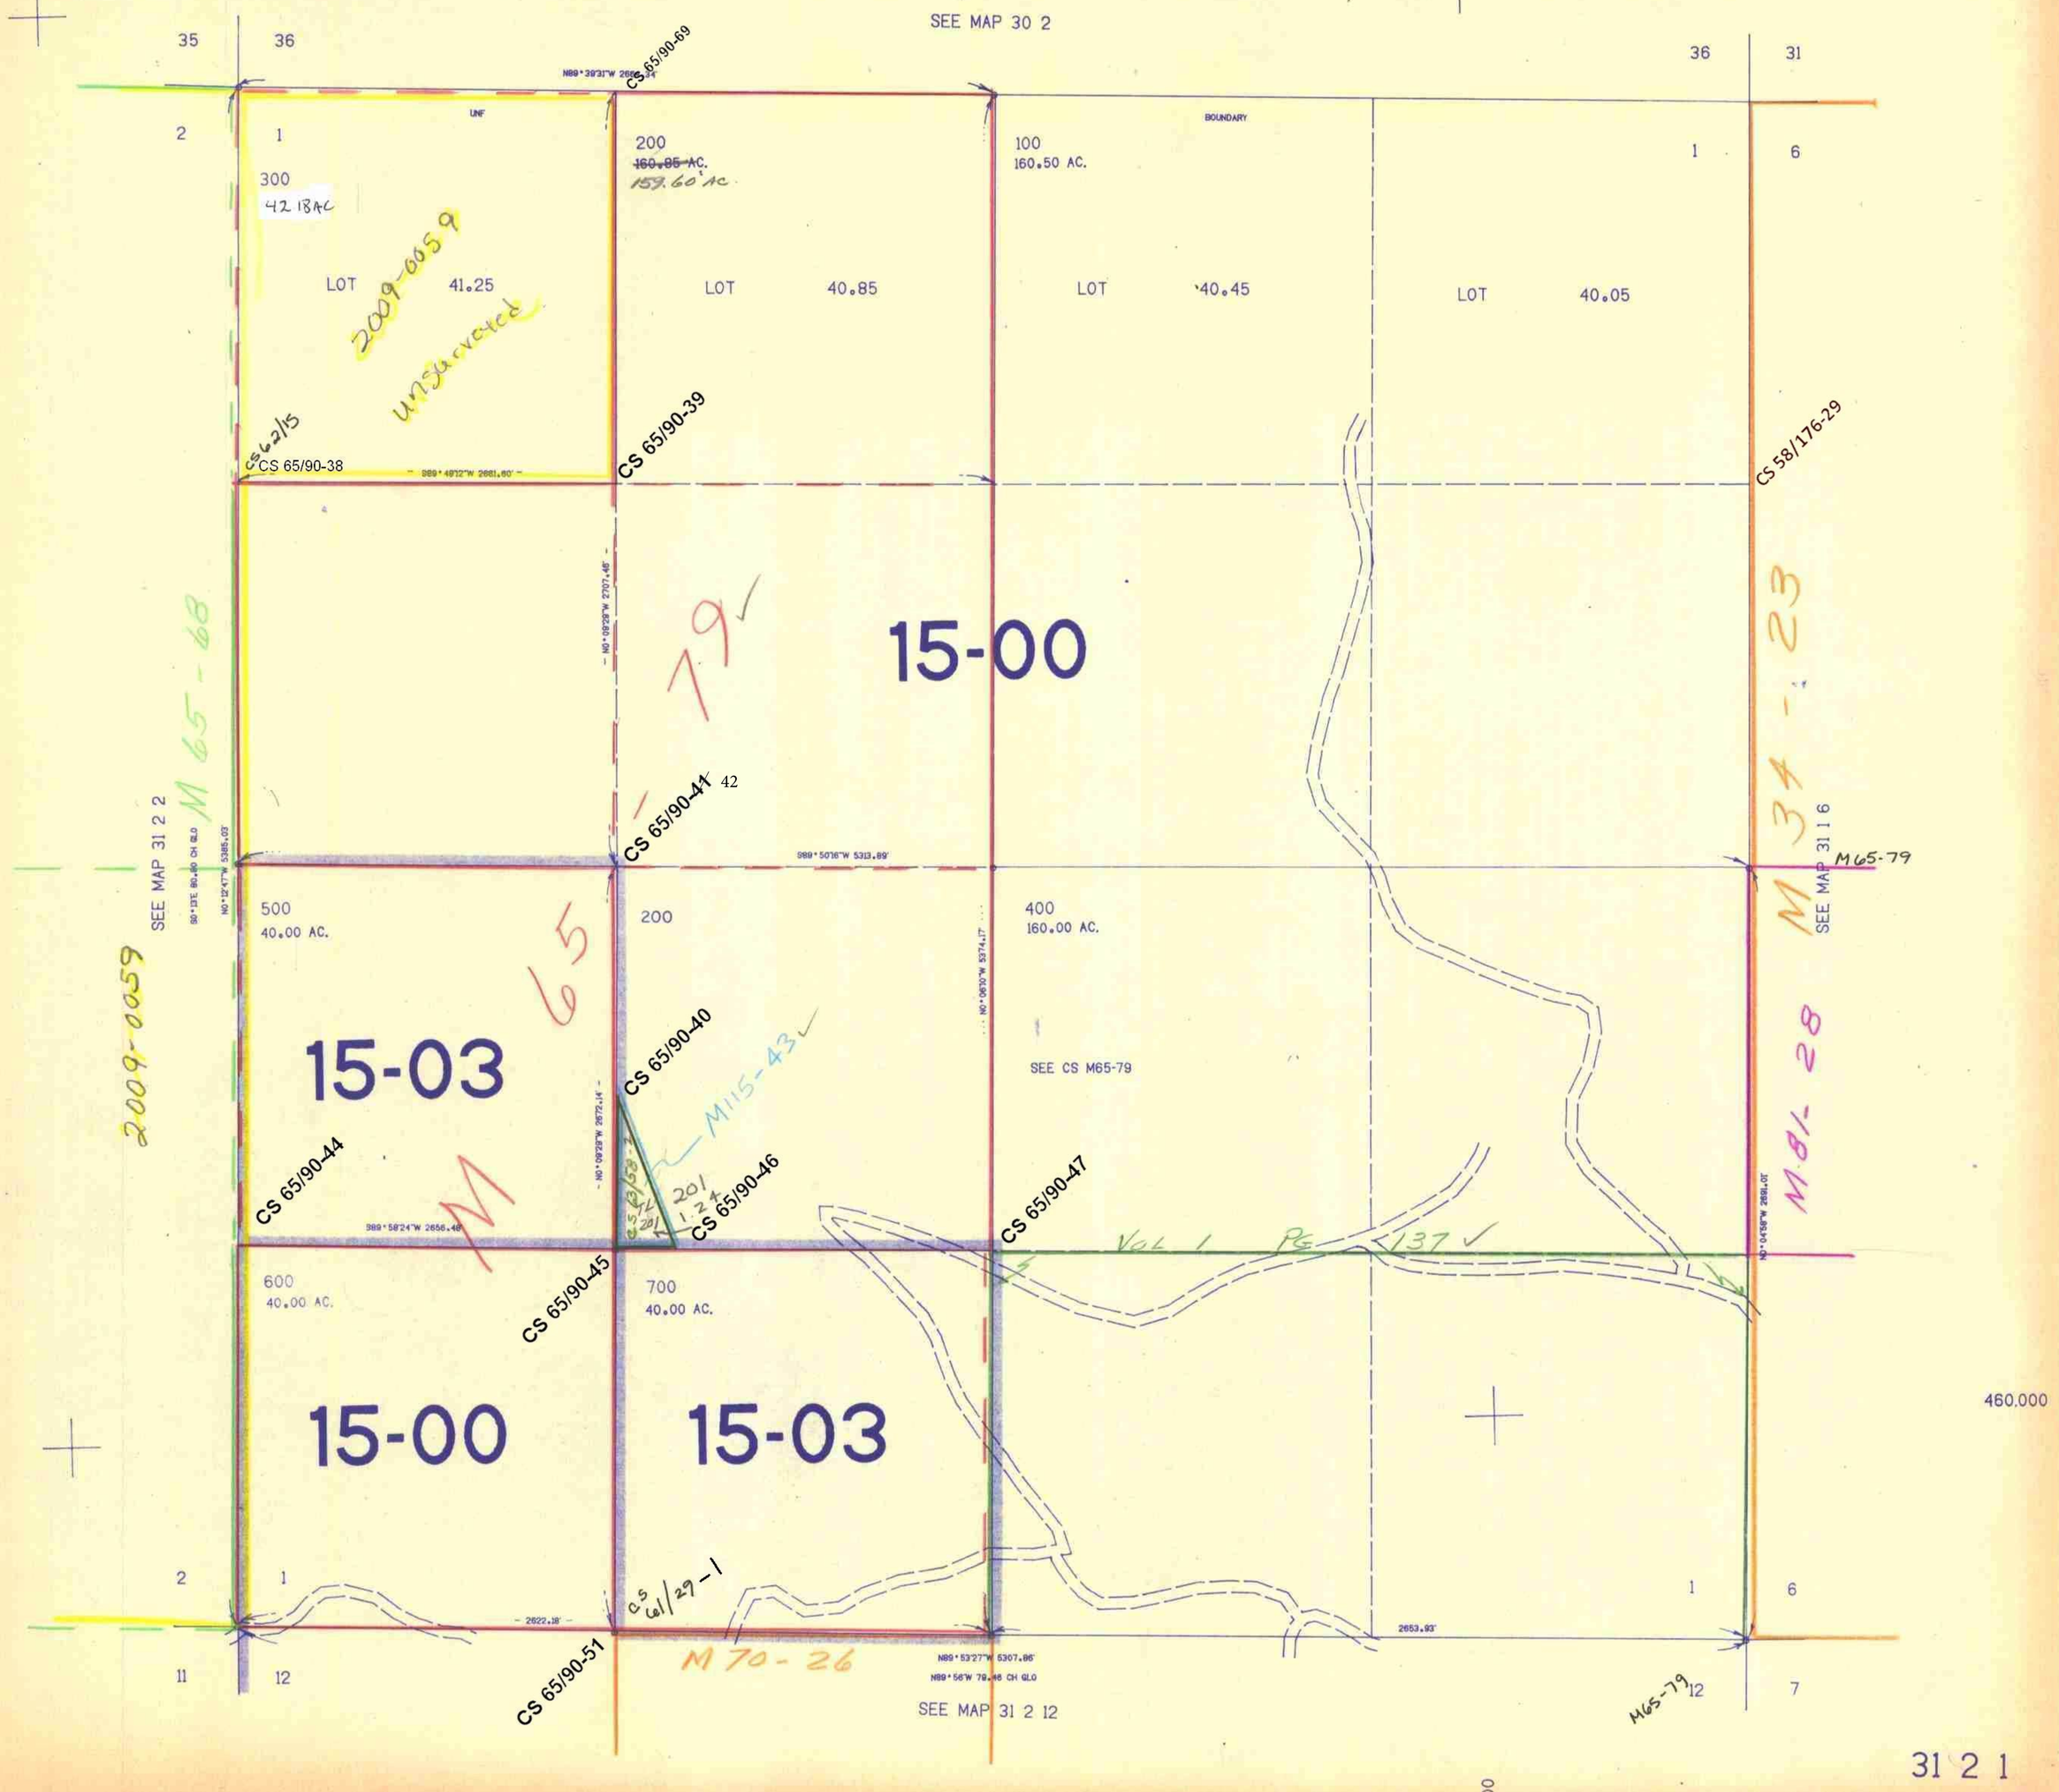
THIS MAP WAS PREPARED FOR ASSESSMENT PURPOSE ONLY.