THIS MAP WAS PREPARED FOR ASSESSMENT PURPOSE ONLY.

SECTION 15 T.31S. R.2W. W.M.
DOUGLAS COUNTY
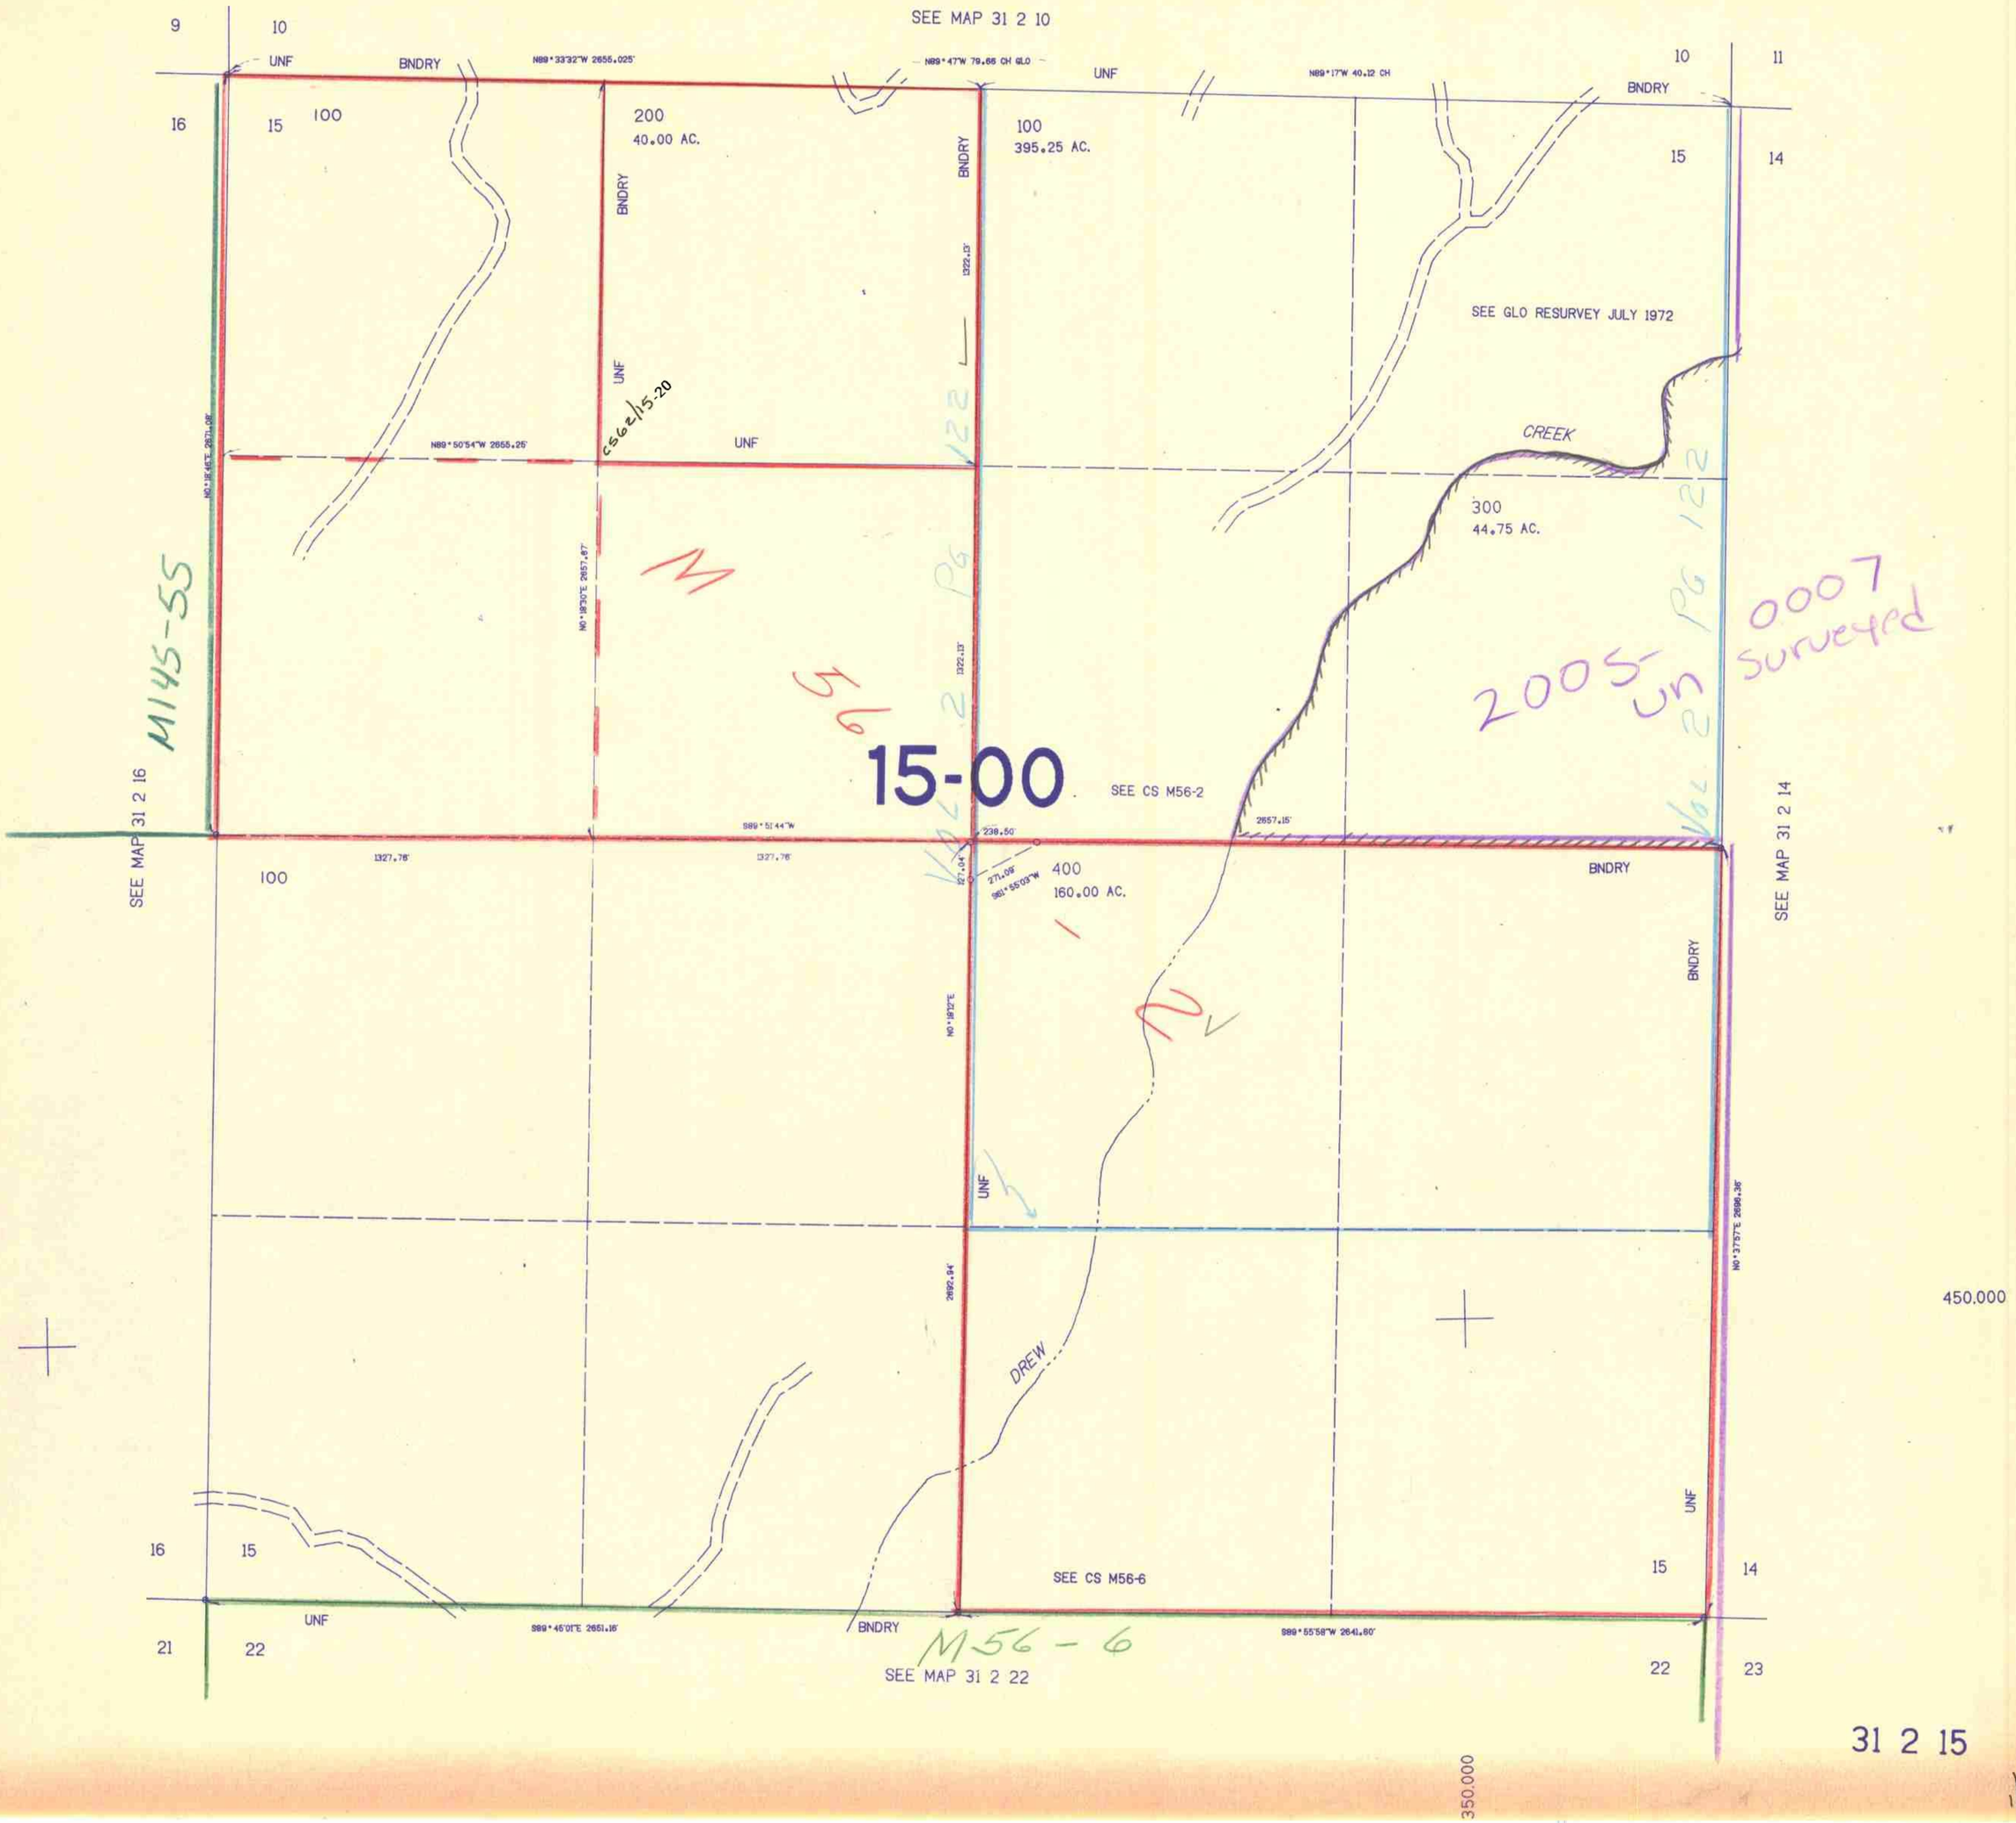
1"=400'