SECTION 31 T.31S. R.3W. W.M.
DOUGLAS COUNTY

THIS MAP WAS PREPARED FOR ASSESSMENT PURPOSE ONLY.
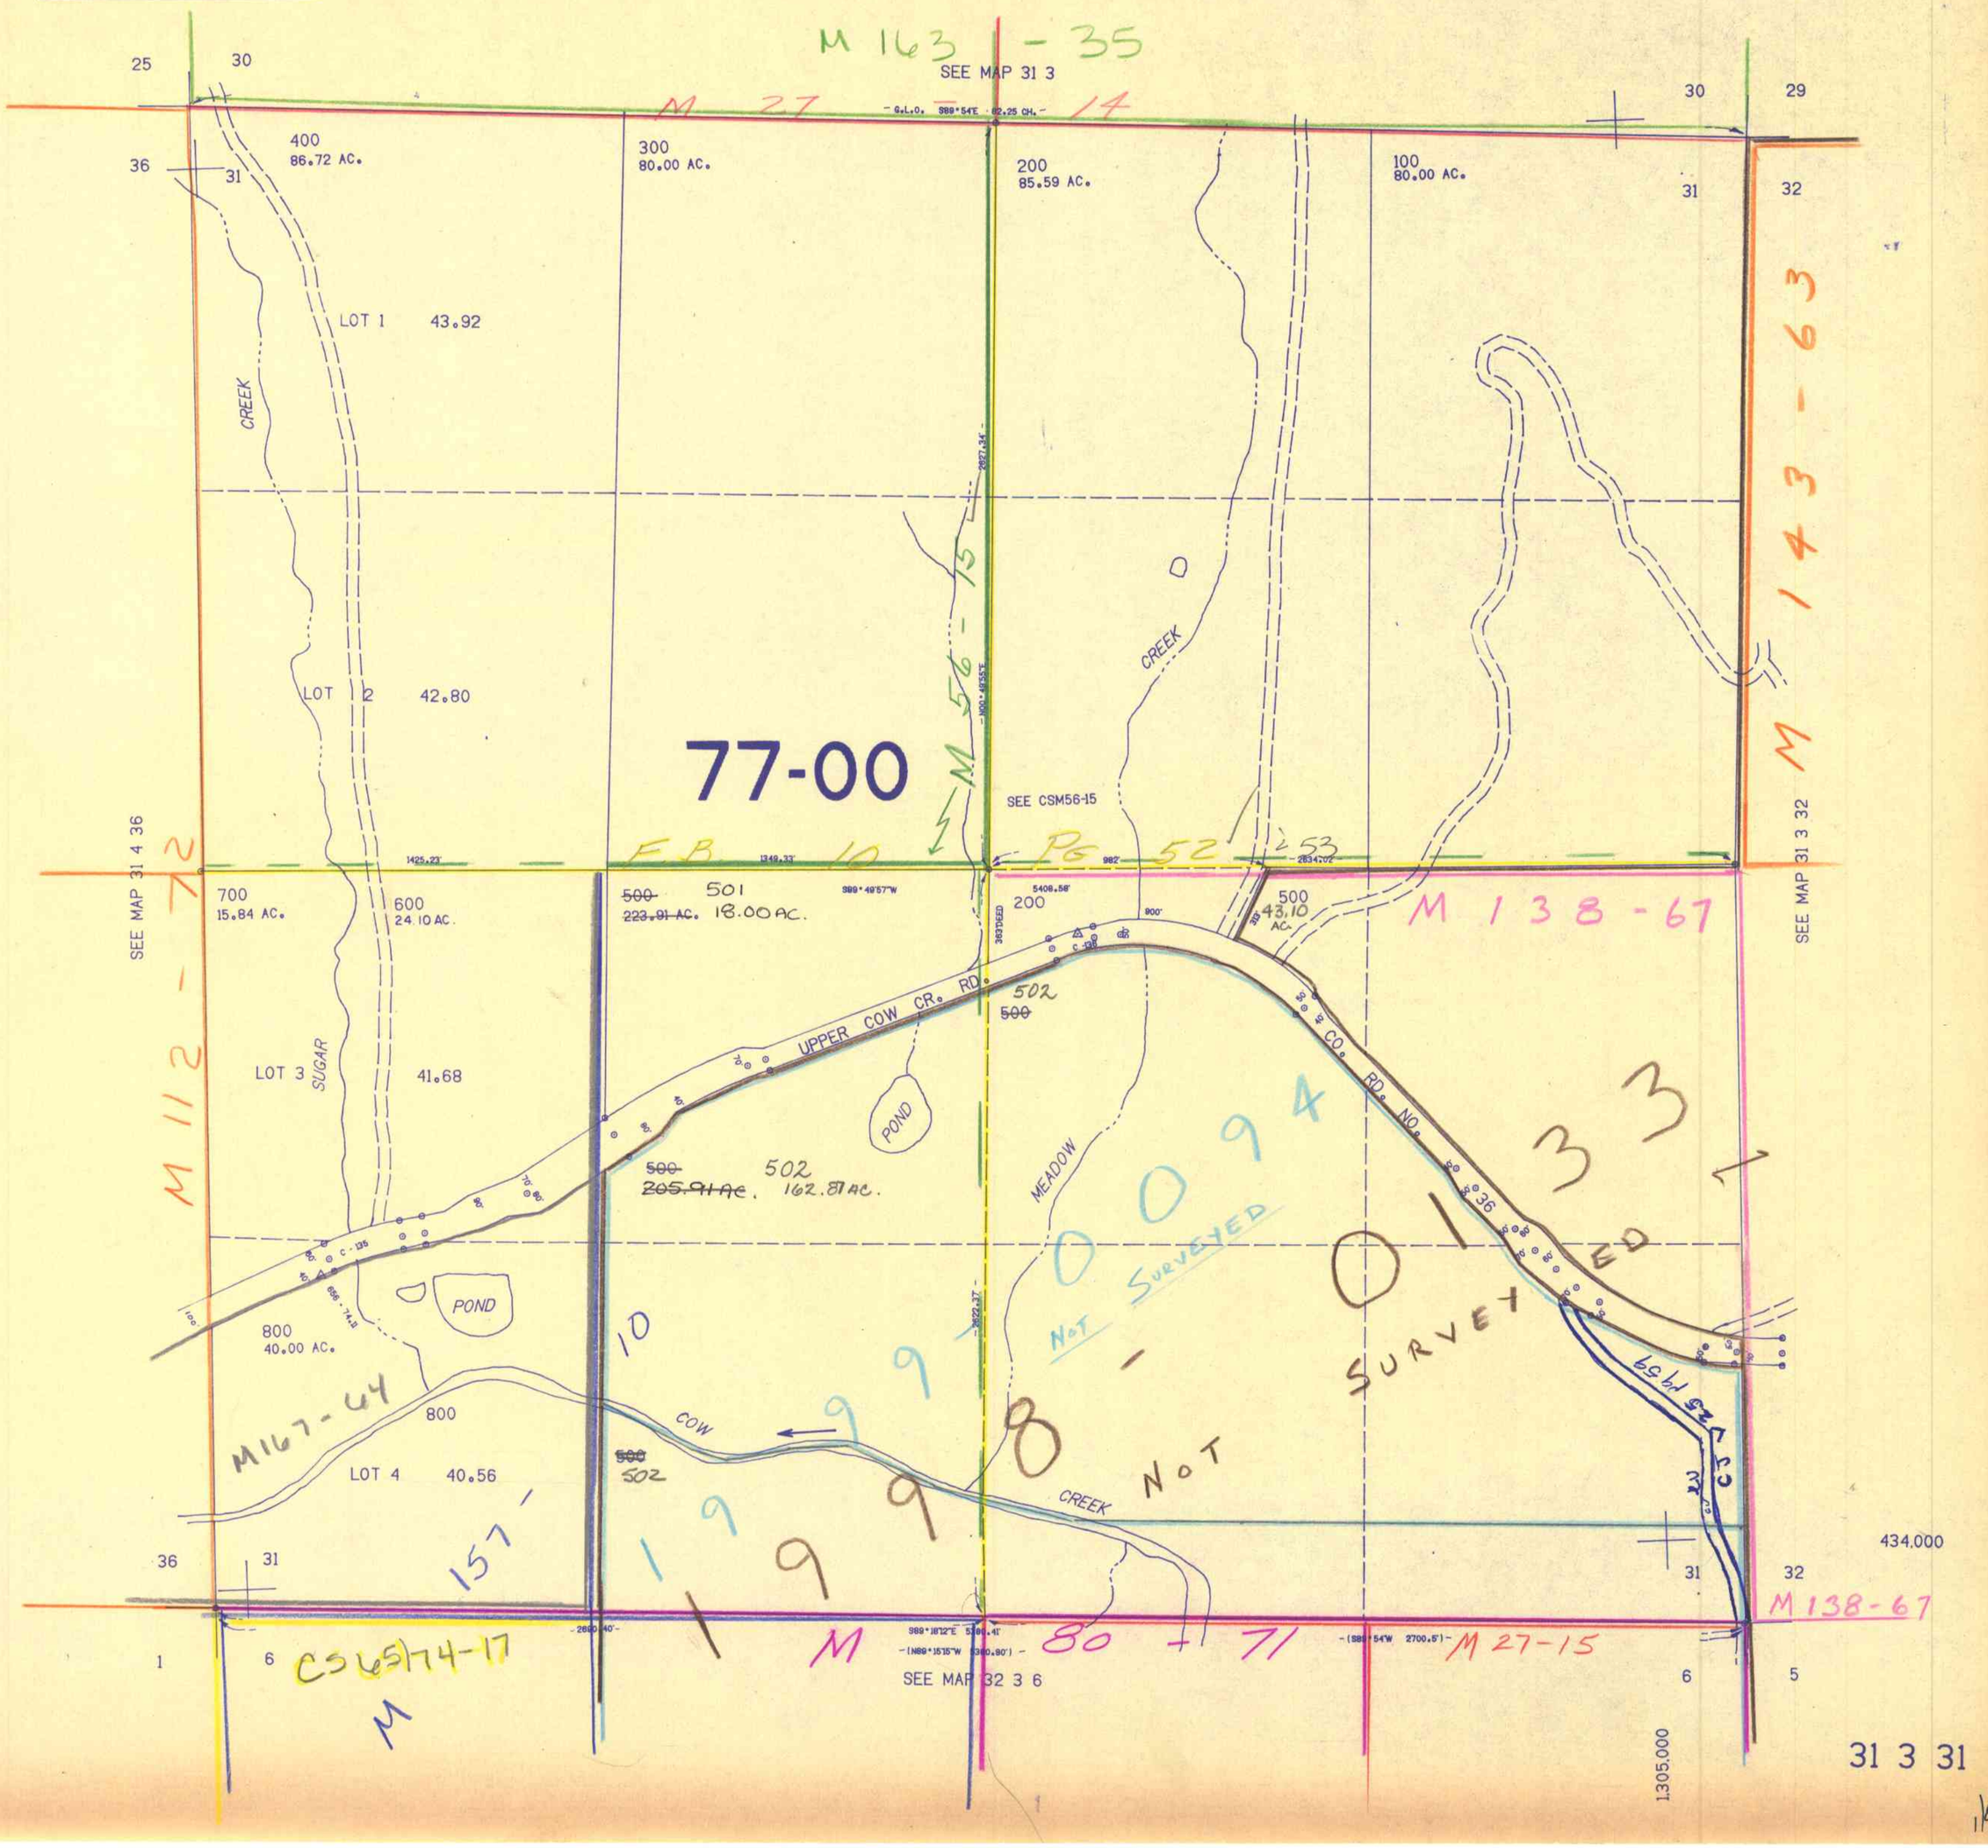
1"=400'