


SECTION 18 T.32S. R.1W. W.M.
DOUGLAS COUNTY

32 1 18

THIS MAP WAS PREPARED FOR
ASSESSMENT PURPOSE ONLY.

1"=400'

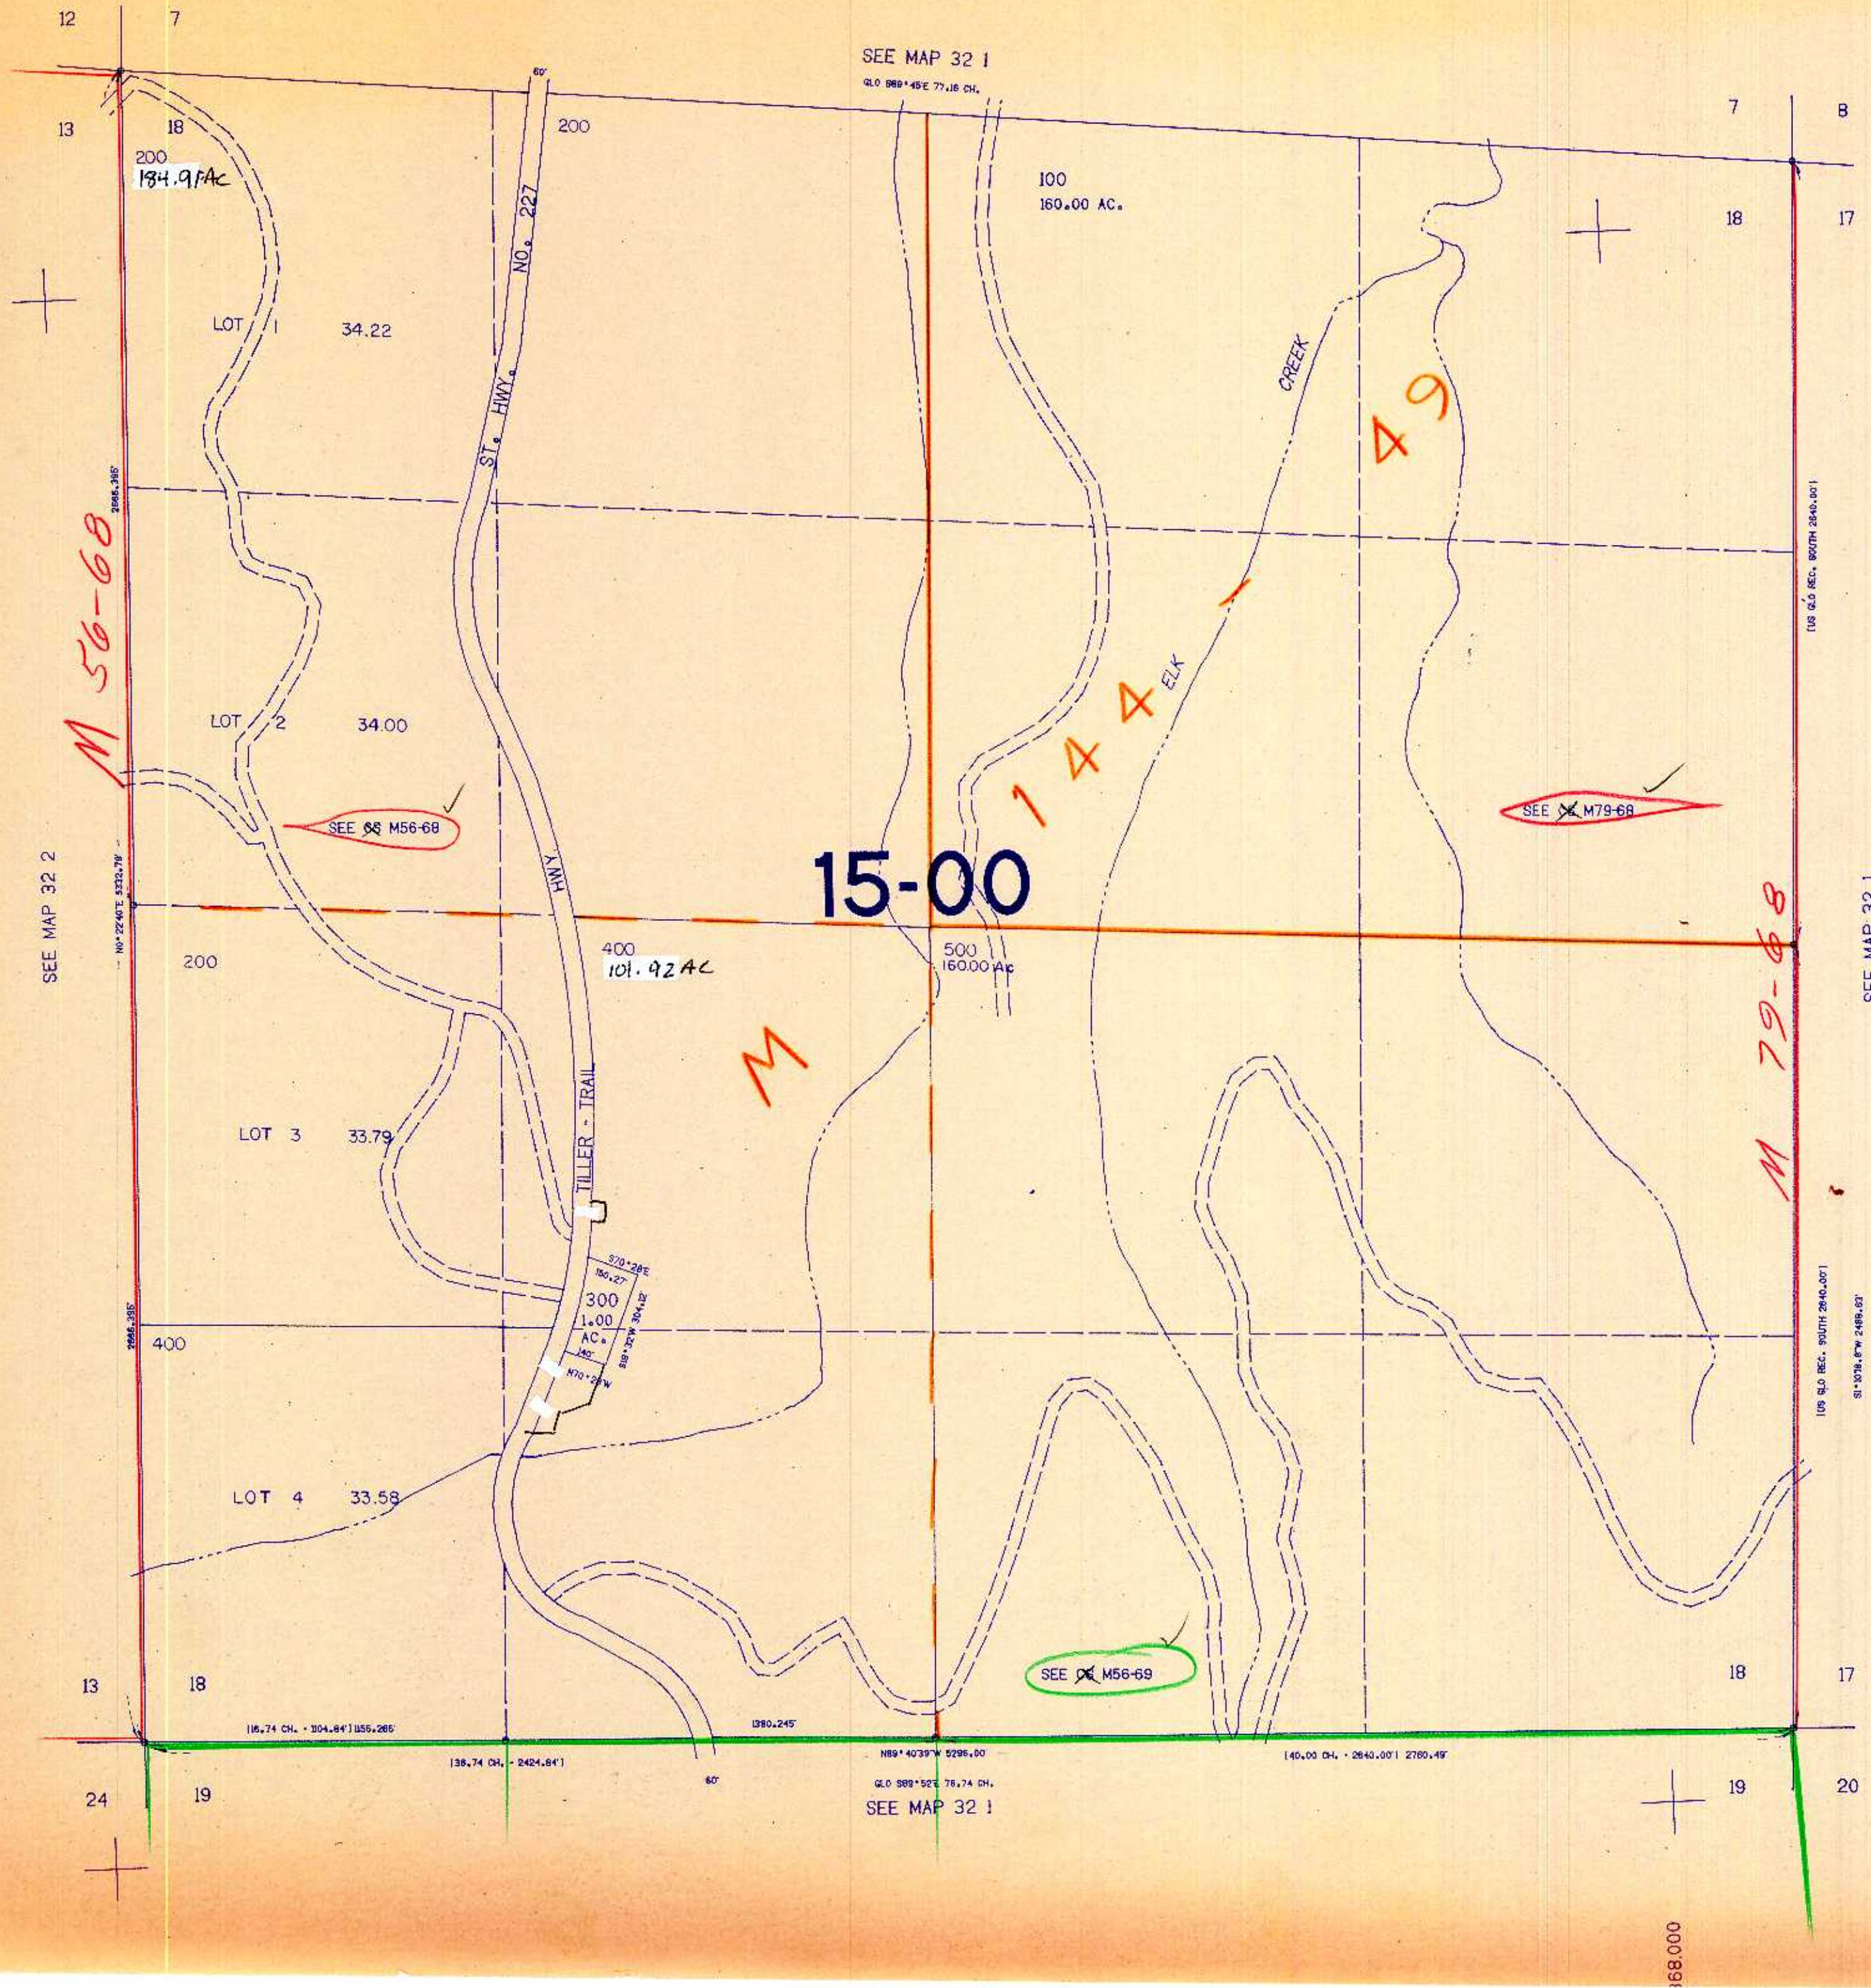

32 1 18

2/84 BR