


1" = 2000'  
SEE MAP 31 2

see BLM Mineral Survey T31-2  
CS 62/26-5  
CS 65/106-15

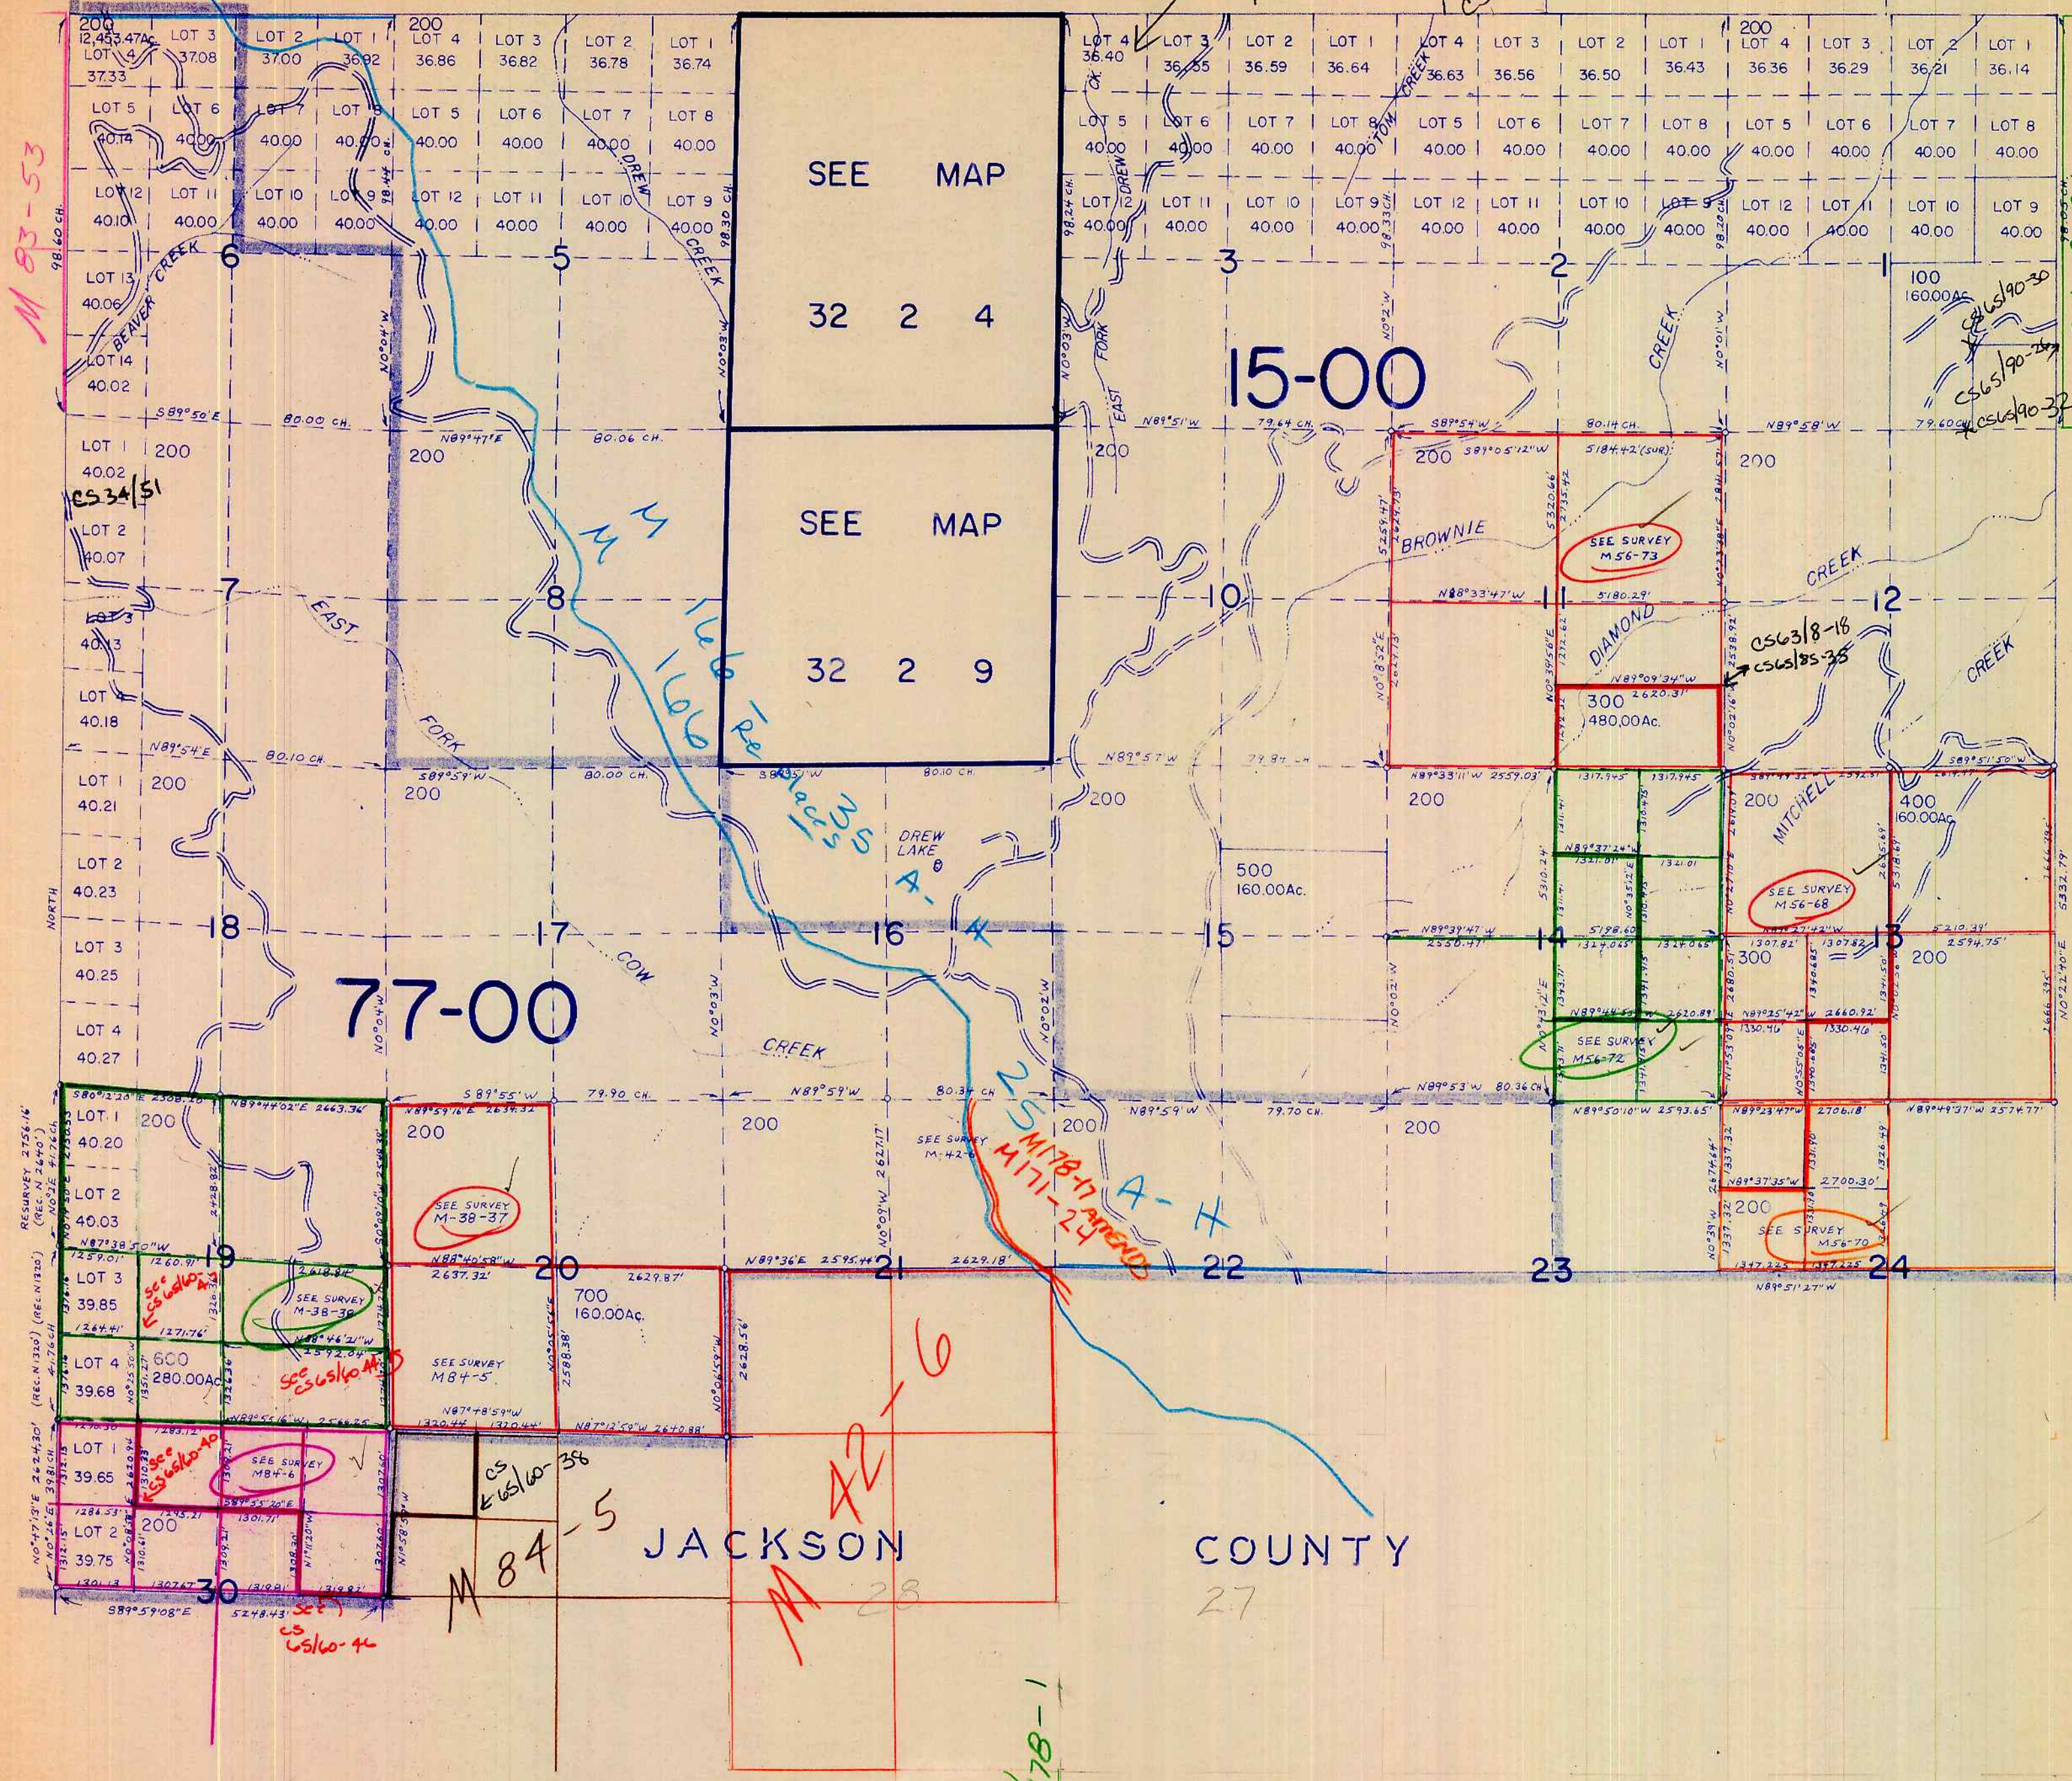

SEE MAP 32 3

SEE MAP 32 1

JACKSON COUNTY

33

34

C.S. 58/178-1