


T.32S. R.3W. W.M.
DOUGLAS COUNTY

THIS MAP WAS PREPARED FOR
ASSESSMENT PURPOSE ONLY.

1"=2000'

SEE MAP 31 3

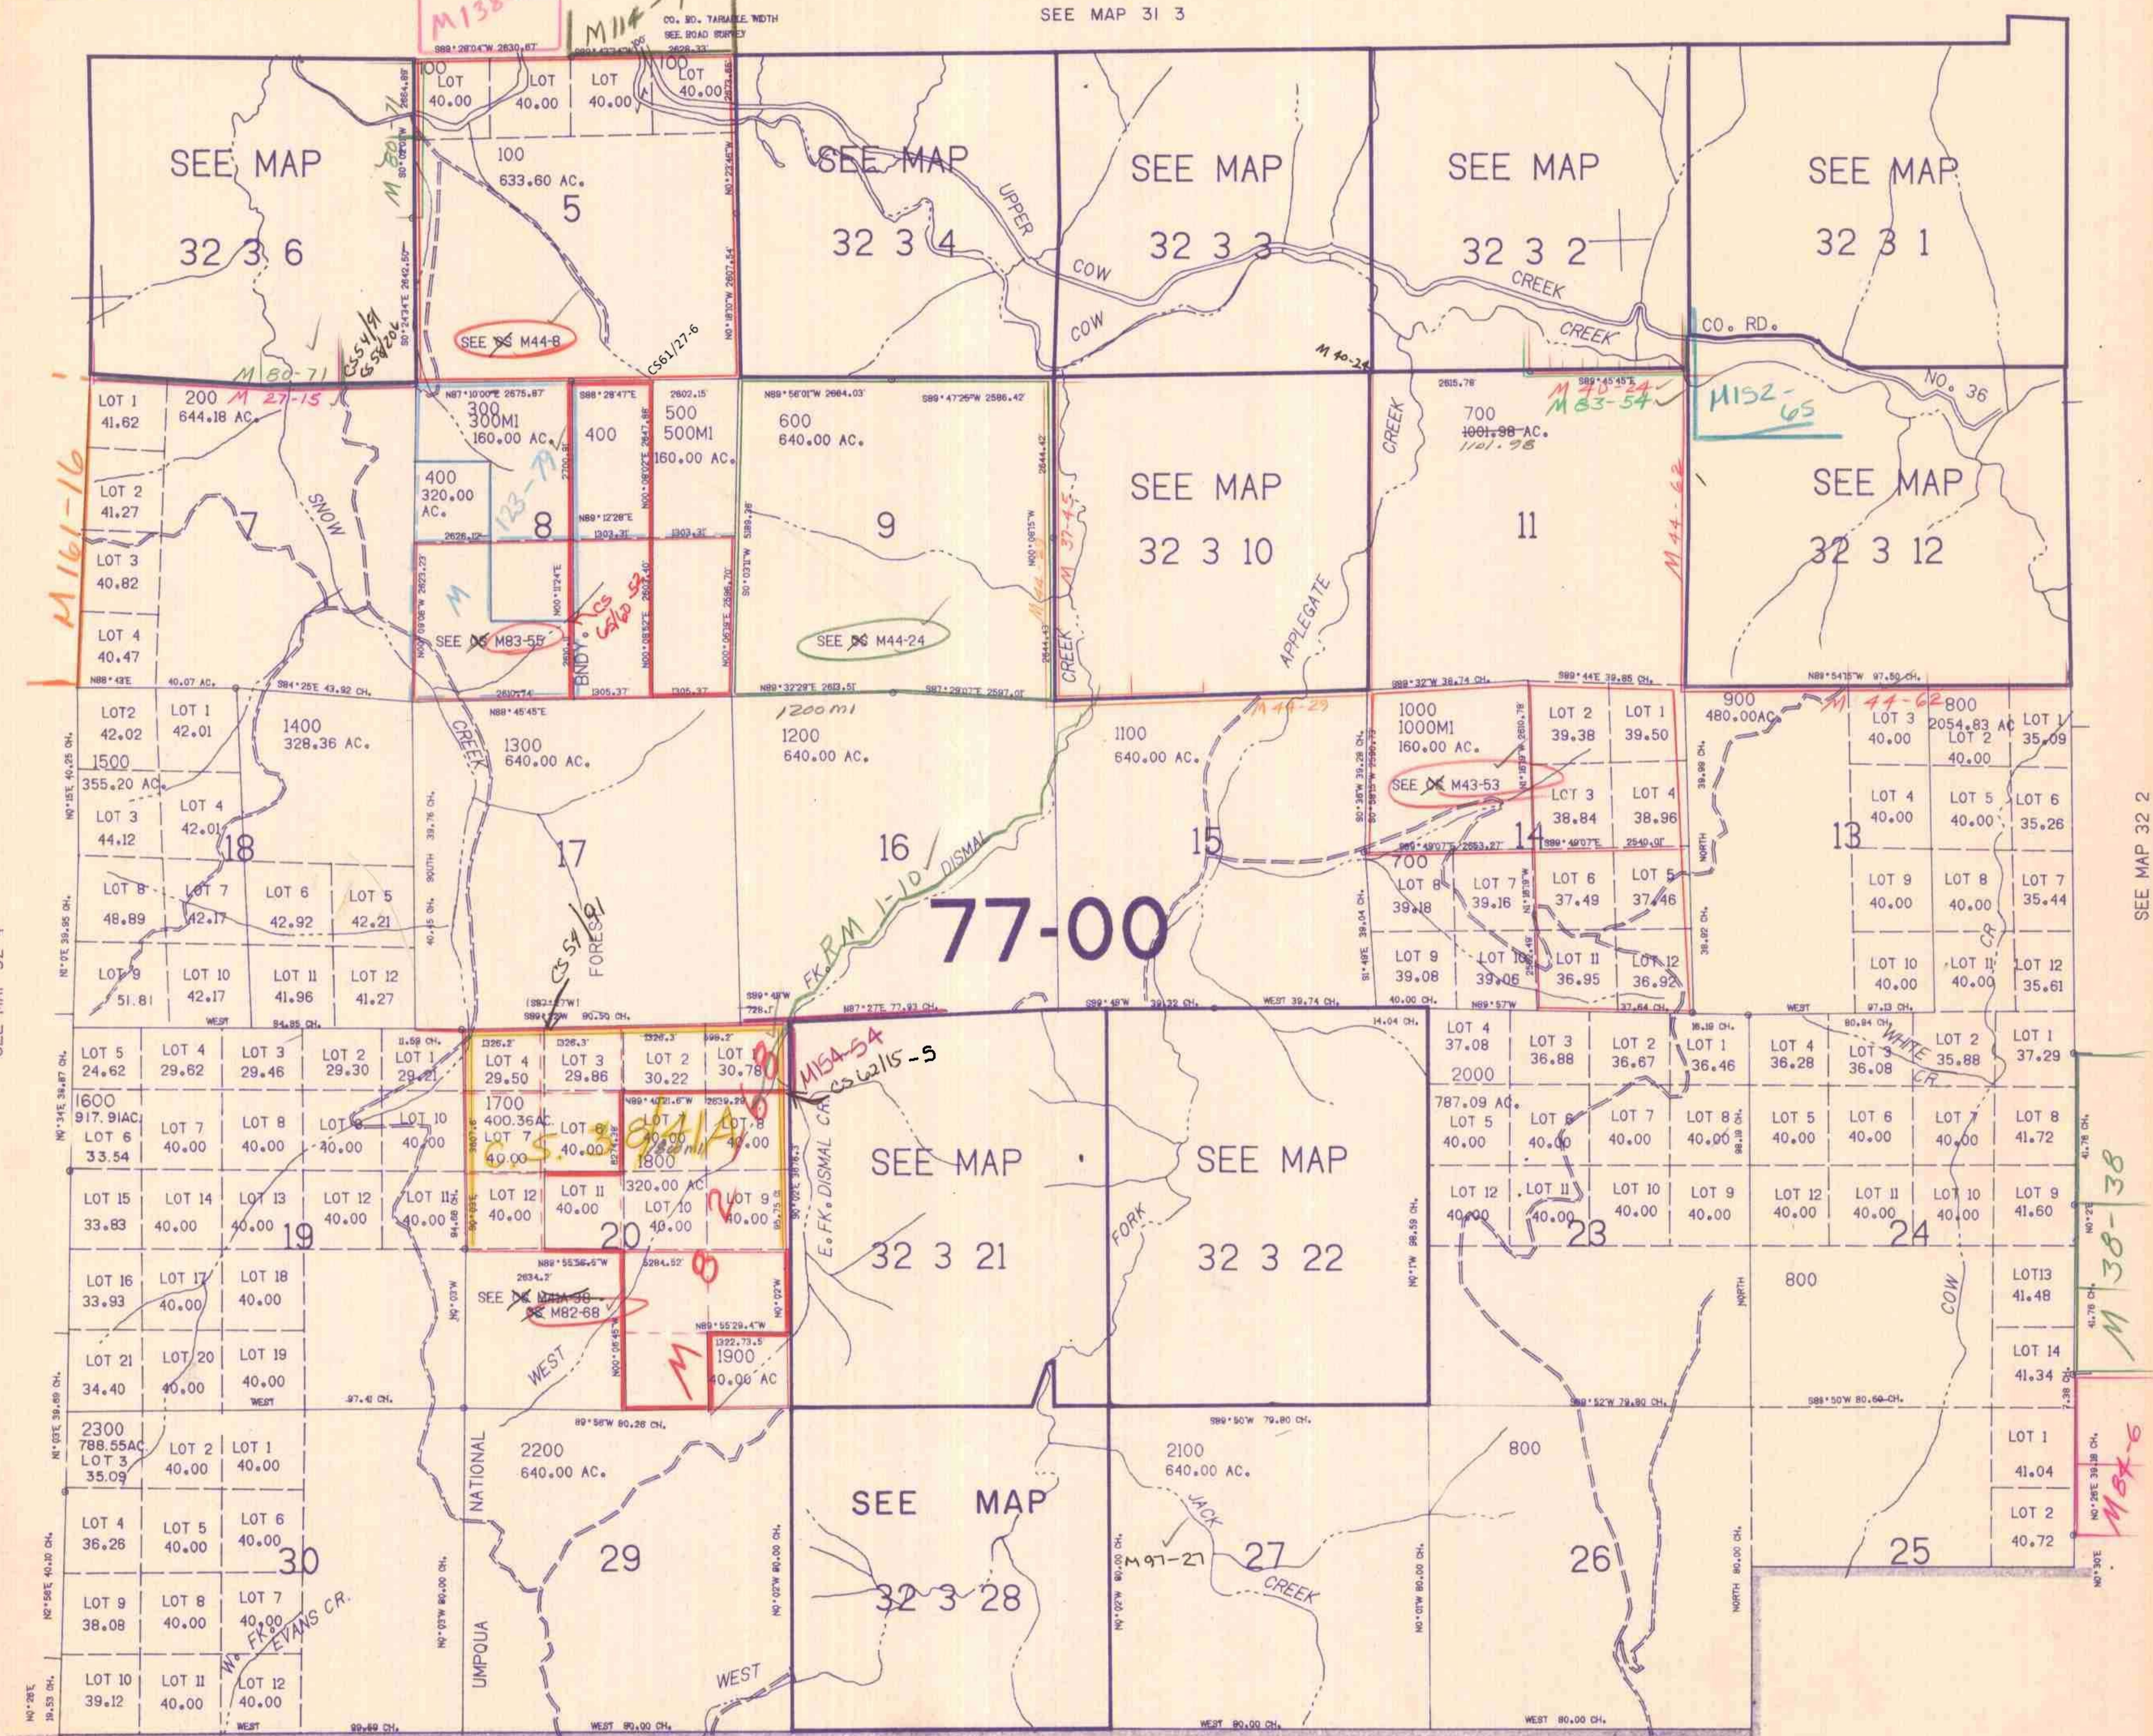

JACKSON COUNTY

3/84 68

405,000

325,000