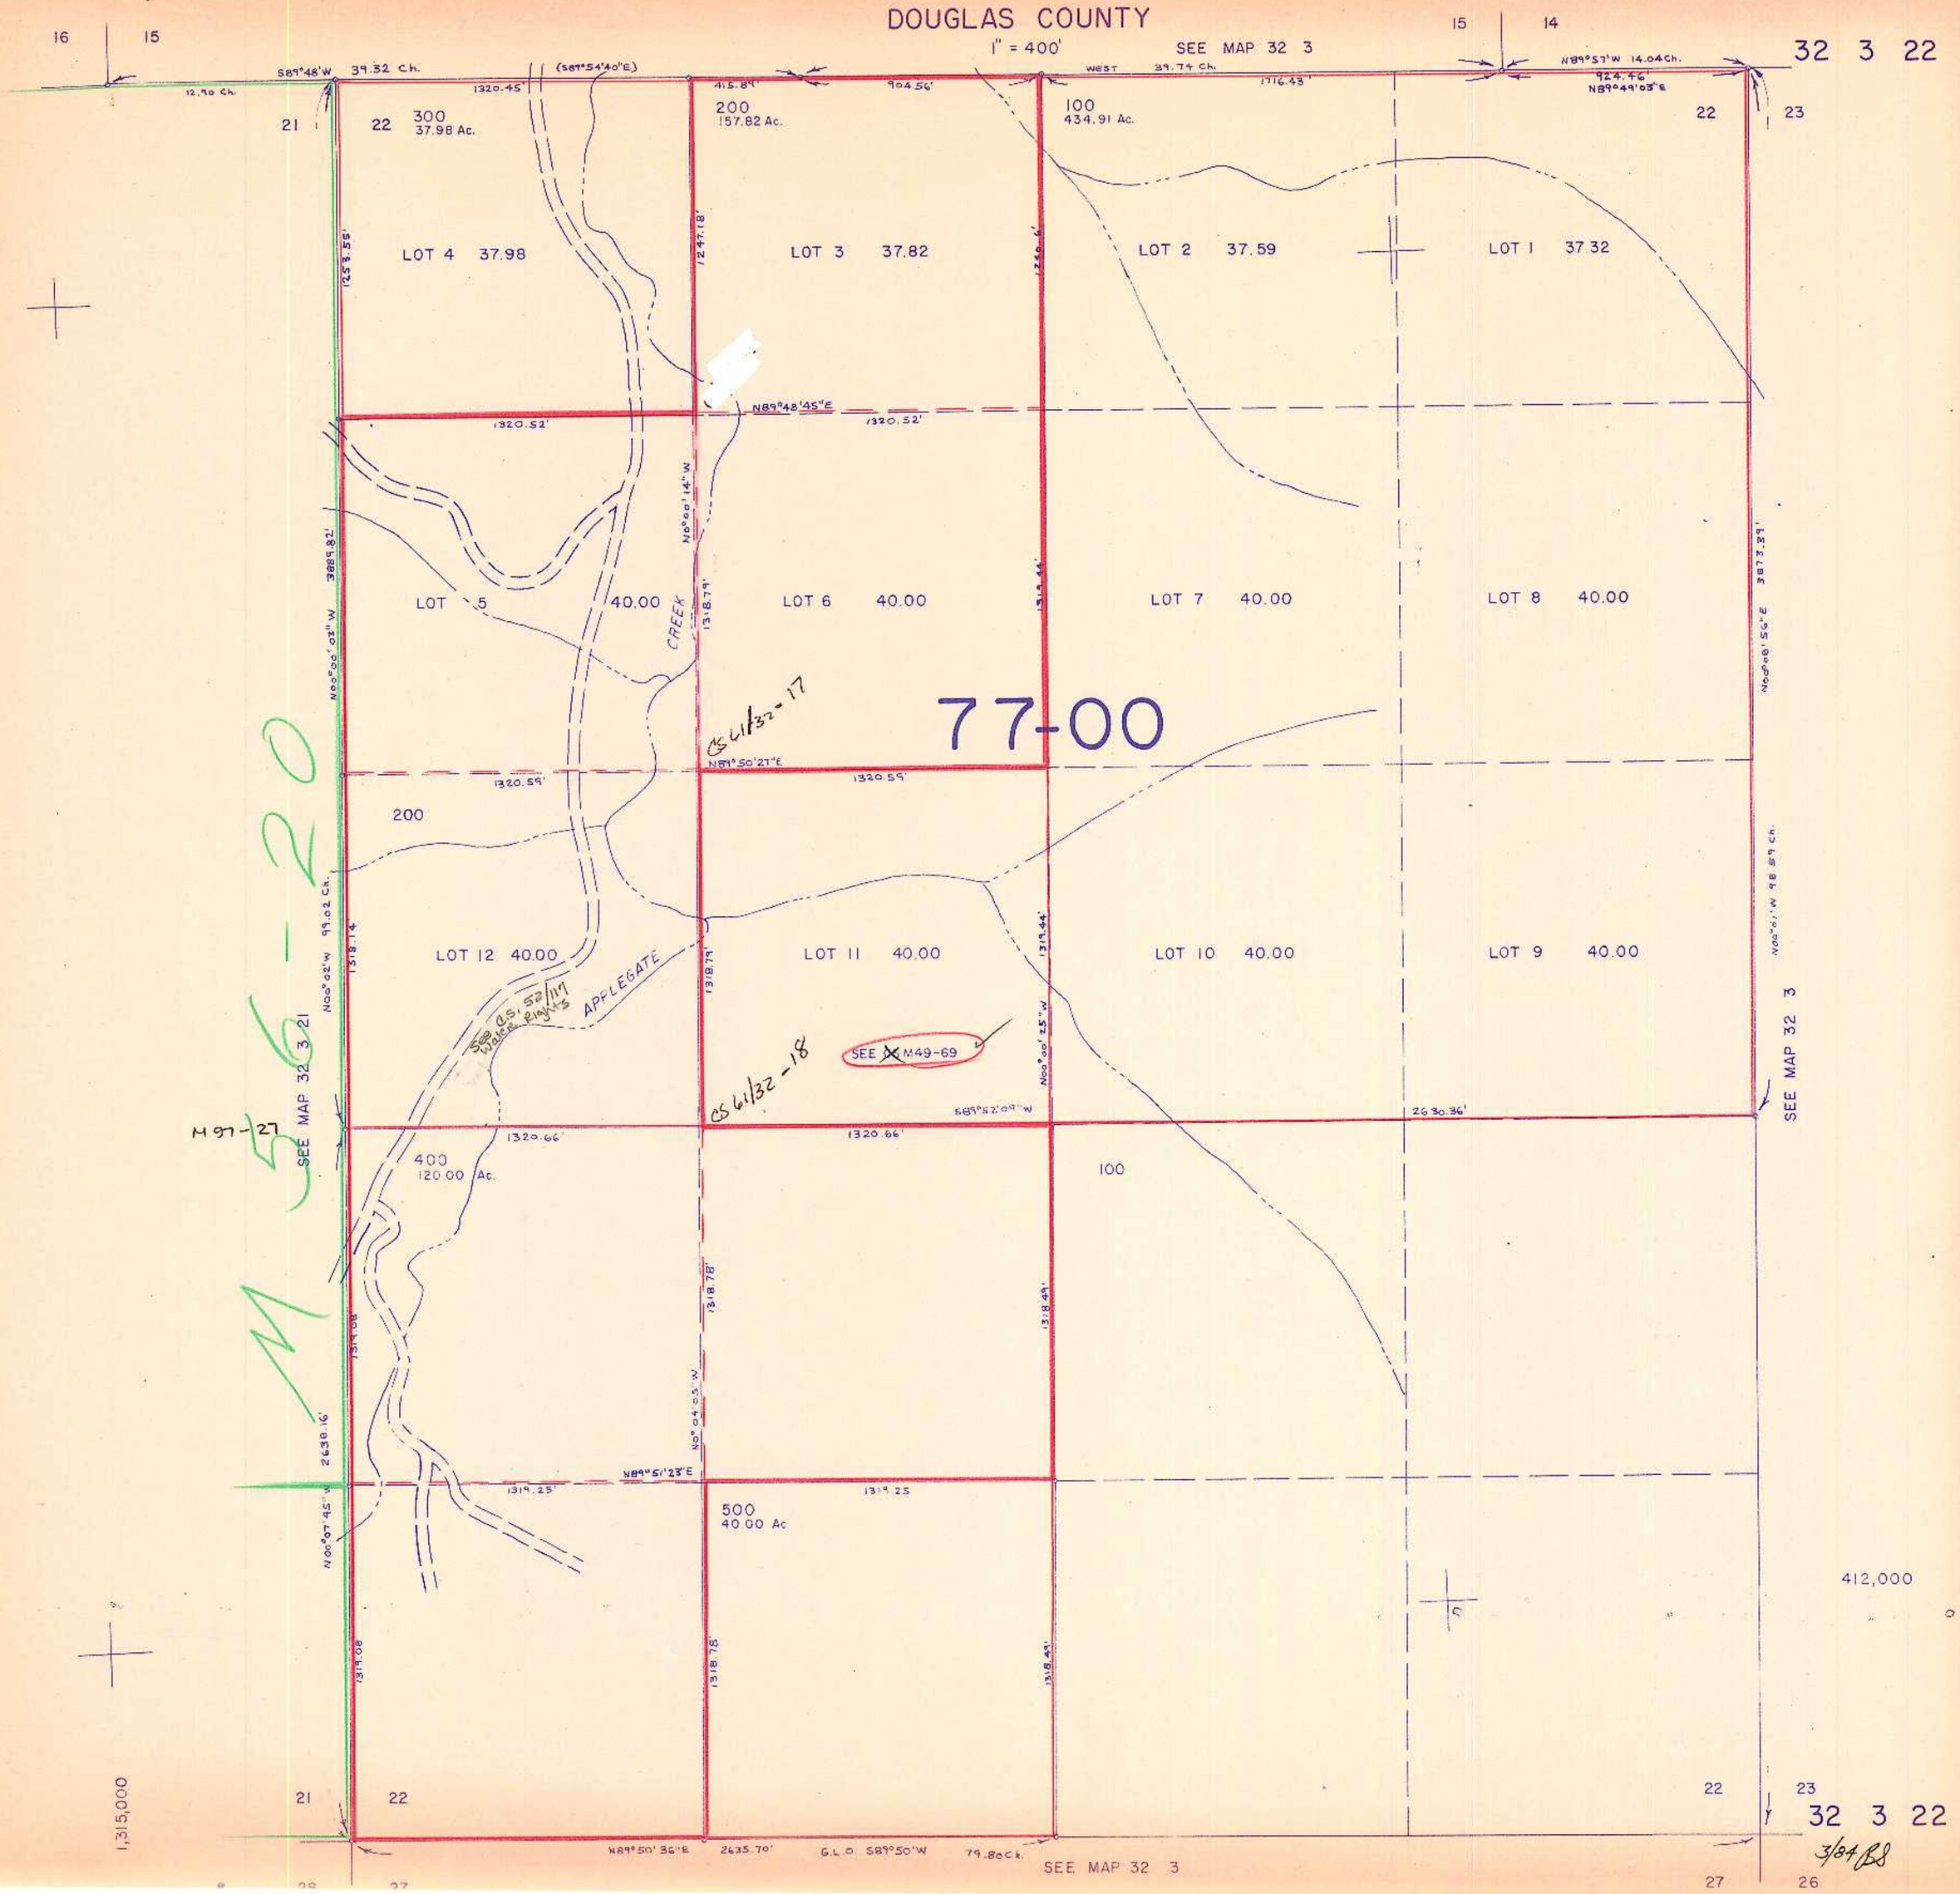SECTION 22 T.32S. R.3W. W.M.
DOUGLAS COUNTY
1" = 400'