SECTION 32 T.32S. R.4W. W.M.
DOUGLAS COUNTY

THIS MAP WAS PREPARED FOR ASSESSMENT PURPOSE ONLY.

32 4 32

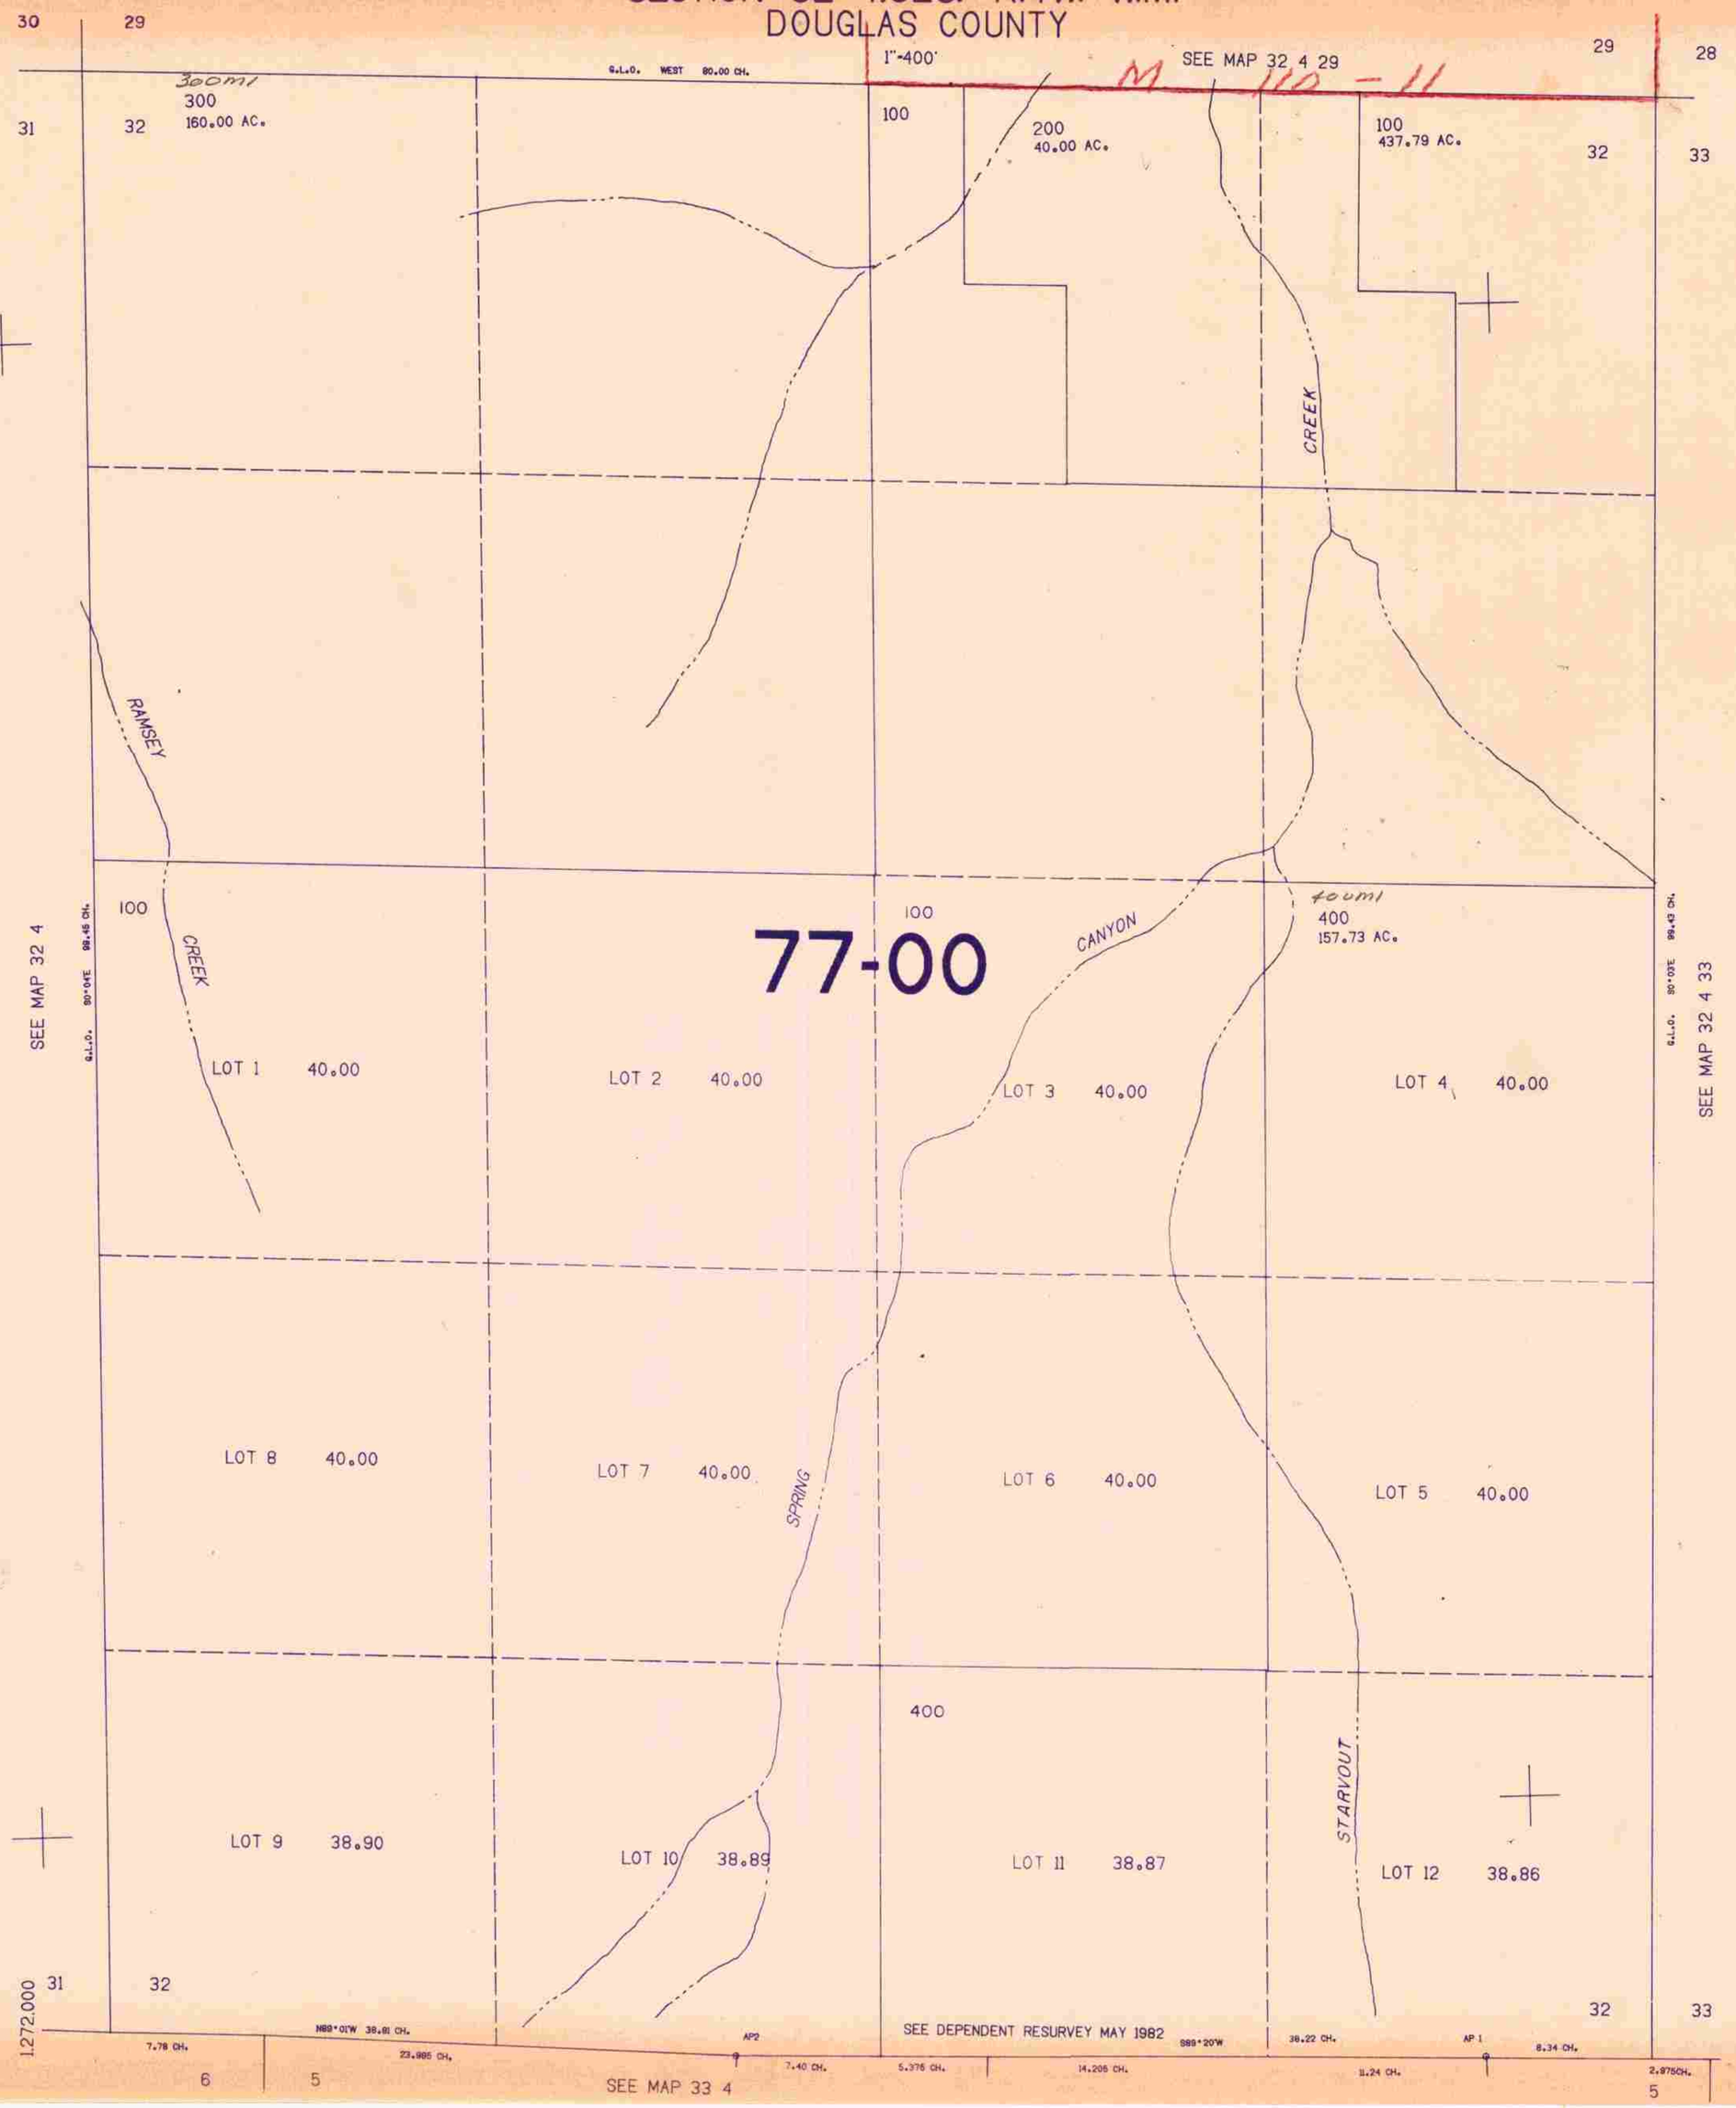

32 4 32
7/84 BS