SW1/4 SEC.21 T.32S. R.5W. W.M.
DOUGLAS COUNTY

1"=200'
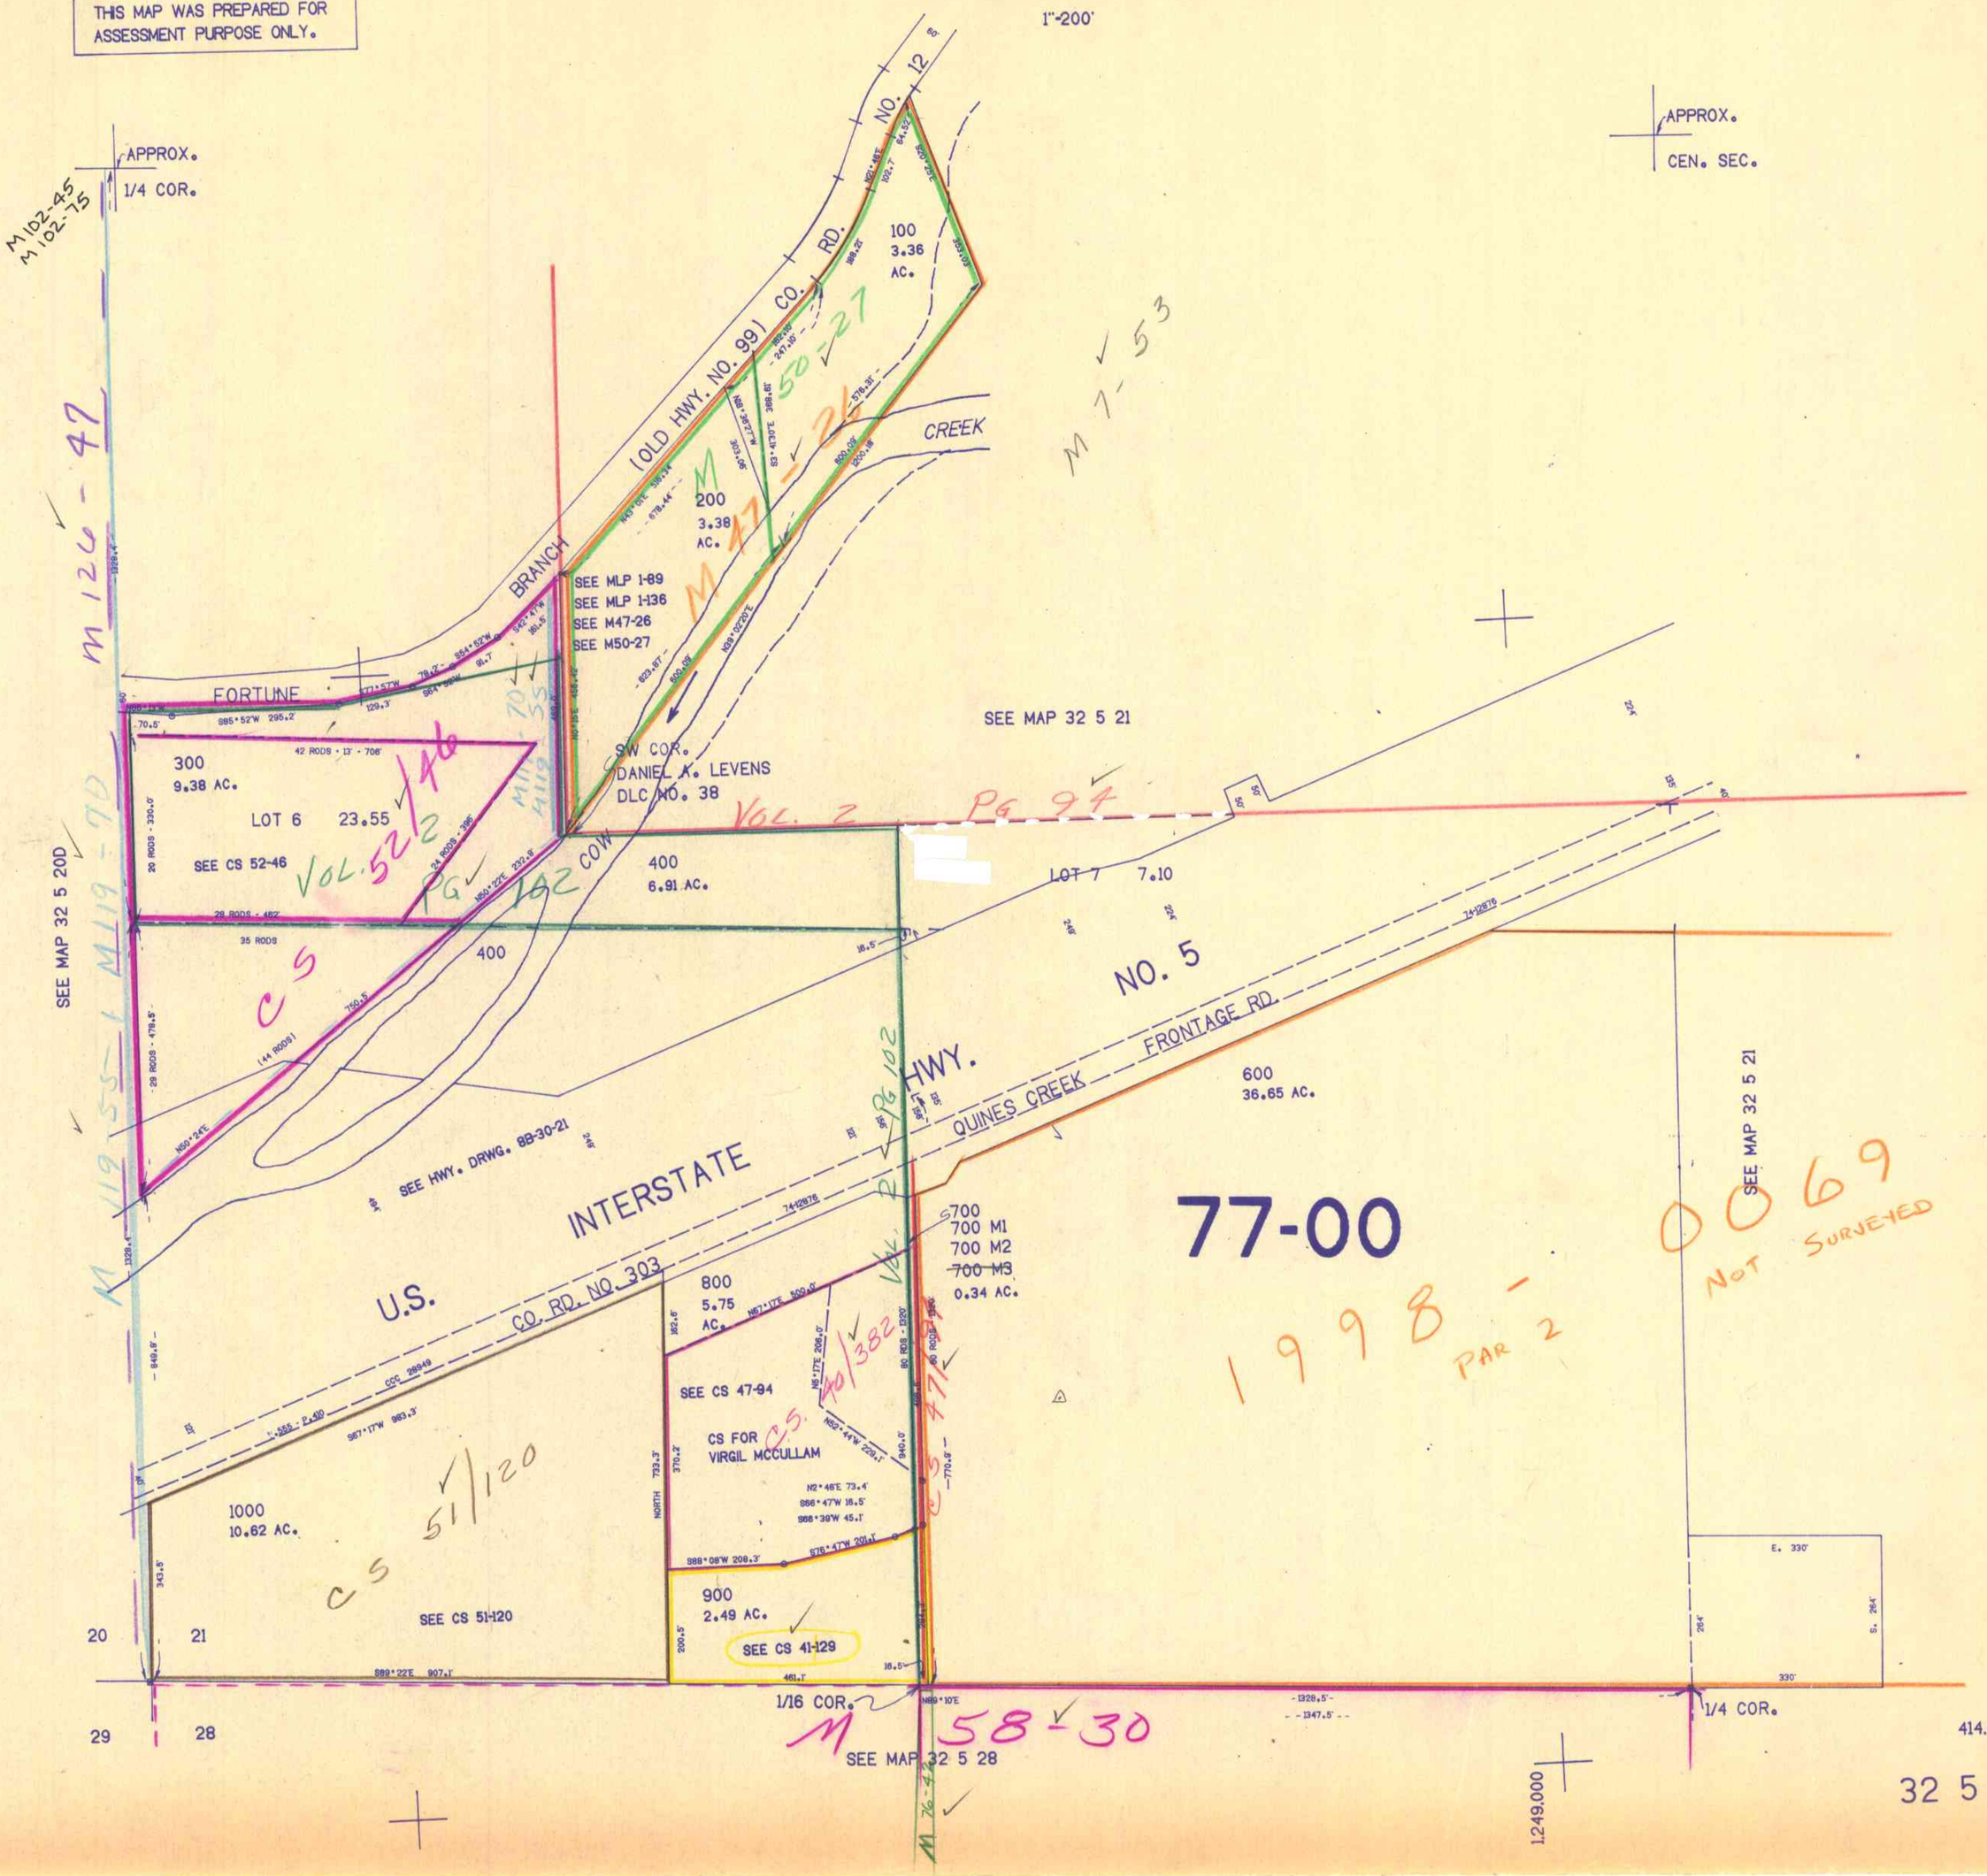
THIS MAP WAS PREPARED FOR ASSESSMENT PURPOSE ONLY.