

This map was prepared for assessment purposes only.

SECTION 4 T.32S. R. 6 W. W.M.
DOUGLAS COUNTY

32 6 4

1" = 400'
SEE MAP 31 6 33

APPROX. 1/4 COR. M 79-25

32 33 33 34

5	4	300 157.55 Ac.		100 100MI 78.23 Ac.	4			
	LOT 4	38.69	LOT 3	38.86	LOT 2	39.03	LOT 1	39.20

3 Cancelled ND's
100MI 200MI 400MI
200

ADD

Plat
0040
A.C.
M 90-67


77-00

SEE MAP 32 6
APPROX. 1/4 COR.

Partition

400mi.
400
400.00 Ac.

SEE MAP 32 6
APPROX. 1/4 COR.

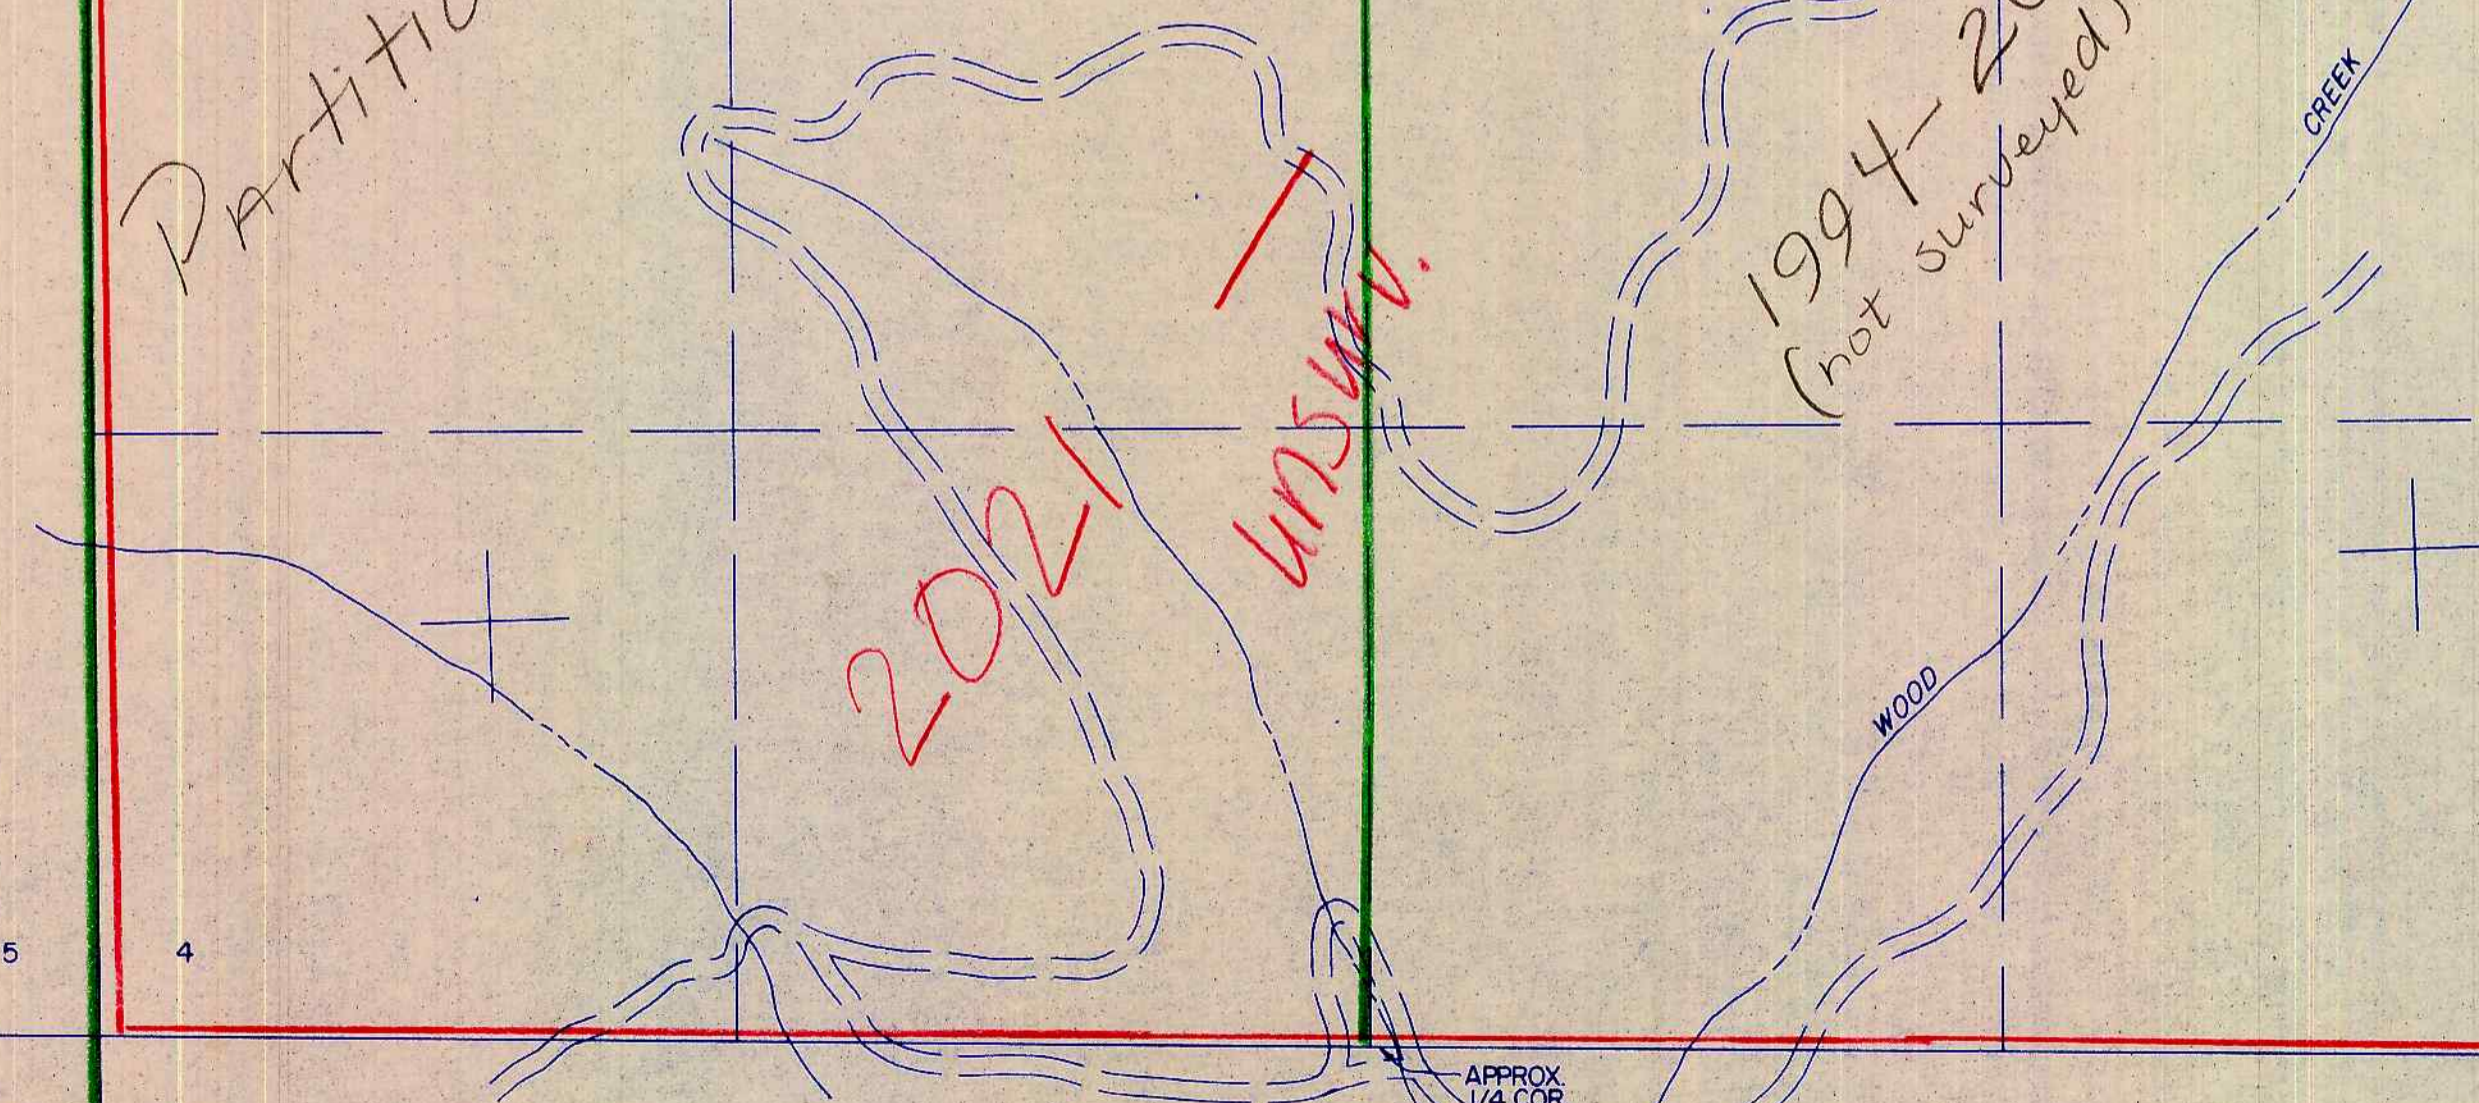

432,000

5	4				4	3
8	9				9	10

APPROX. 1/4 COR.
N 04° 45' W 79.65 CH. G.L.D.
SEE MAP 32 6

1,220,000

32 6 4

10/03