


SECTION 15 T.32S. R.6W. W.M.
DOUGLAS COUNTY

32 6 15

THIS MAP WAS PREPARED FOR
ASSESSMENT PURPOSE ONLY.

1"=400'

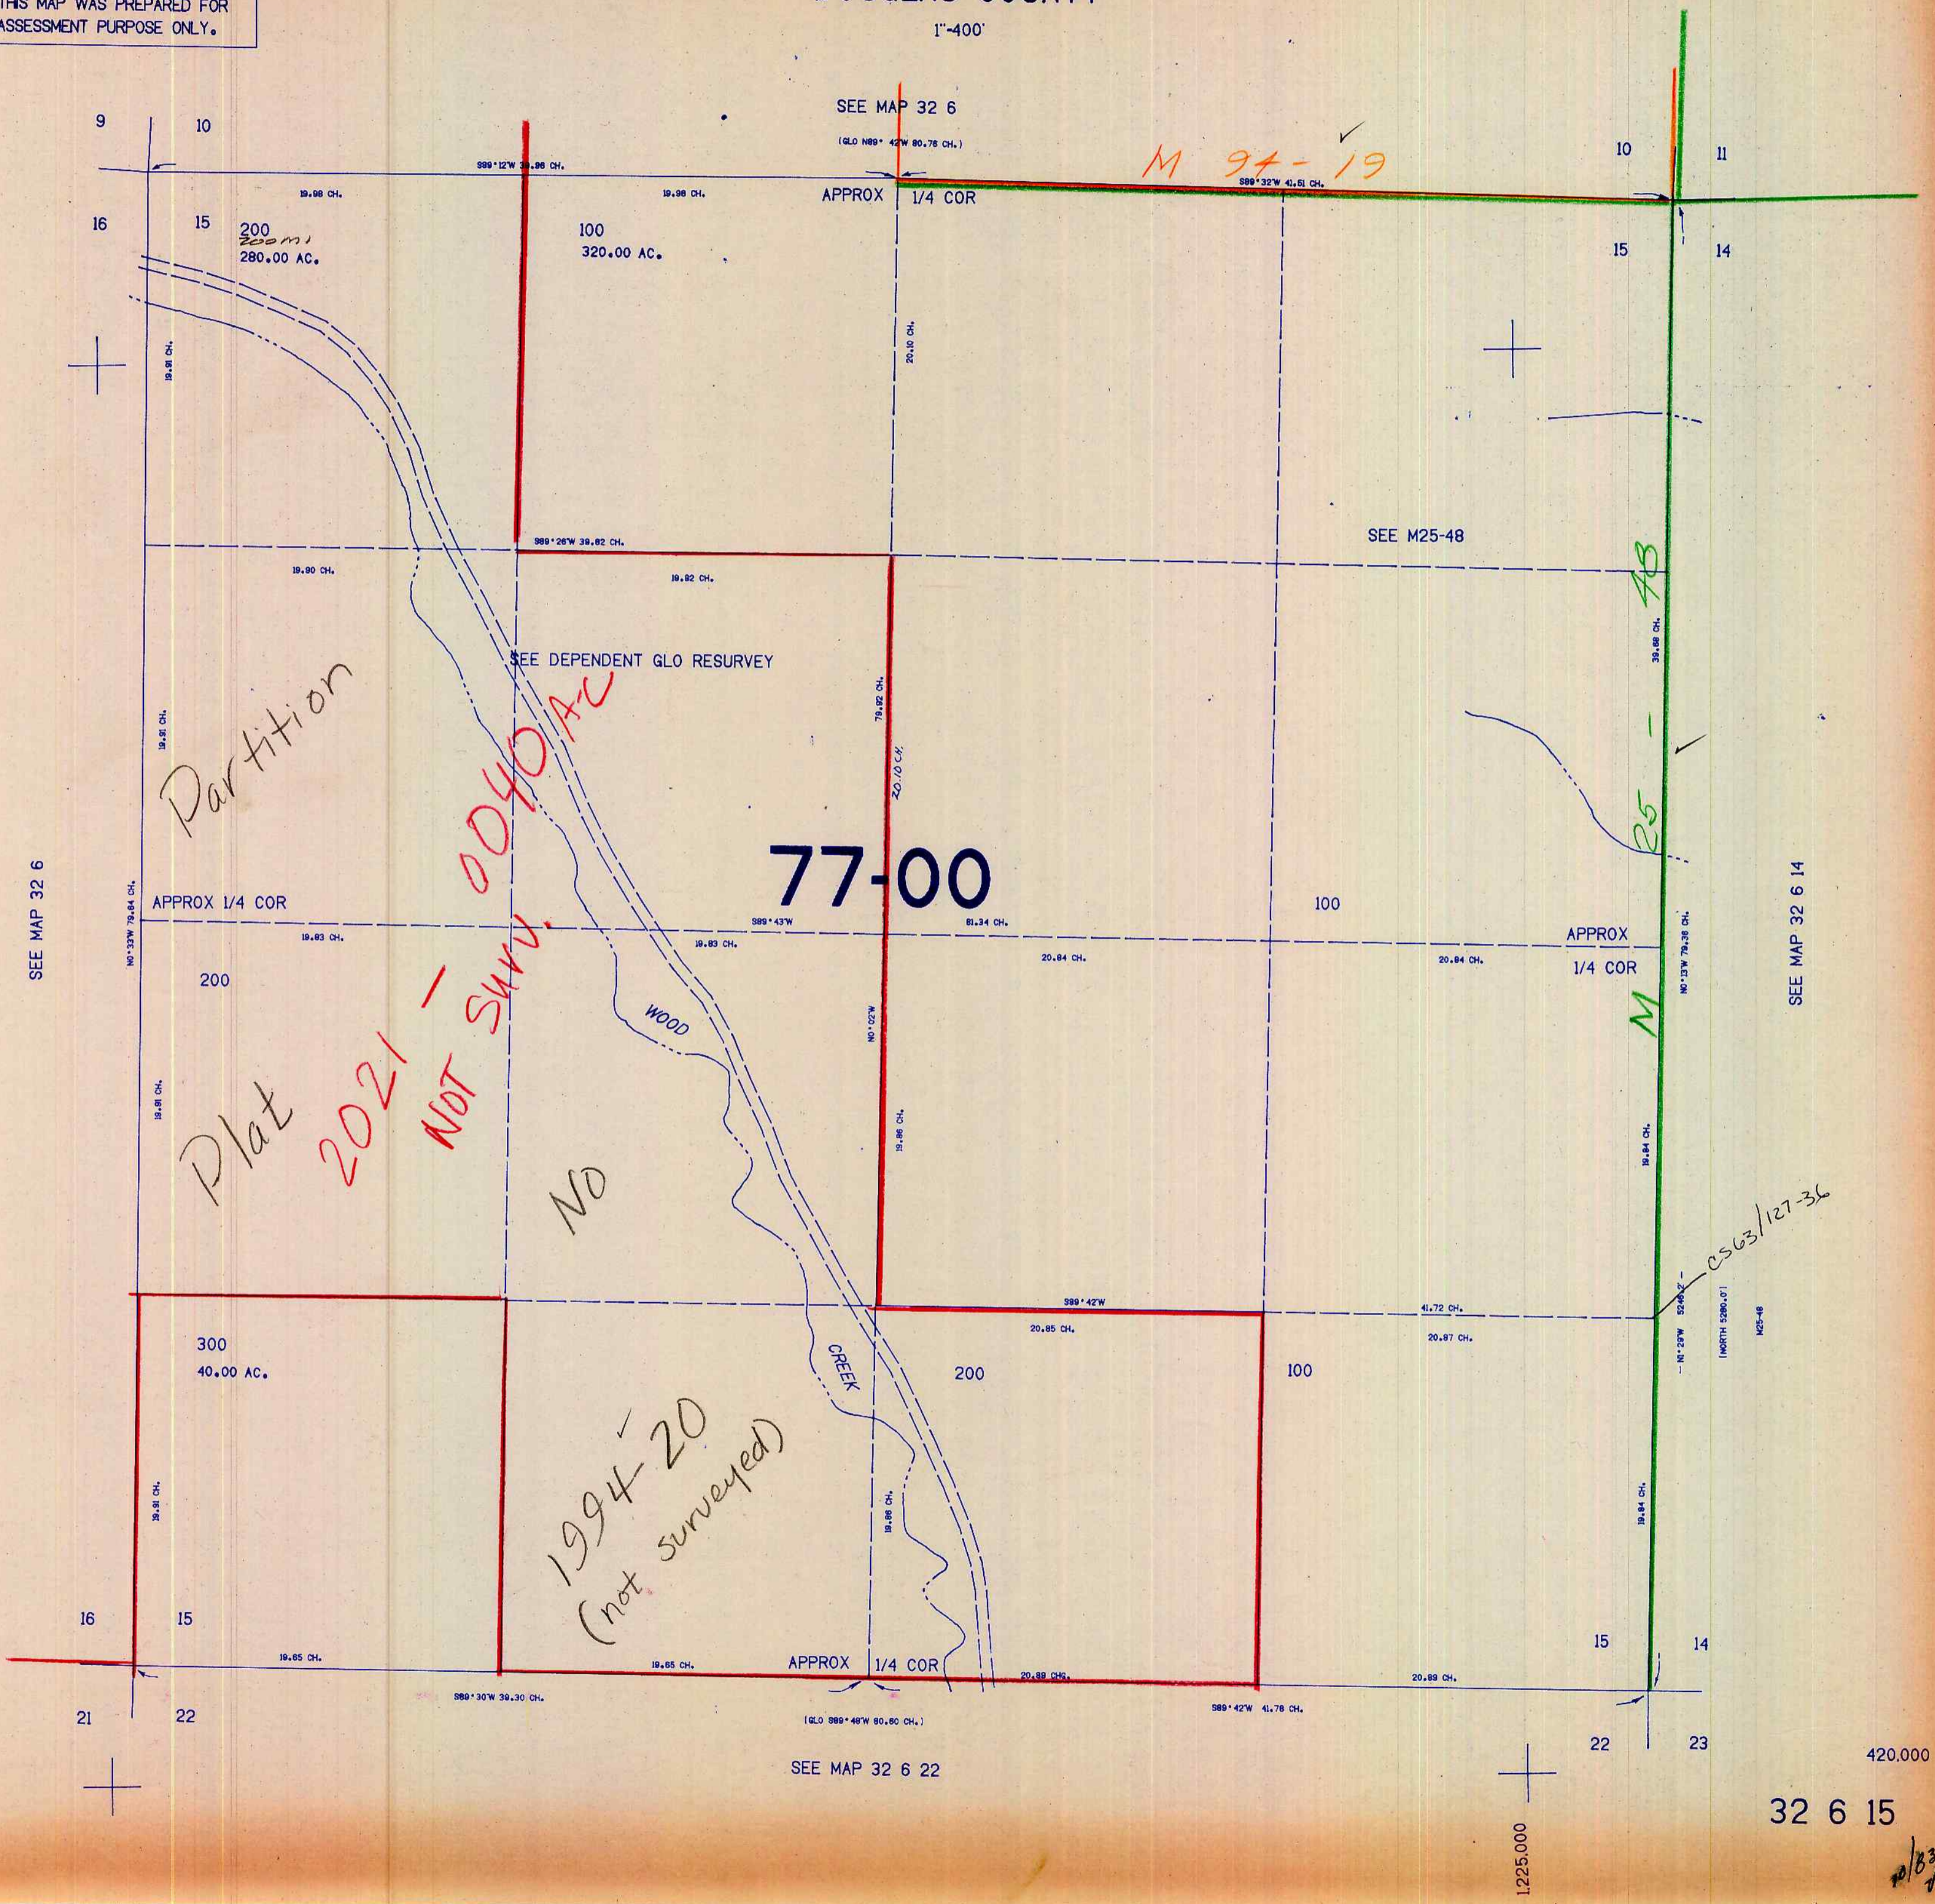

SEE MAP 32 6

SEE MAP 32 6

(GLO N89° 42'W 80.76 CH.)

APPROX 1/4 COR

M 94-19

200
280.00 AC.

100
320.00 AC.

SEE M25-48

SEE DEPENDENT GLO RESURVEY

77-00

APPROX 1/4 COR

100

APPROX 1/4 COR

200

19.81 CH.

19.81 CH.

Plat 2021 - NOT SURV.

NO

1994-20
(not surveyed)

M 25-48

M

CS63/127-36

(NORTH 52°00.0')

N25-48

19.84 CH.

19.84 CH.













SEE MAP 32 6 22

1,225,000

420,000

32 6 15

1/838