SW1/4 SE1/4 SEC.32 T.32S. R.6W. W.M.
DOUGLAS COUNTY

32 6 32DC
GLENDALE

1"=100'
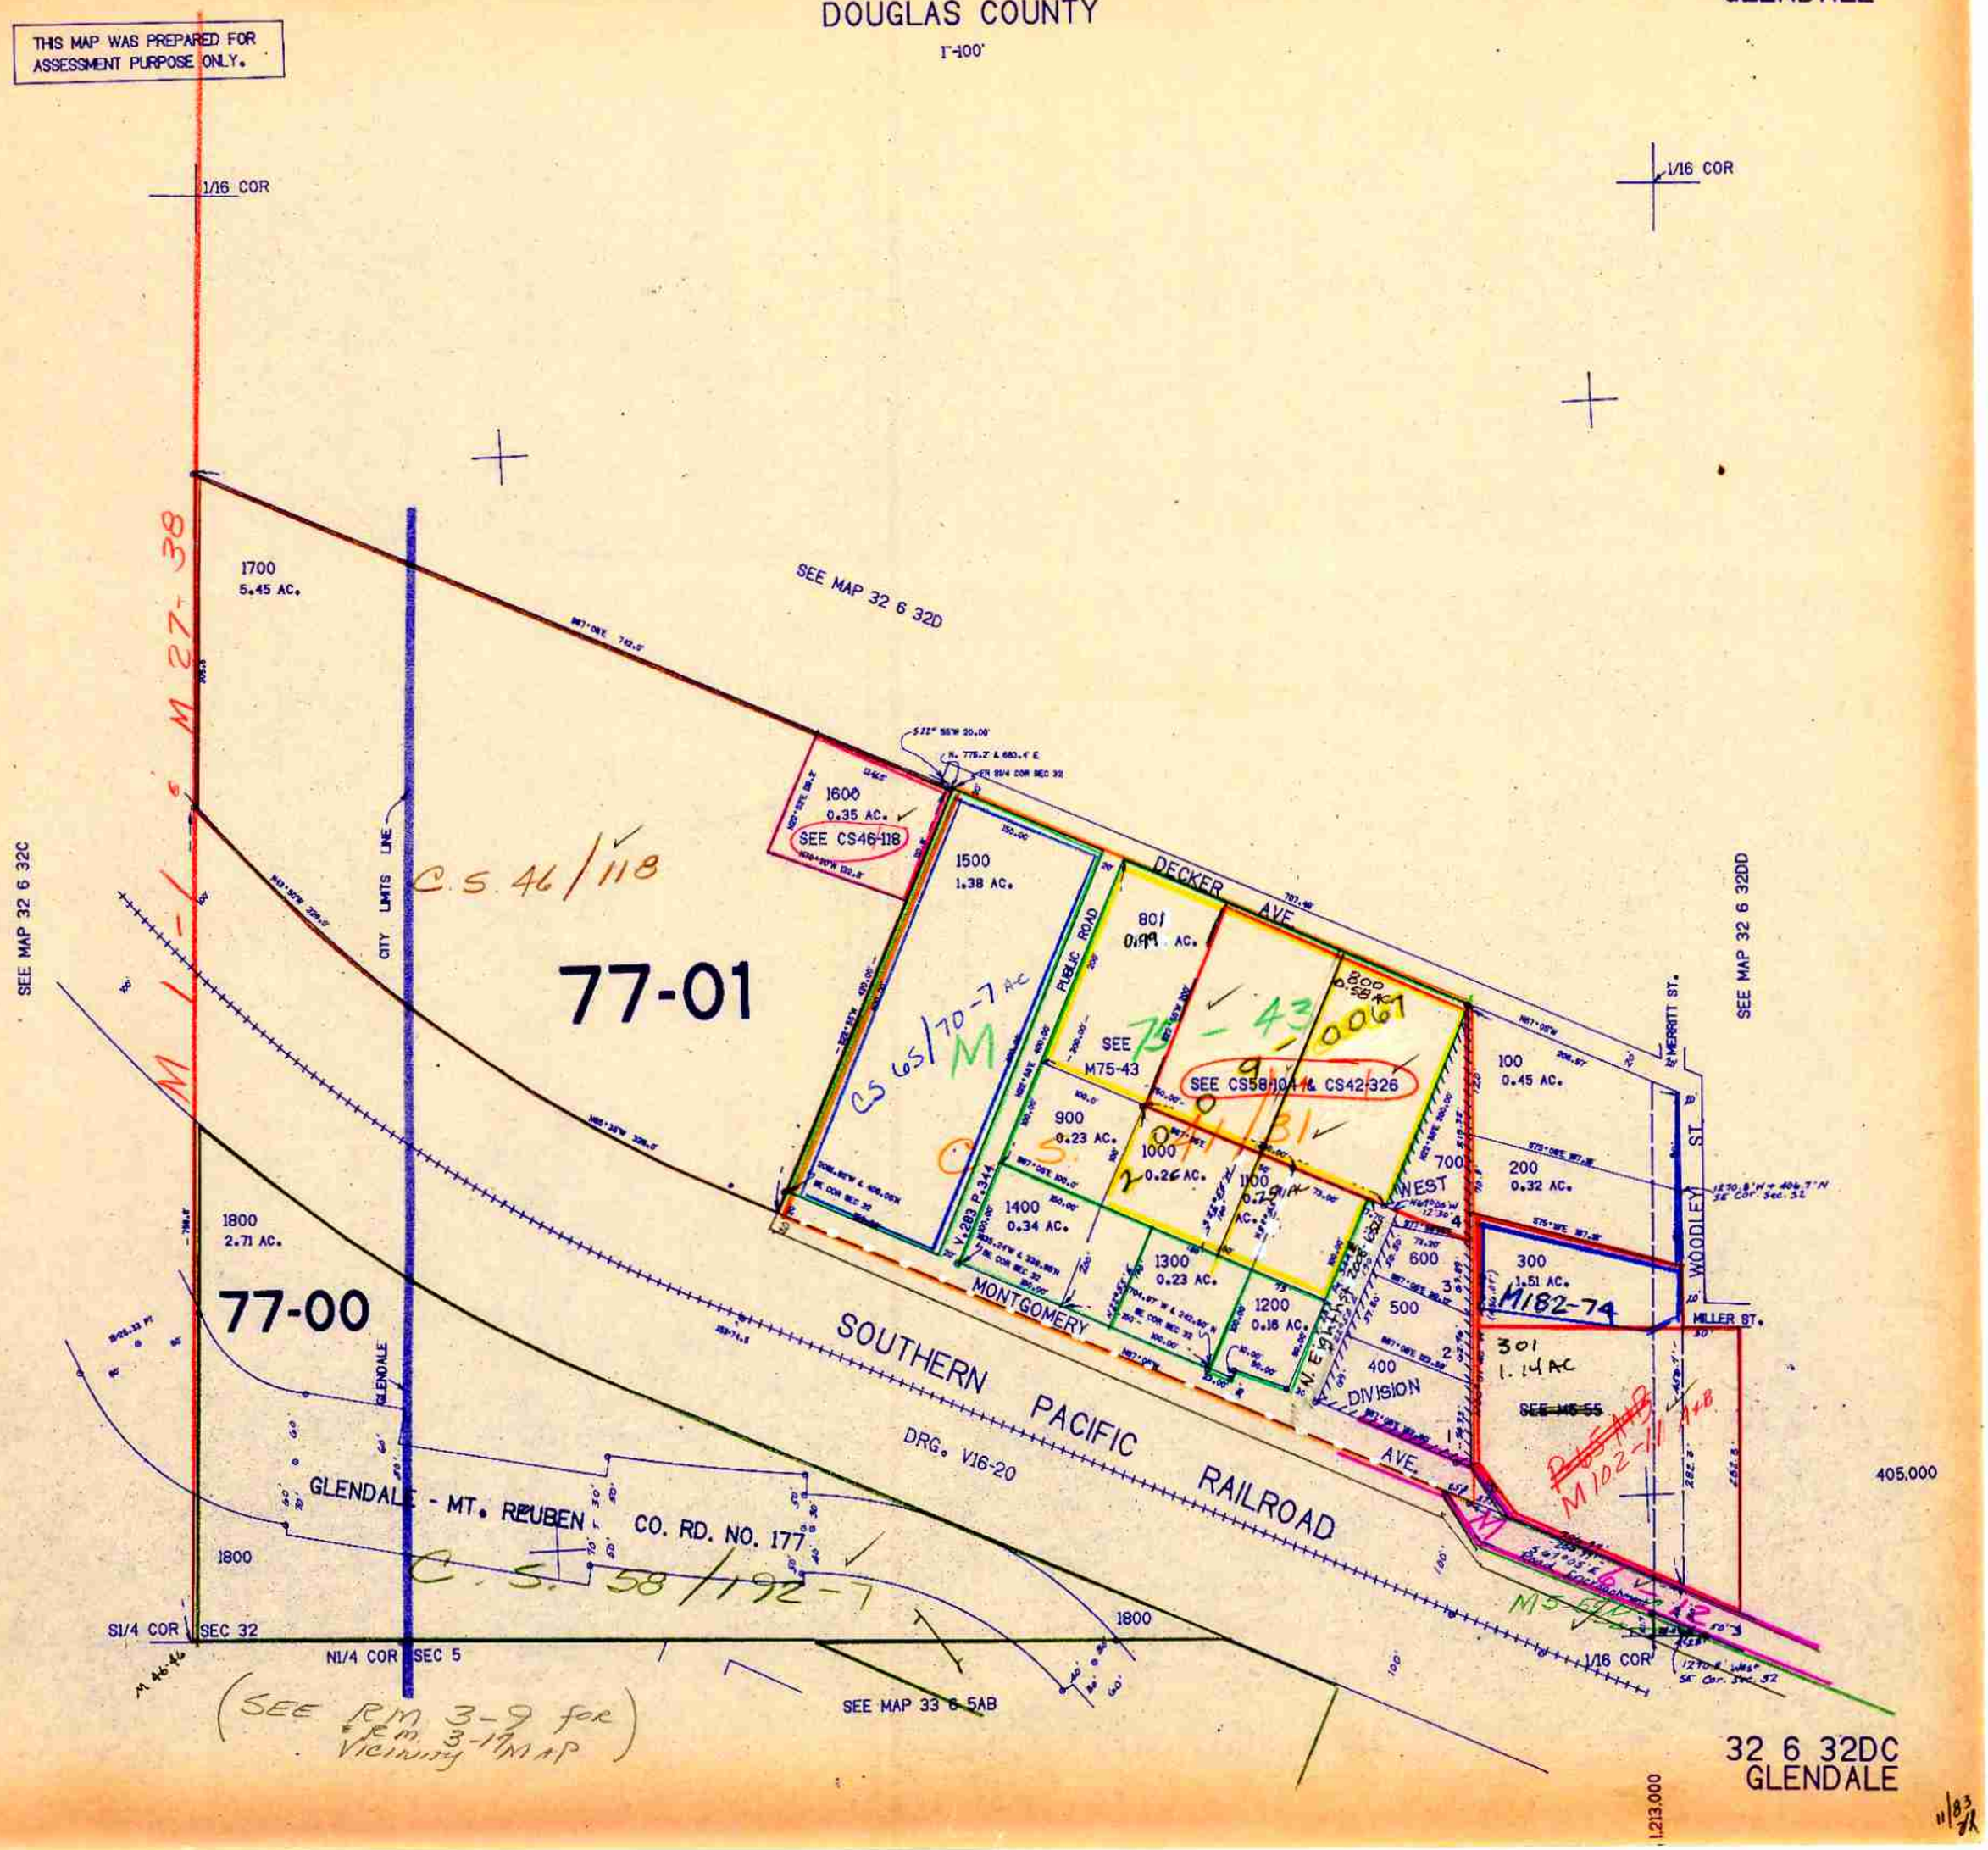
THIS MAP WAS PREPARED FOR ASSESSMENT PURPOSE ONLY.