SECTION 34 T.32S. R.6W. W.M.
DOUGLAS COUNTY

32 6 34
& INDEX

THIS MAP WAS PREPARED FOR ASSESSMENT PURPOSE ONLY.

1"=400'

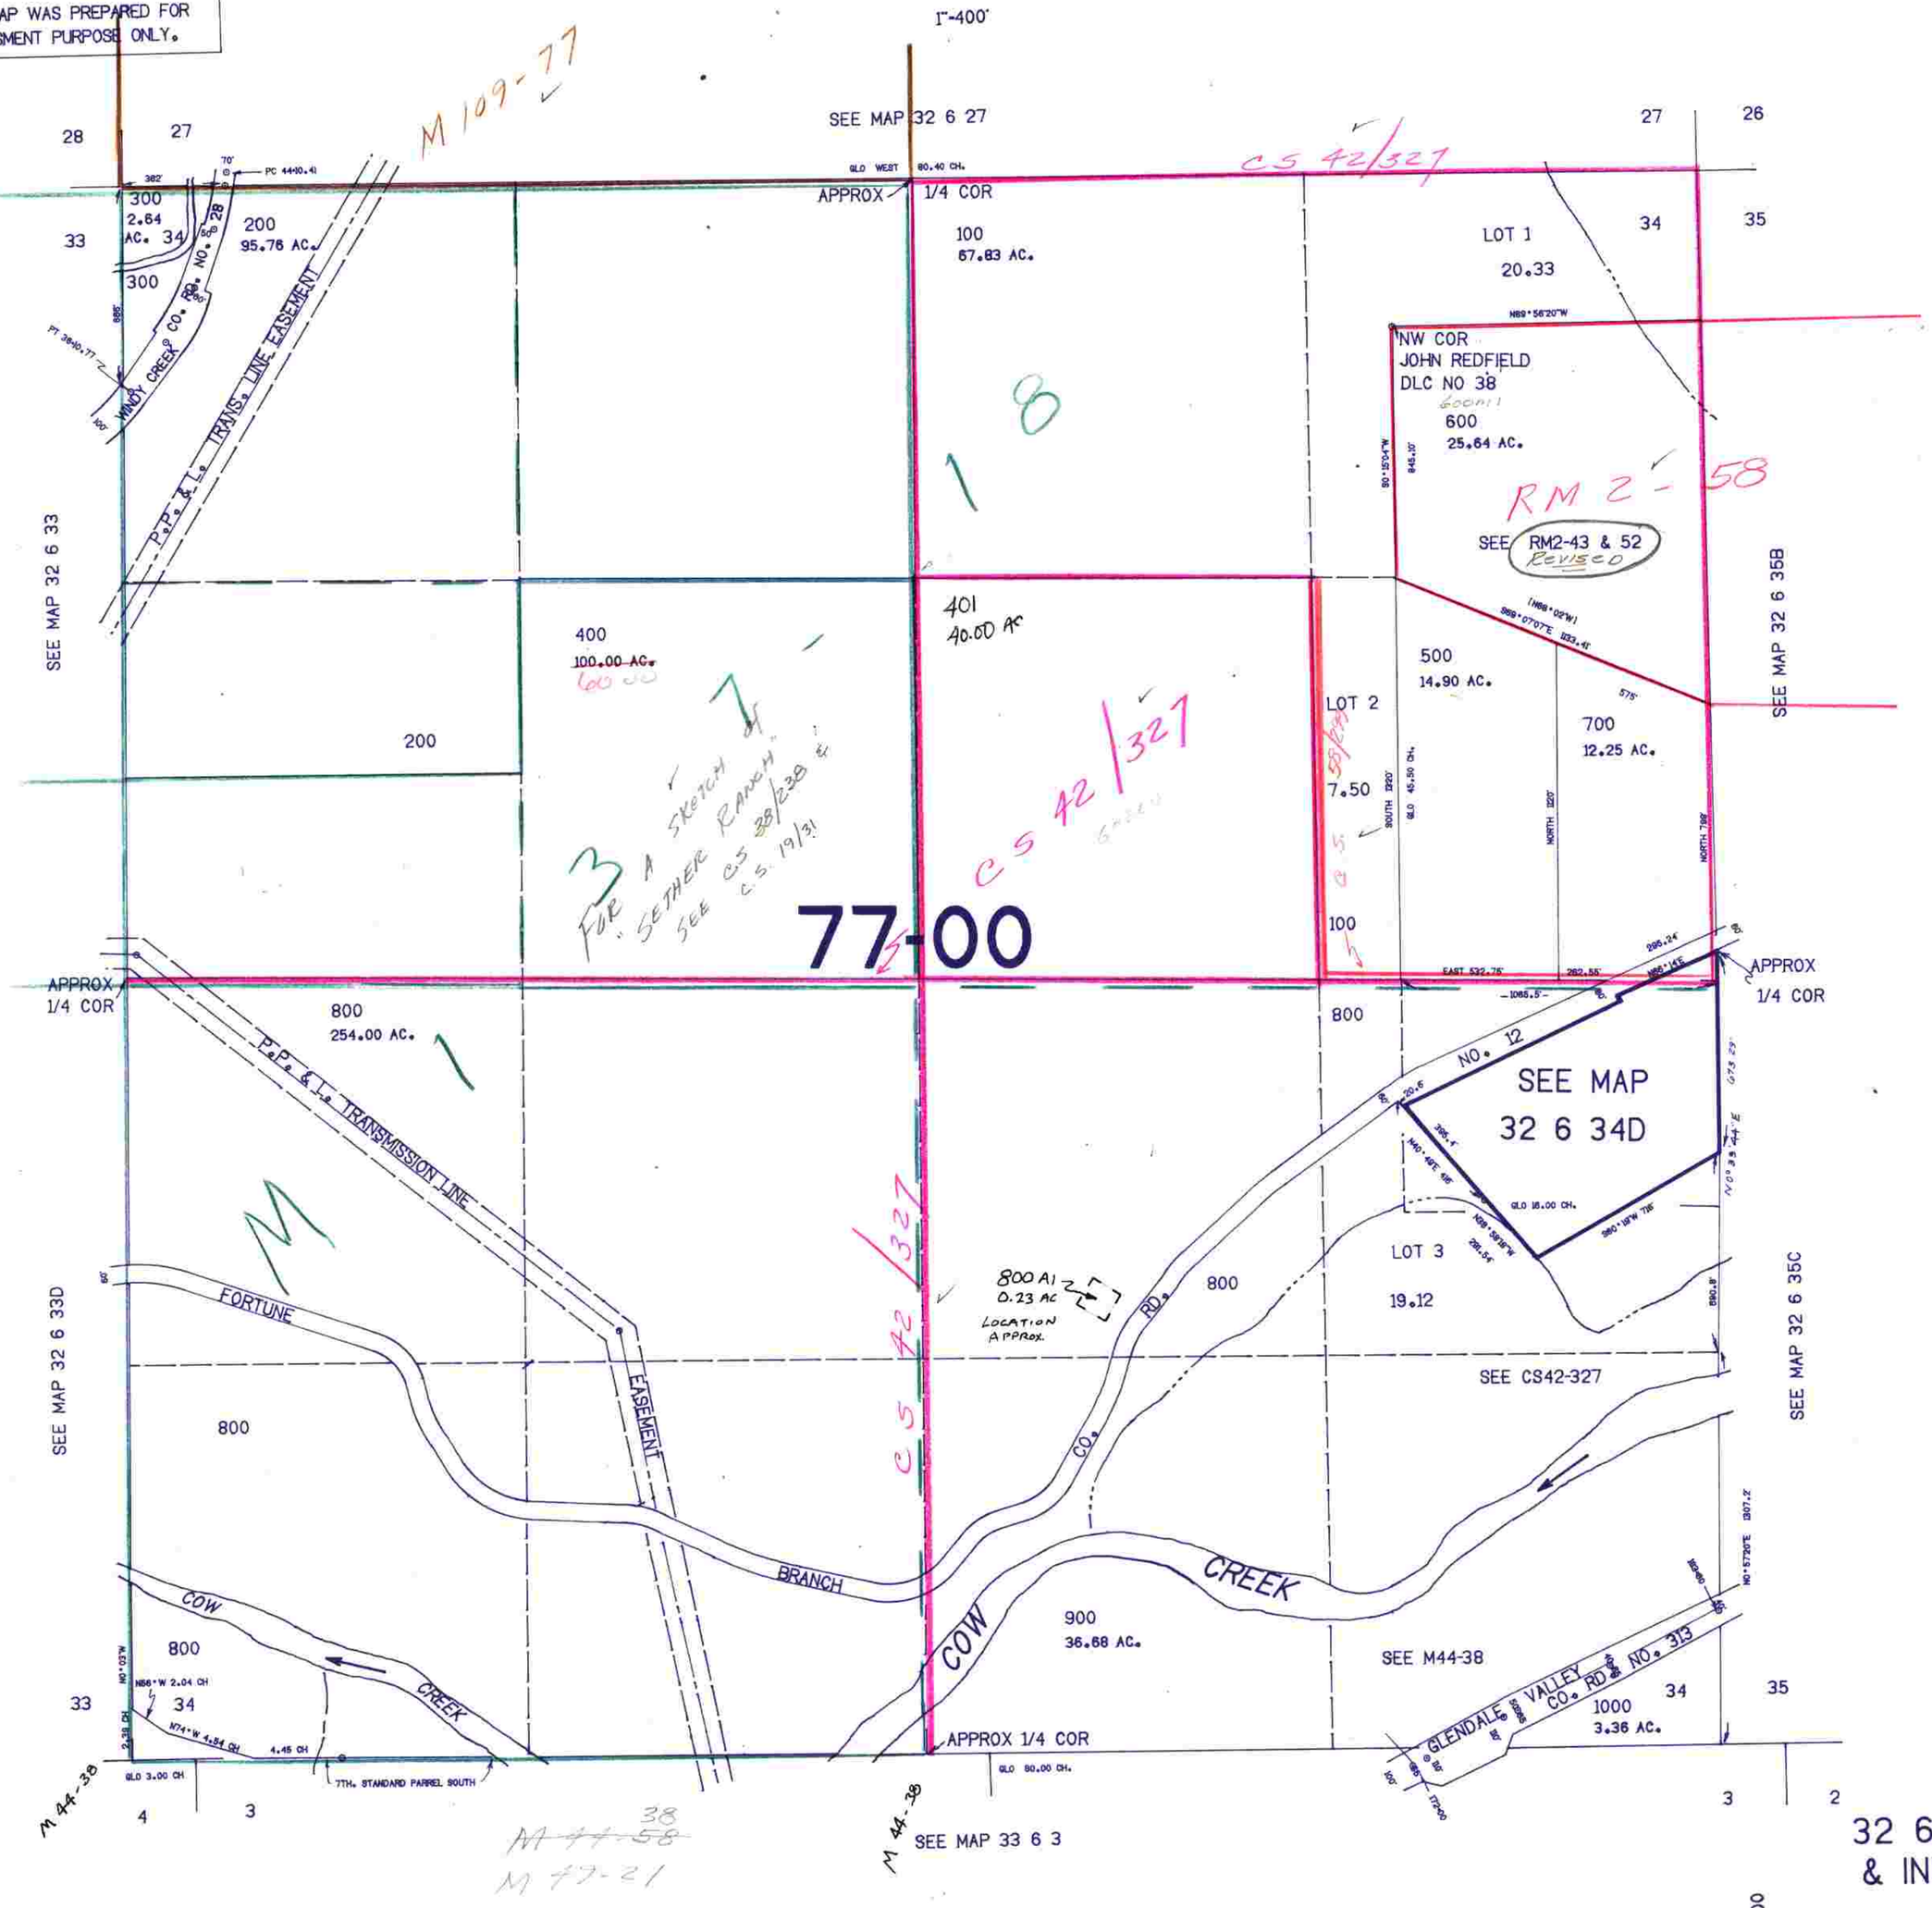

32 6 34
& INDEX