SECTION 5 T.33S. R.6W. W.M.
DOUGLAS COUNTY

33 6 5
& INDEX
GLENDALE

THIS MAP WAS PREPARED FOR ASSESSMENT PURPOSE ONLY.

1"=400'

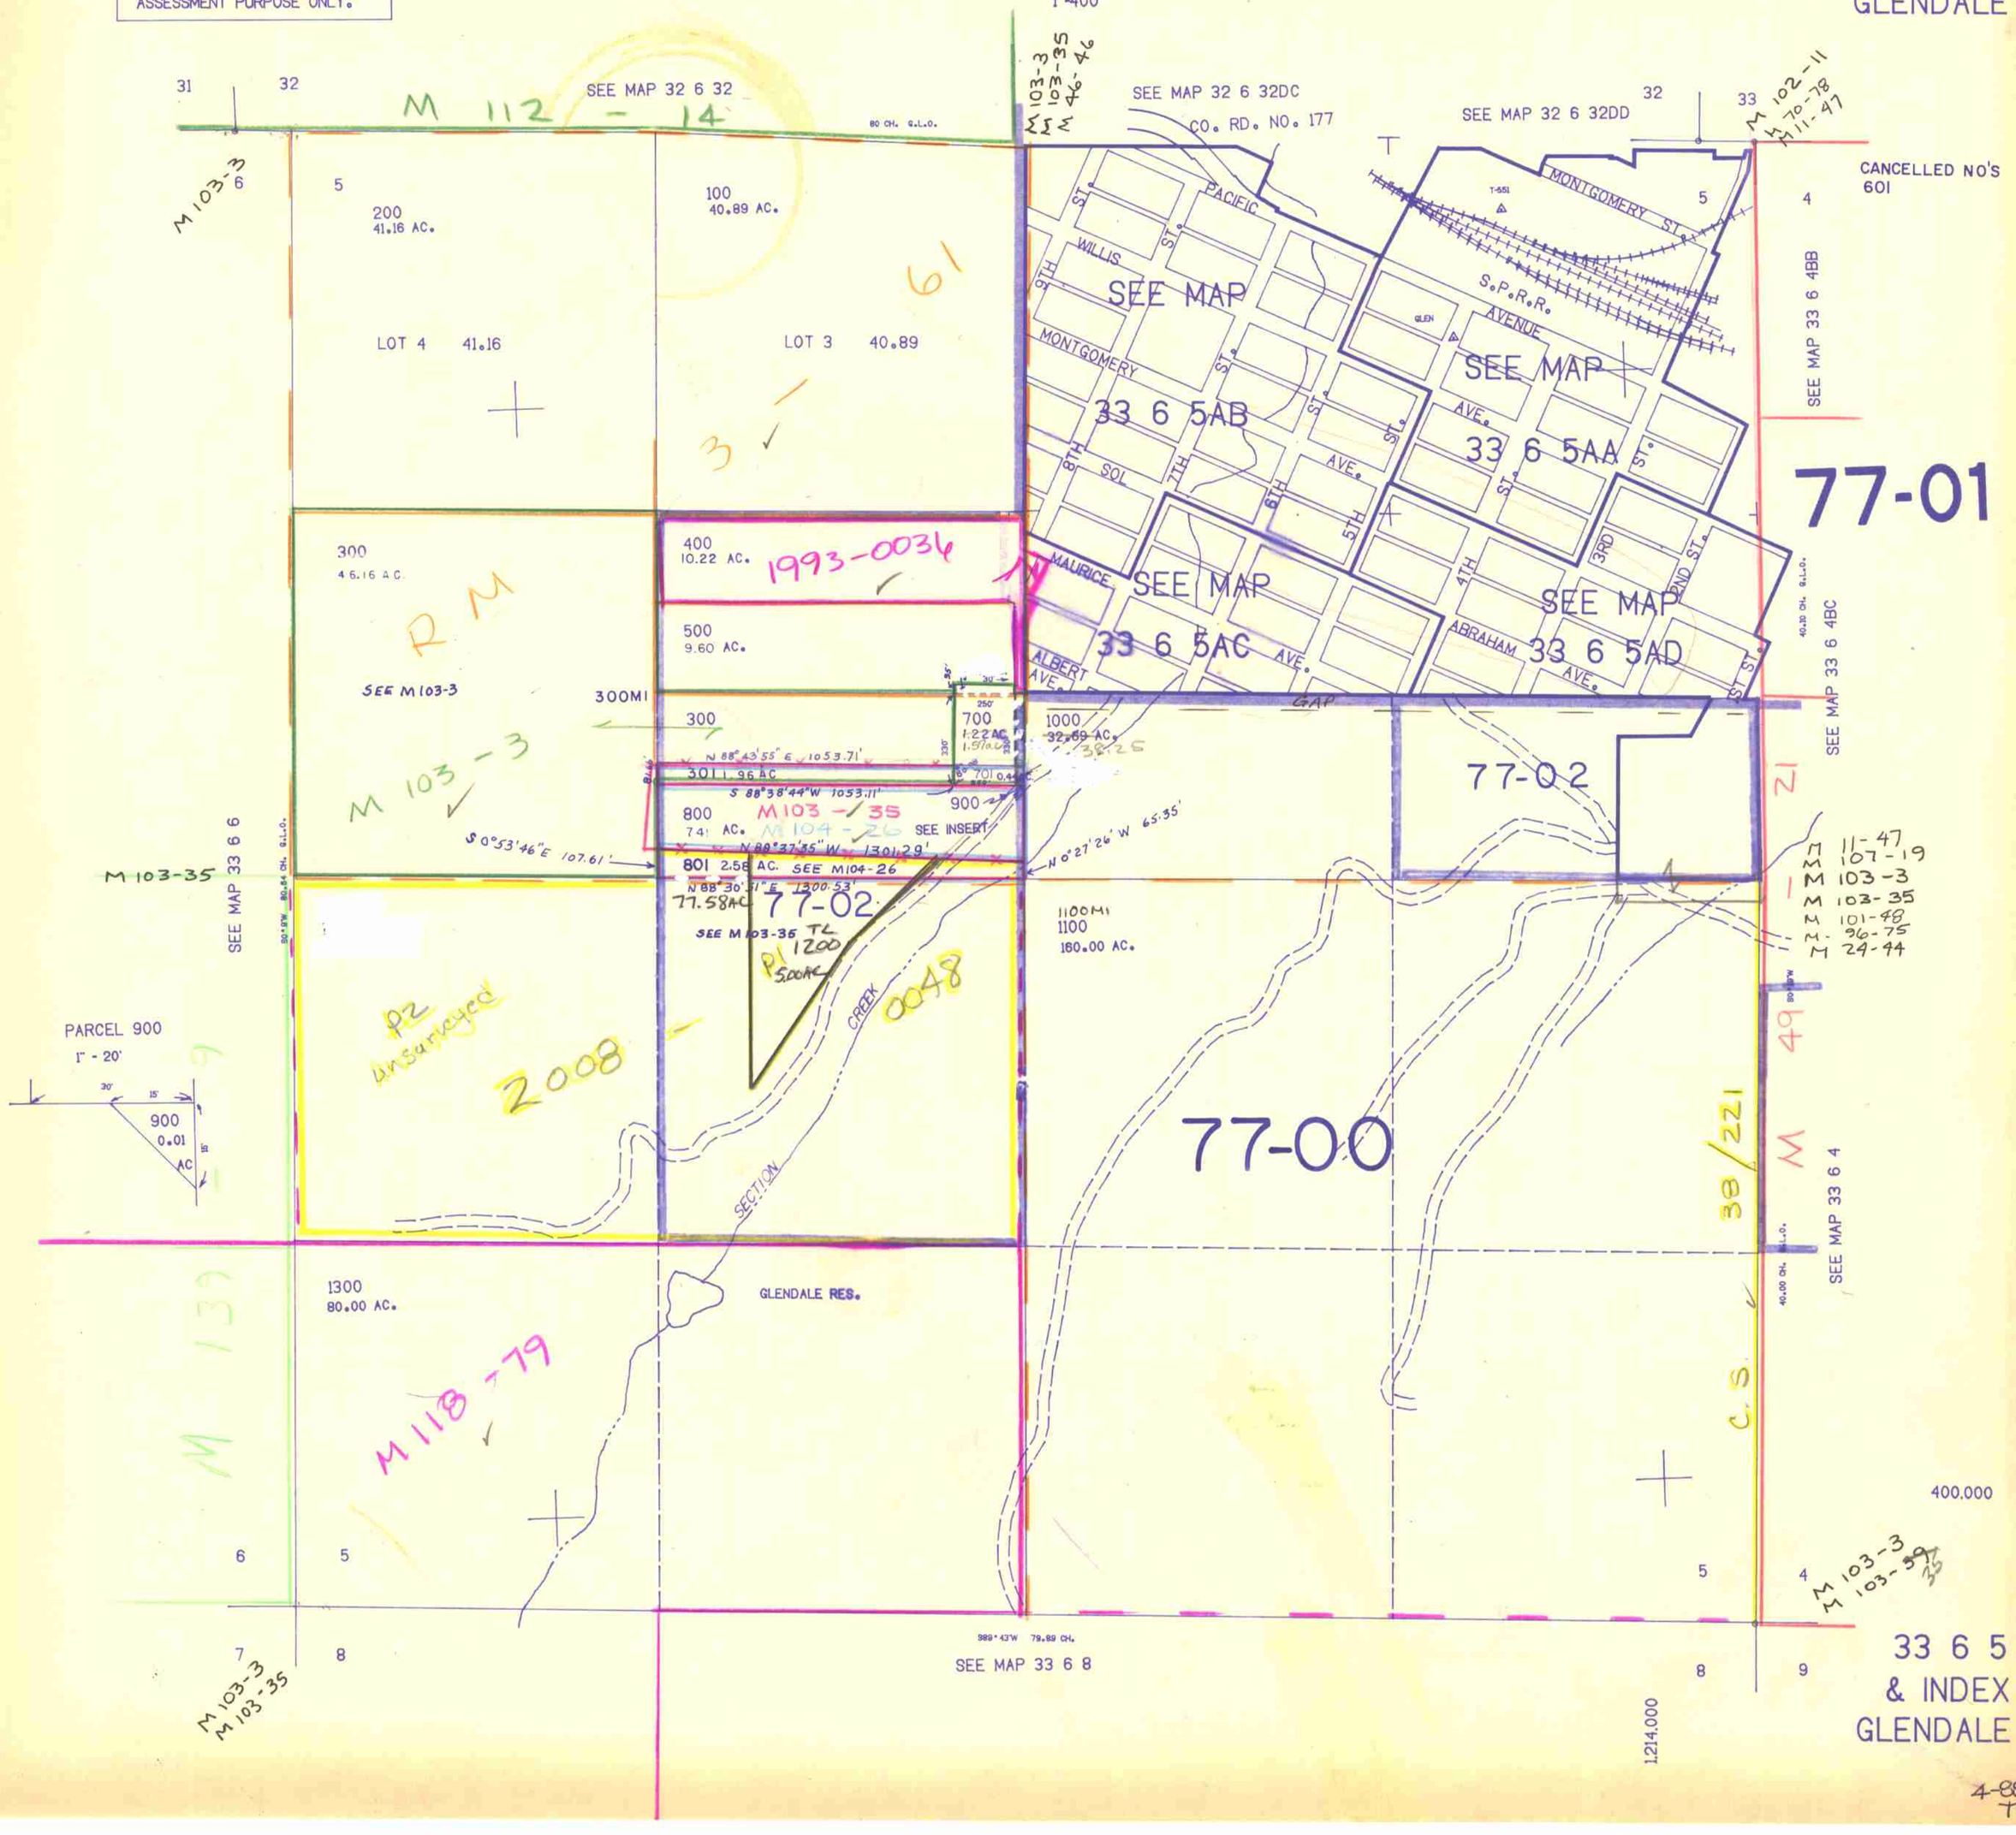

33 6 5
& INDEX
GLENDALE

4-88
TF