TOWNSHIP 22 RANGE 06 POINT IDENTIFIER # 043010

PRIMARY CORNER DESCRIPTION SW Cor. McGranary DLC #43

Alias _____ Description _____
Alias _____ Description _____
Alias _____ Description _____
Alias _____ Description _____

Surveys of Donation Land Claims by - Dennis Hathorn, Deputy, dated Sept. 1856

Set post SW cor. claim 43, from which
An Oak 18" dia., bears N.73°W., 200 lks.
NW Cor. Cl. 44 bears West 900 lks.

Wilford N. Haines - July 1961 - M 20-76

Found - Oak BT, N.73°W., 200 lks.
Set 1" x 1" x 36" T. Iron.
Found pipe for NW corner DLC #44, N.89°43'W., 589.7 ft.

Douglas Co. Surveyors Office - Randall W. Smith, Deputy - Stephen J. Flause - 12/6/1999 - C.S. File 66/13-4

Found - Haines T iron protruding 12" above ground. 1961
At intersection of partially down fence lines running west & north.
18" now 31" dia., W.Oak showing evidence of being previously opened, now healed blaze bears N.73°W., 132.0 ft. OBT.
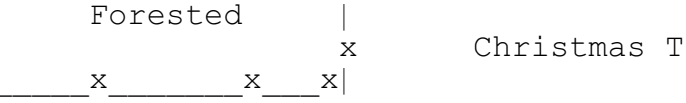
New BTs- 12" dia., W.Oak double blazed & scribed "SW DLC 43 CS BT" bears S.73°W., 33.0 ft.
9" dia., D.Fir double blazed & scribed "SW DLC 43 CS BT" bears N.36½°W., 32.2 ft.