TOWNSHIP 22 RANGE 06 POINT IDENTIFIER # 043020

PRIMARY CORNER DESCRIPTION SE Cor. Jas. McGranary's DLC 43

Alias _____ Description _____
Alias _____ Description _____
Alias _____ Description _____
Alias _____ Description _____

Surveys of Donation Land Claims by - Dennis Hathorn, Deputy, dated Sept. 1856

Set post, from which
An Oak, 10" dia., bears N.1°W., 643 lks.
An Oak, 24" dia., bears N.5½°E., 683 lks.

Douglas Co. Surveyors Office - Randall W. Smith, Deputy - Stephen J. Flause - 9/5/2001 - C.S. File 66/29-2

Found - 24" now 31" dia., 1½ ft. high rotted Oak stump with an old rotted blaze & a reverse scribe mark probably a portion of "B". Blaze & scribe mark found 12" from center of stump (orig. rec. N.5½°E., 450.8 ft.) OBT.

Orig. NW BT not found would fall near center of paved county road.

Set a 2 3/8" dia., brass cap on a 1 3/8" O.D. by 32" long iron pipe, at a position determined by orig. BT, protrude 2" above ground position of corner falls on a line projected westerly from bolt and rock, and rock at NE cor. DLC #44 shown as north line of DLC 44 on survey M 1-6 and M 29-52.

Brass cap marked: DOUGLAS COUNTY SURVEYORS
T22 | R
DLC 43 | 6
DLC 44 W
2001

New - 9" dia., W.Oak double blazed & scribed "SE DLC 43 CS BT" bears N.88½°E., 1.5 ft.

1917 Bolt along North edge of stone, 2" below ground bears East, 25.9 ft.

1917 stone with "+" on top NE corner DLC 43, bears East, 384.0 ft.
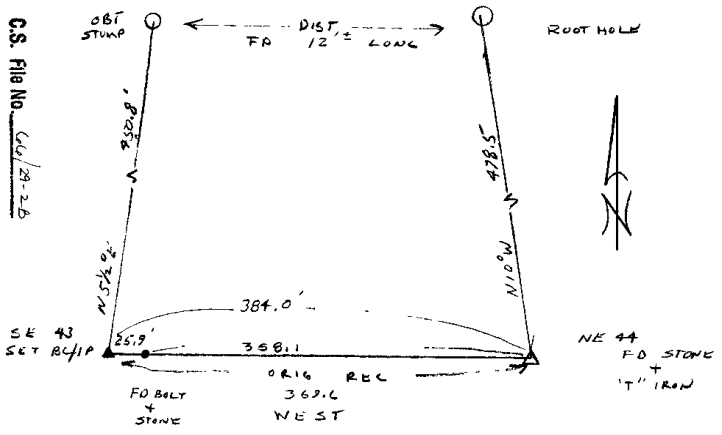
W. Oak 15" dia., blazed & double "SE DLC 43 C S BT" bears S.55½°W., 39.5 ft. decl. Compass 17½°E.