Replaces
41
&
42

# T 24 S R 2 W

1" = 2000'
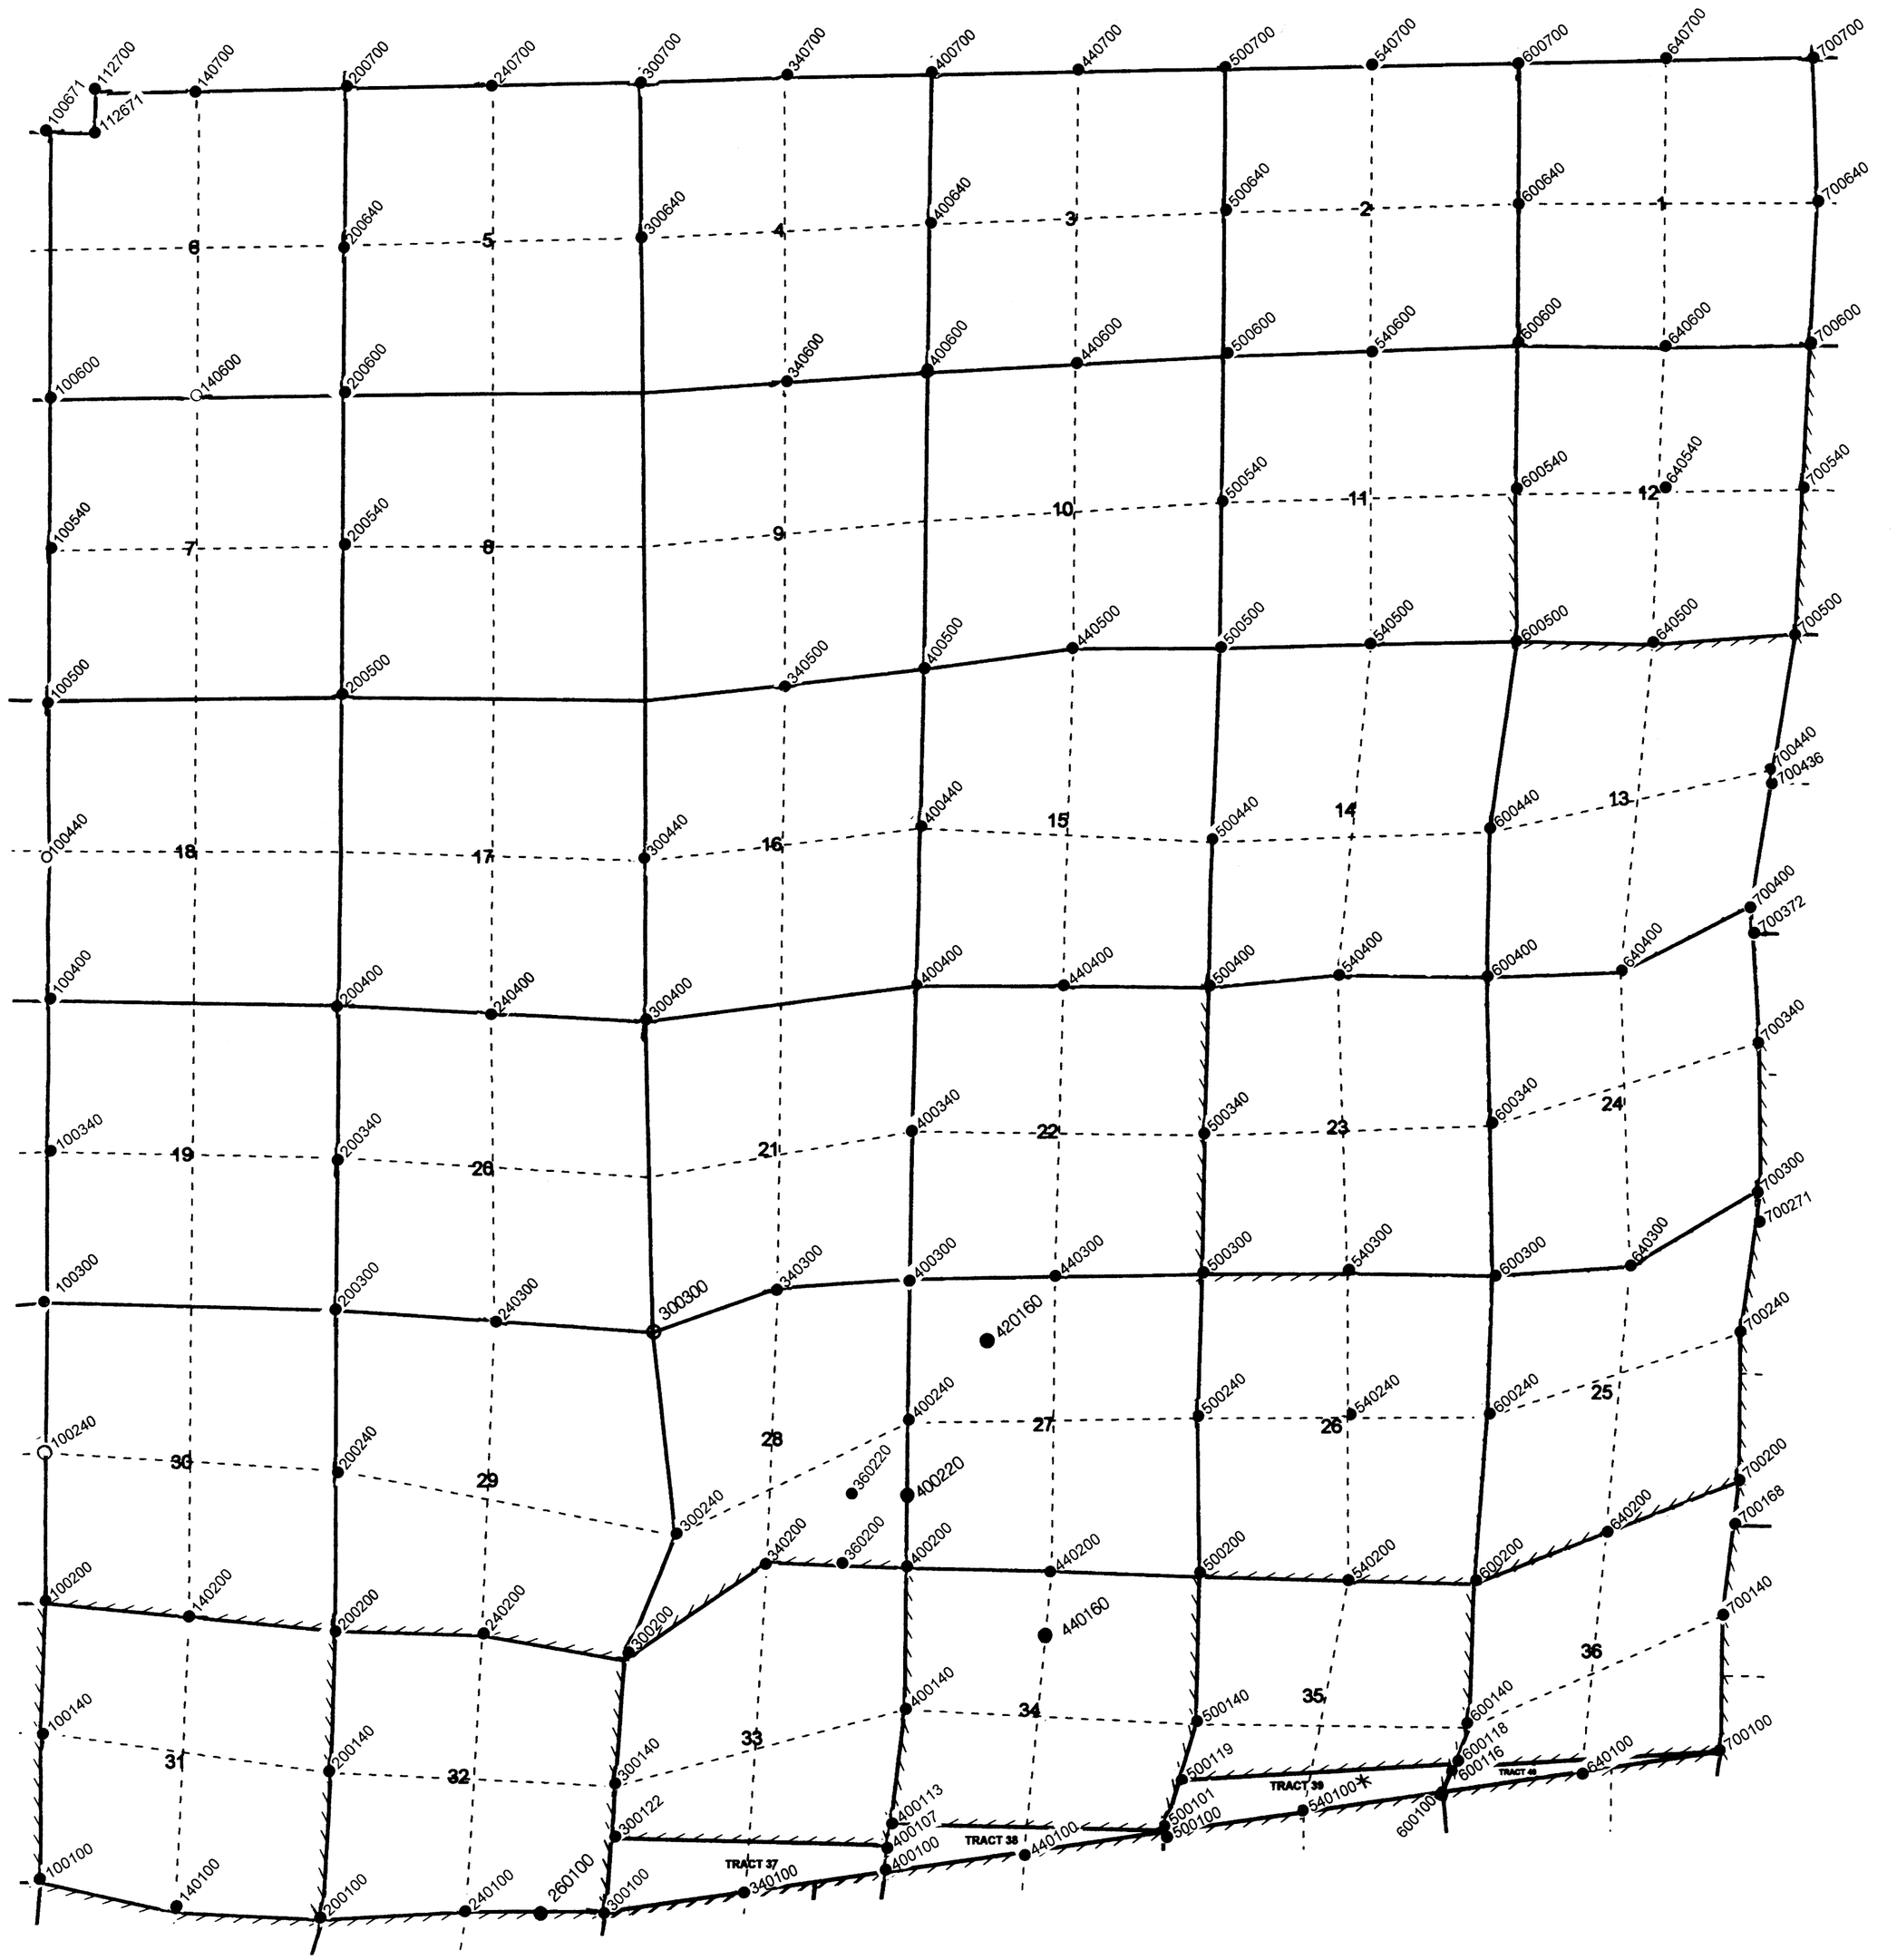
BLM RESURVEYS
CORNERS RENEWED OR ESTABLISHED
CORNERS FOUND AND USED
CORNERS LOOKED FOR AND NOT FOUND
COUNTY BOUNDARY
CORNER RENEWED - LAST REPORT NOT FD