

Alias \_\_\_\_\_ Description \_\_\_\_\_  
Alias \_\_\_\_\_ Description \_\_\_\_\_  
Alias \_\_\_\_\_ Description \_\_\_\_\_  
Alias \_\_\_\_\_ Description \_\_\_\_\_

GLO survey by Charles L. Campbell, Deputy Surveyor, under Contract #747,, dated May 5,1902 - (DCSO records Vol. 10 Page(s) 3960)


-----  
Set sandstone 36x24x8 ins., 27" in the ground for ¼ sec. cor. mkd. ¼ on the W. face, from which  
A Fir 38" dia., bears S.45½°W., 54 lks. dist. mkd. ¼ S19 BT.  
A Fir 40" dia., bears N.10 ¾°W., 11 lks. dist. mkd. ¼ S24 BT

GLO survey by Morris Wygant, compassman for Zachariah M. Derrick, U.S. Deputy Surveyor, under Contract #779, dated Feb. 7, 1908 - (DCSO records Vol. 10 Page(s) 3968)

-----  
Intersect the ¼ sec. cor. bet. secs. 19 and 24, which is a sandstone, firmly set, mkd. and witnessed as described by the Surveyor General, and which I now change to refer to sec. 24, T25S R9W only.

Douglas County Surveyors Office - Vernon "Ray" Tracy and crew May 21, 1969 - C.S. File 54/72-45

-----  
Found - Orig. 40" now 58" Fir, N.10 ¾°W., 7.3 ft., now stump. Shows BT scribe.  
No trace other OBT or Cor. stone called for ¼ cor. Falls on sandstone outcrop 8'x10'x 6' high in area of many sandstone outcrops and boulders.  
At Cor. point drill rock and Set Brass cap in concrete 7"x7"x3" high, mkd. County Surveyors Office 1969

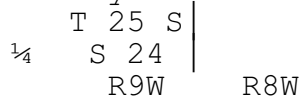

No trees available for BTs.  
New accessories:  
5/8" Iron rod, S.87°W., 16.4 ft.  
5/8" Iron rod, N.29°W., 7.8 ft. alongside OBT stump.  
Weyerhaeuser reference, 40" Hemlock S.85°E., 44.2 ft. "W" nail and tag, this tree across creek on very steep slope.  
Creek bears East 25.0 ft.

BLM Resurvey by James E. Jelley and Jack W. Bowder, Cadastral Surveyors, under Group #767, Surveyed April/May 1972 - (DCSO records Vol. 36 Page(s) 15036)

-----  
The ¼ sec. cor., perpetuated and recorded by Tracy in 1969, (Cont. Next Page)

TOWNSHIP 25 RANGE 08 POINT IDENTIFIER # 100333

PRIMARY CORNER DESCRIPTION East 1/4 Cor. for Sec. 24 only, T25-9

Alias _____	Description _____
Alias _____	Description _____
Alias _____	Description _____
Alias _____	Description _____

monumented with a brass cap seated in a concrete column, 7 x 7 x 3" high, atop a sandstone outcrop 10 x 8 x 5 ft. high, with brass cap as mkd. in 1969,

from which the remains of the original bearing trees

A sawed Fir stump 48" dia., bears N.10 3/4°W., 14½ lks. dist., with fragmentary scribe marks visible on open blaze. (Rec. 11 lks.)

and reference monuments set by Tracy

An Iron rod 5/8" dia., bears S.87°W., 25 lks. dist., firmly set, projecting 4" above ground.

An Iron rod 5/8" dia., bears N.29°W., 12 lks. dist., firmly set projecting 2" above ground.

and a bearing tree of which I have no record

A sawed Fir stump 40" dia., bears S.85°E., 71 lks. dist., with galv. nail with "W" embossed on head, driven into base.

No other suitable trees available within limits.

Corner falls 35 lks. W. of creek, 5 lks. wide, course S.5°W.