TOWNSHIP 28 RANGE 01 POINT IDENTIFIER # 600600

PRIMARY CORNER DESCRIPTION Cor. Secs. 1, 2, 11, & 12

Alias _____ Description _____
Alias _____ Description _____
Alias _____ Description _____
Alias _____ Description _____

GLO resurvey by Homer D. Angell, Deputy Surveyor, under contract #746, dated May 5, 1902 - (DCSO records Vol. 13 Page(s) 5380)

Set a basalt stone 12x12x7", 8" in the ground for cor. of secs. 1, 2, 11, & 12 mkd with 5 notches on S & 1 notch on E edges, from which

A fir, 16" dia. bears N.55°E., 41 lks. mkd: T28S R1W S1 BT
A fir, 16" dia. bears S.20°E., 55 lks mkd: T28S R1W S12 BT
A fir, 10" dia. bears S.35°W., 76 lks mkd: T28S R1W S11 BT
A fir, 16" dia. bears N.15°W., 41 lks. mkd: T28S R1W S2 BT

Douglas Co. Surveyors Office - Vernon "Ray" Tracy - Vincent Perron - 7/21/1970 - C.S. File 54/94-106

Reference section corner to secs. 1, 2, 11, & 12

Found - Corner stone with 1 notch on E & 5 notches on S.
Orig. 16", now 20" Fir, alive, N.55°E., 27.1 ft. shows good scar.
Orig. 16", now 20" Fir, snag, S.20°E., 36.3 ft. shows good scar.
Orig. 16", now 20" Fir, dying, N.15°W., 27.1 ft. shows good scar.
Corner point & orig. BTs will be destroyed by new road to be built.

From true corner, we go N.37°W., 91.6 ft. & set:

Set - Brass cap for ref. monument #1 mkd:

COUNTY SURVEYORS OFFICE 1970 RM #1 ↘ T28S R1W

S 2	S 3
S 11	S 12

New BTs- 9" D.Fir N.38°E., 13.4 ft. mkd: "RM 1 CS BT"
14" D.Fir N.37°W., 20.3 ft. mkd: "RM 1 CS BT"
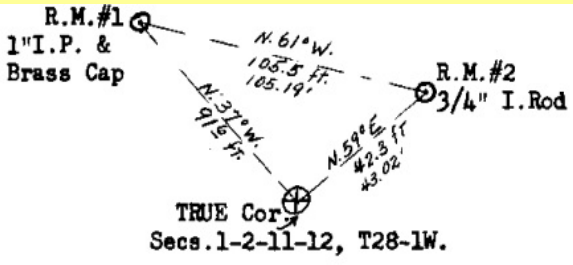
From true corner we go N.59°E., 42.3 ft. & set ¾" I.Rod for reference monument #2, See diagram