T 28 S R 5 W

1" = 2000'
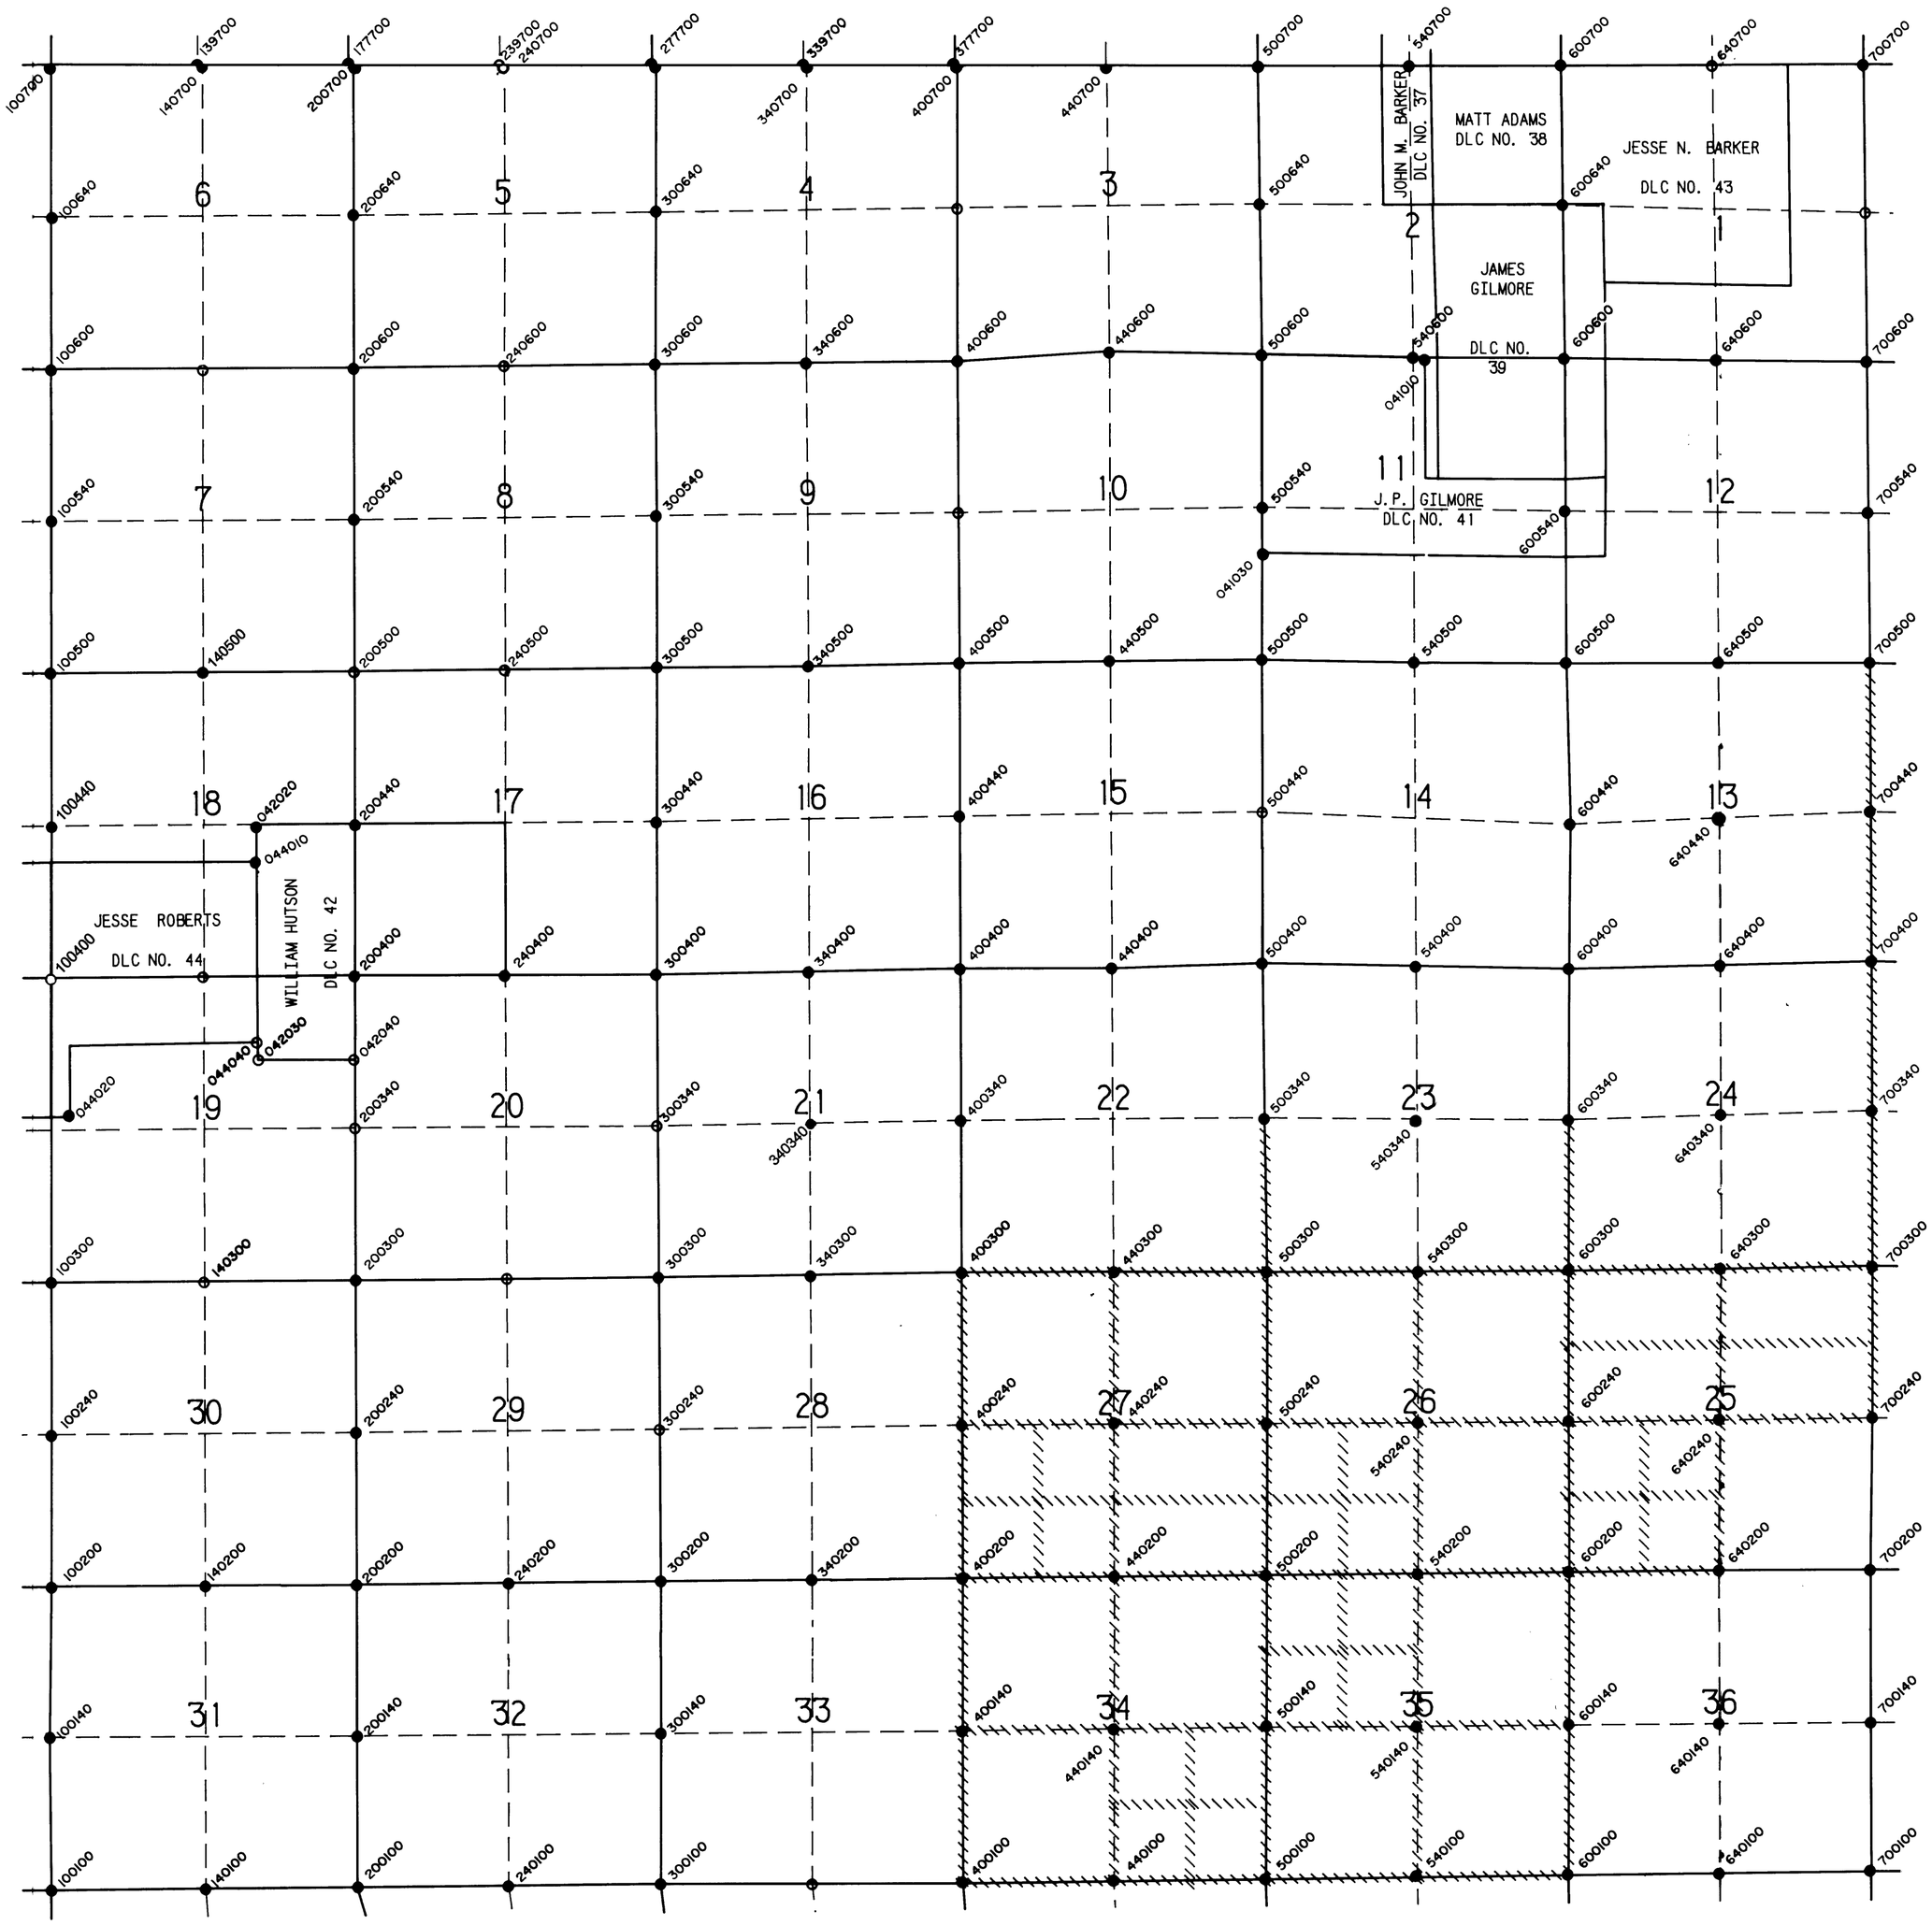
B.L.M. RESURVEYS - - - - - - - - - \\\\\\
CORNERS RENEWED OR ESTABLISHED - - - - - ●
CORNERS FOUND AND USED - - - - - - - - - ■
CORNERS LOOKED FOR AND NOT FOUND - - - - ○