TOWNSHIP 28 RANGE 06 POINT IDENTIFIER # 640200

PRIMARY CORNER DESCRIPTION 1/4 Cor. for Secs. 25 & 36

Alias _____ Description _____
Alias _____ Description _____
Alias _____ Description _____
Alias _____ Description _____

Original - Elder and Gile, under Contract #31 dated April 7, 1853 (DCSO records, Vol. 14 Page 5703)

Set ¼ sec. post, from which
A Y.Oak 14" dia., bears N.67°E., 13 lks.
A Laurel 18" dia., bears S.67°W., 25 lks.

Jesse W. cole, for Smick, Baer and Taylor - 1920 - Vol. 3 Page 83; Field Book 49 Page 40

Renewed corner from original BTs. Set a 4" x 4" x 36" Oak post and a mound of rock around stake.
Orig. BTs alive and standing, chopped open Oak, scribe marks visible.

Doug. County Surveyors Office - James Byron, Deputy - Dale McFarland; John Powell - Sept. 1961 - C.S. File 49/64-13

Found - Orig. 18" now 30" mostly burned Laurel, S.67°W., 16.5 ft. shows old scar on shell.
Old stump hole for NE BT location.
Bottom section of Cole's old corner stake at cor.
Set brass cap mkd: County Surveyor's Office, 1961 — S 25 / S 36
New BTs- 20" B.Oak bears S.24°E., 43.2 ft. scribed ¼ S36 CS BT.
14" Cedar bears N.31°E., 15.5 ft. scribed ¼ S 25 CS BT.
Call to bottom of draw checks - fence cor. thus: --x--x-

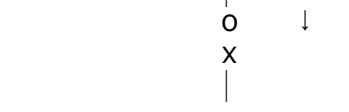

Fd. and used 14" Cedar tree, (monument is out of ground) Oct. 1999 by M. Heimburger - See CS file 65/25-10