T 30 S R 02 E

1" = 2000'
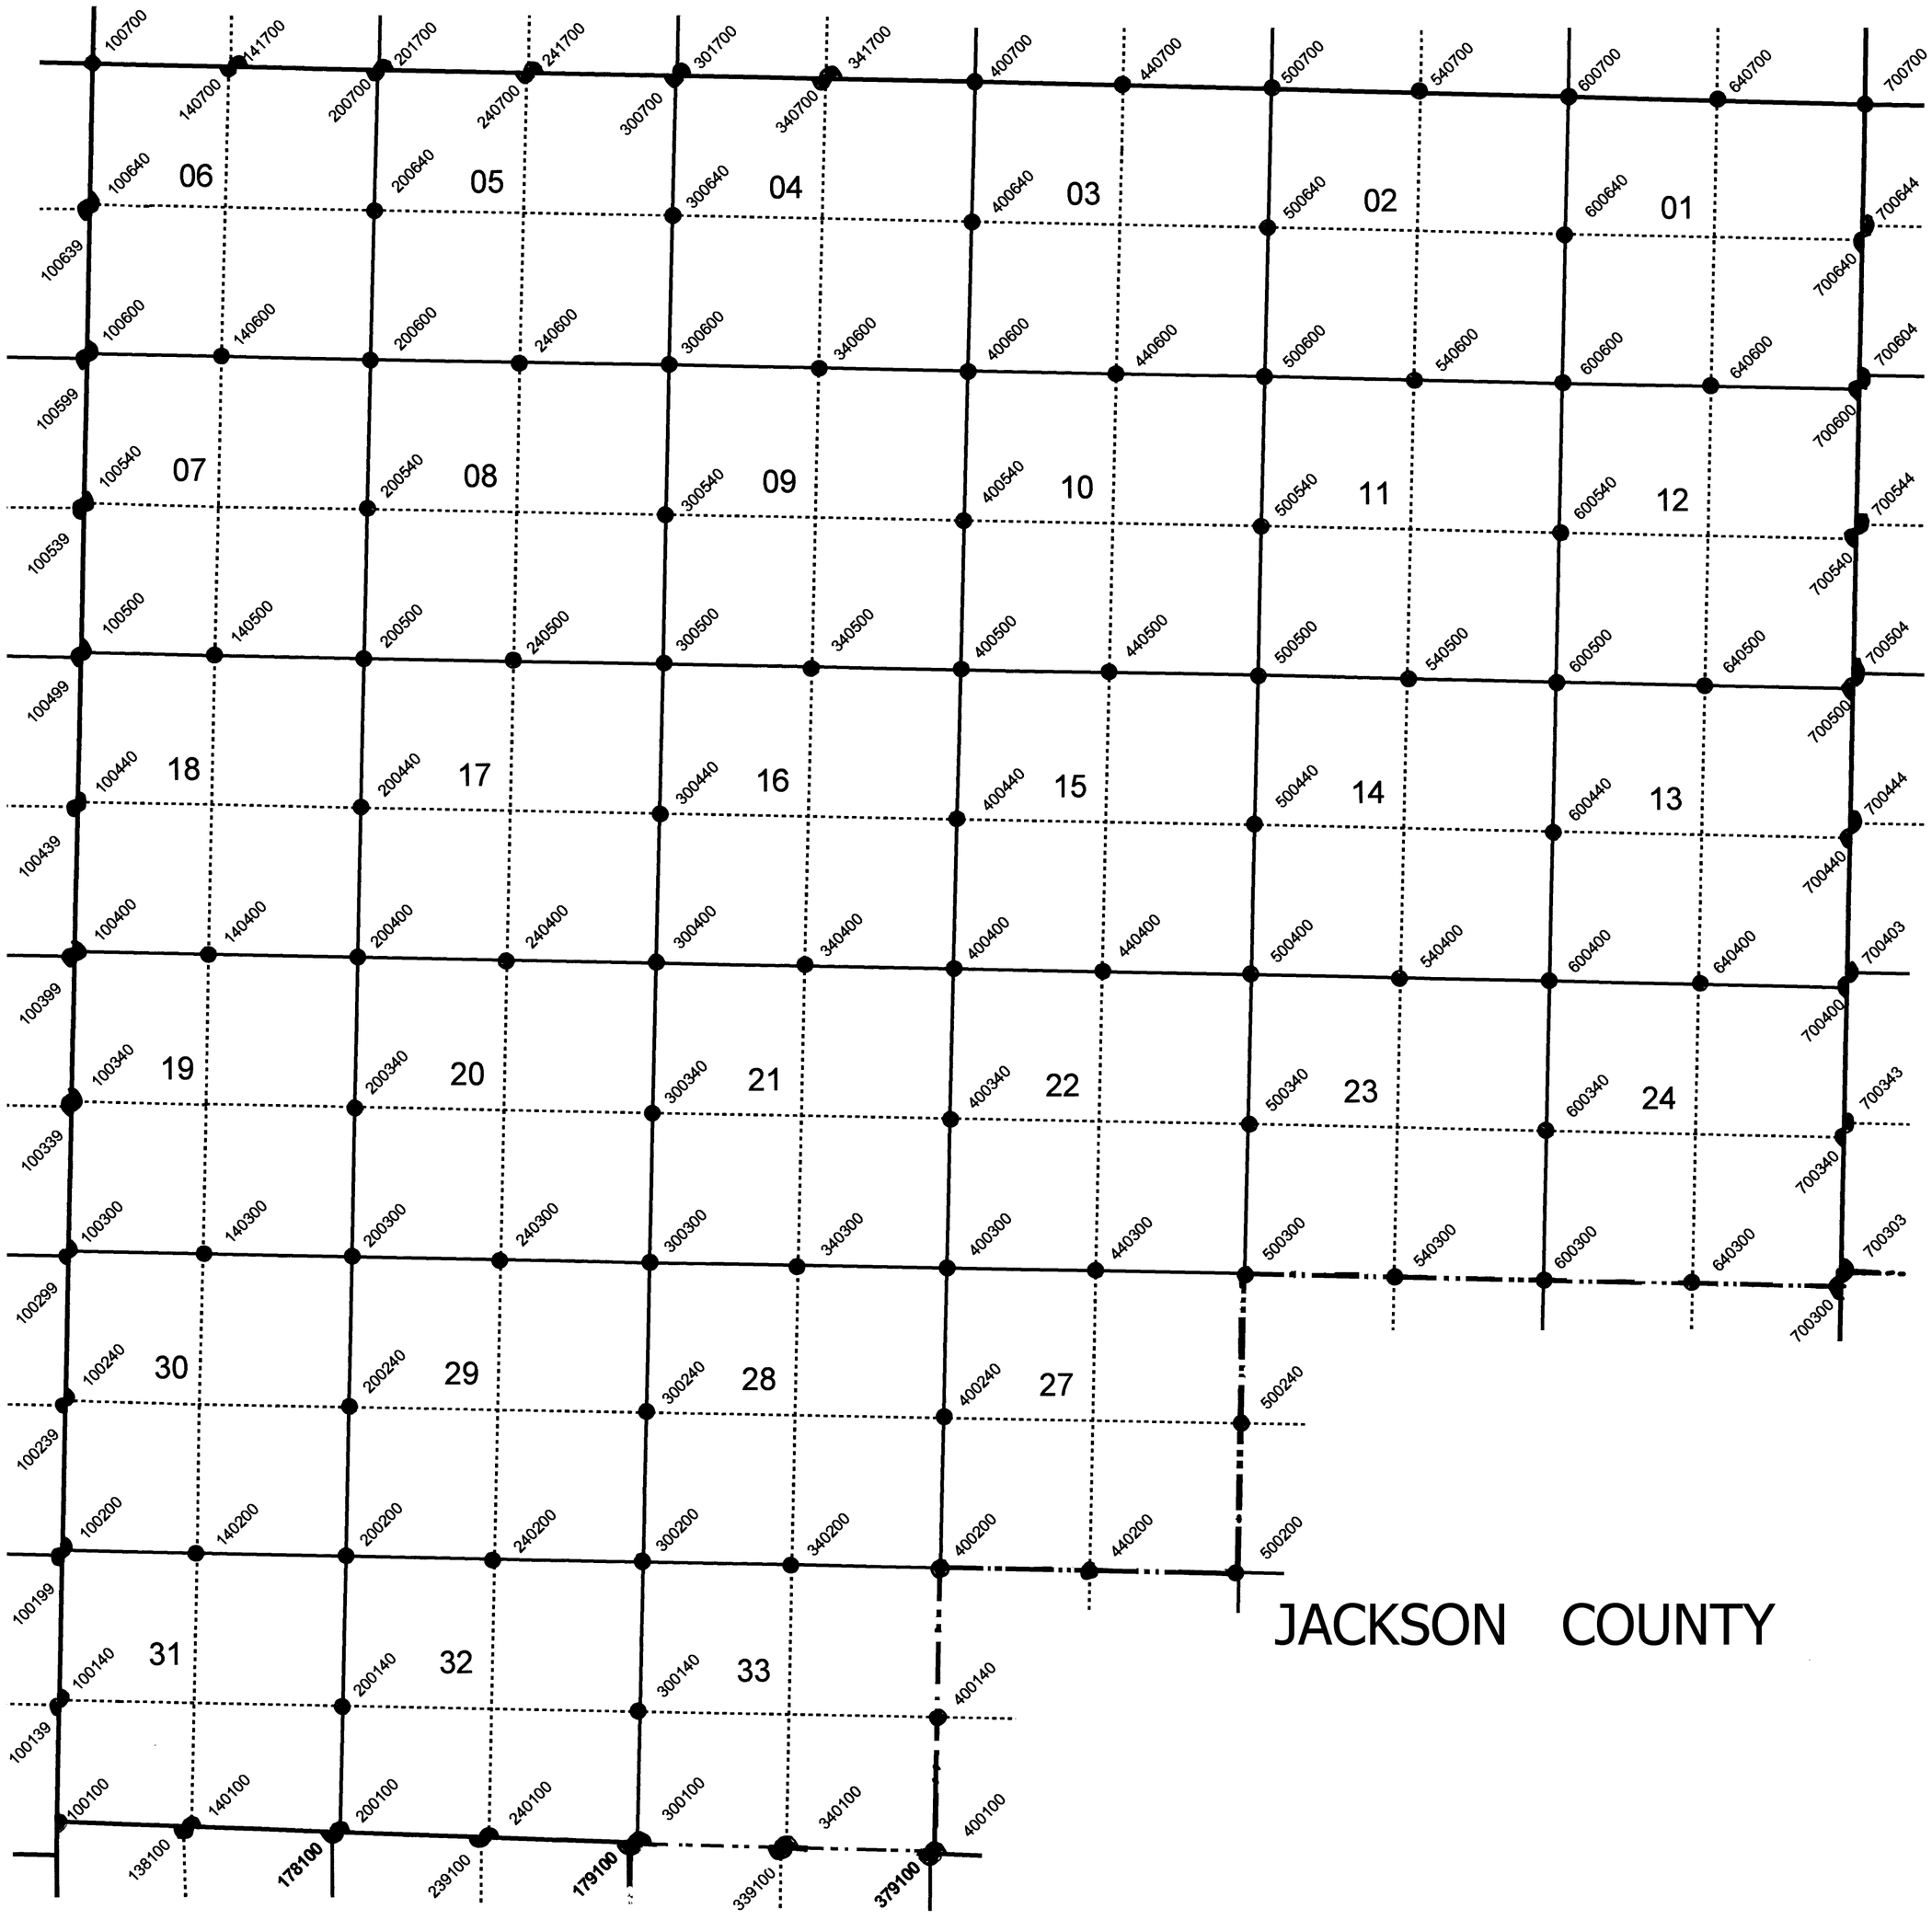
B.L.M. RESURVEYS ---------- \\\\\\ OR //////
CORNERS RENEWED OR ESTABLISHED -------- ●
CORNERS LOOKED FOR AND NOT FOUND ------- ○
CORNERS RENEWED - LAST REPORT NOT FD ---- *
COUNTY BOUNDARY ---------- — · — ·