T 31 S R 02 W

1" = 2000'

BLM RESURVEYS
CORNERS RENEWED OR ESTABLISHED
CORNERS FOUND AND USED
CORNERS LOOKED FOR AND NOT FOUND
COUNTY BOUNDARY
CORNER RENEWED - LAST REPORT NOT FD

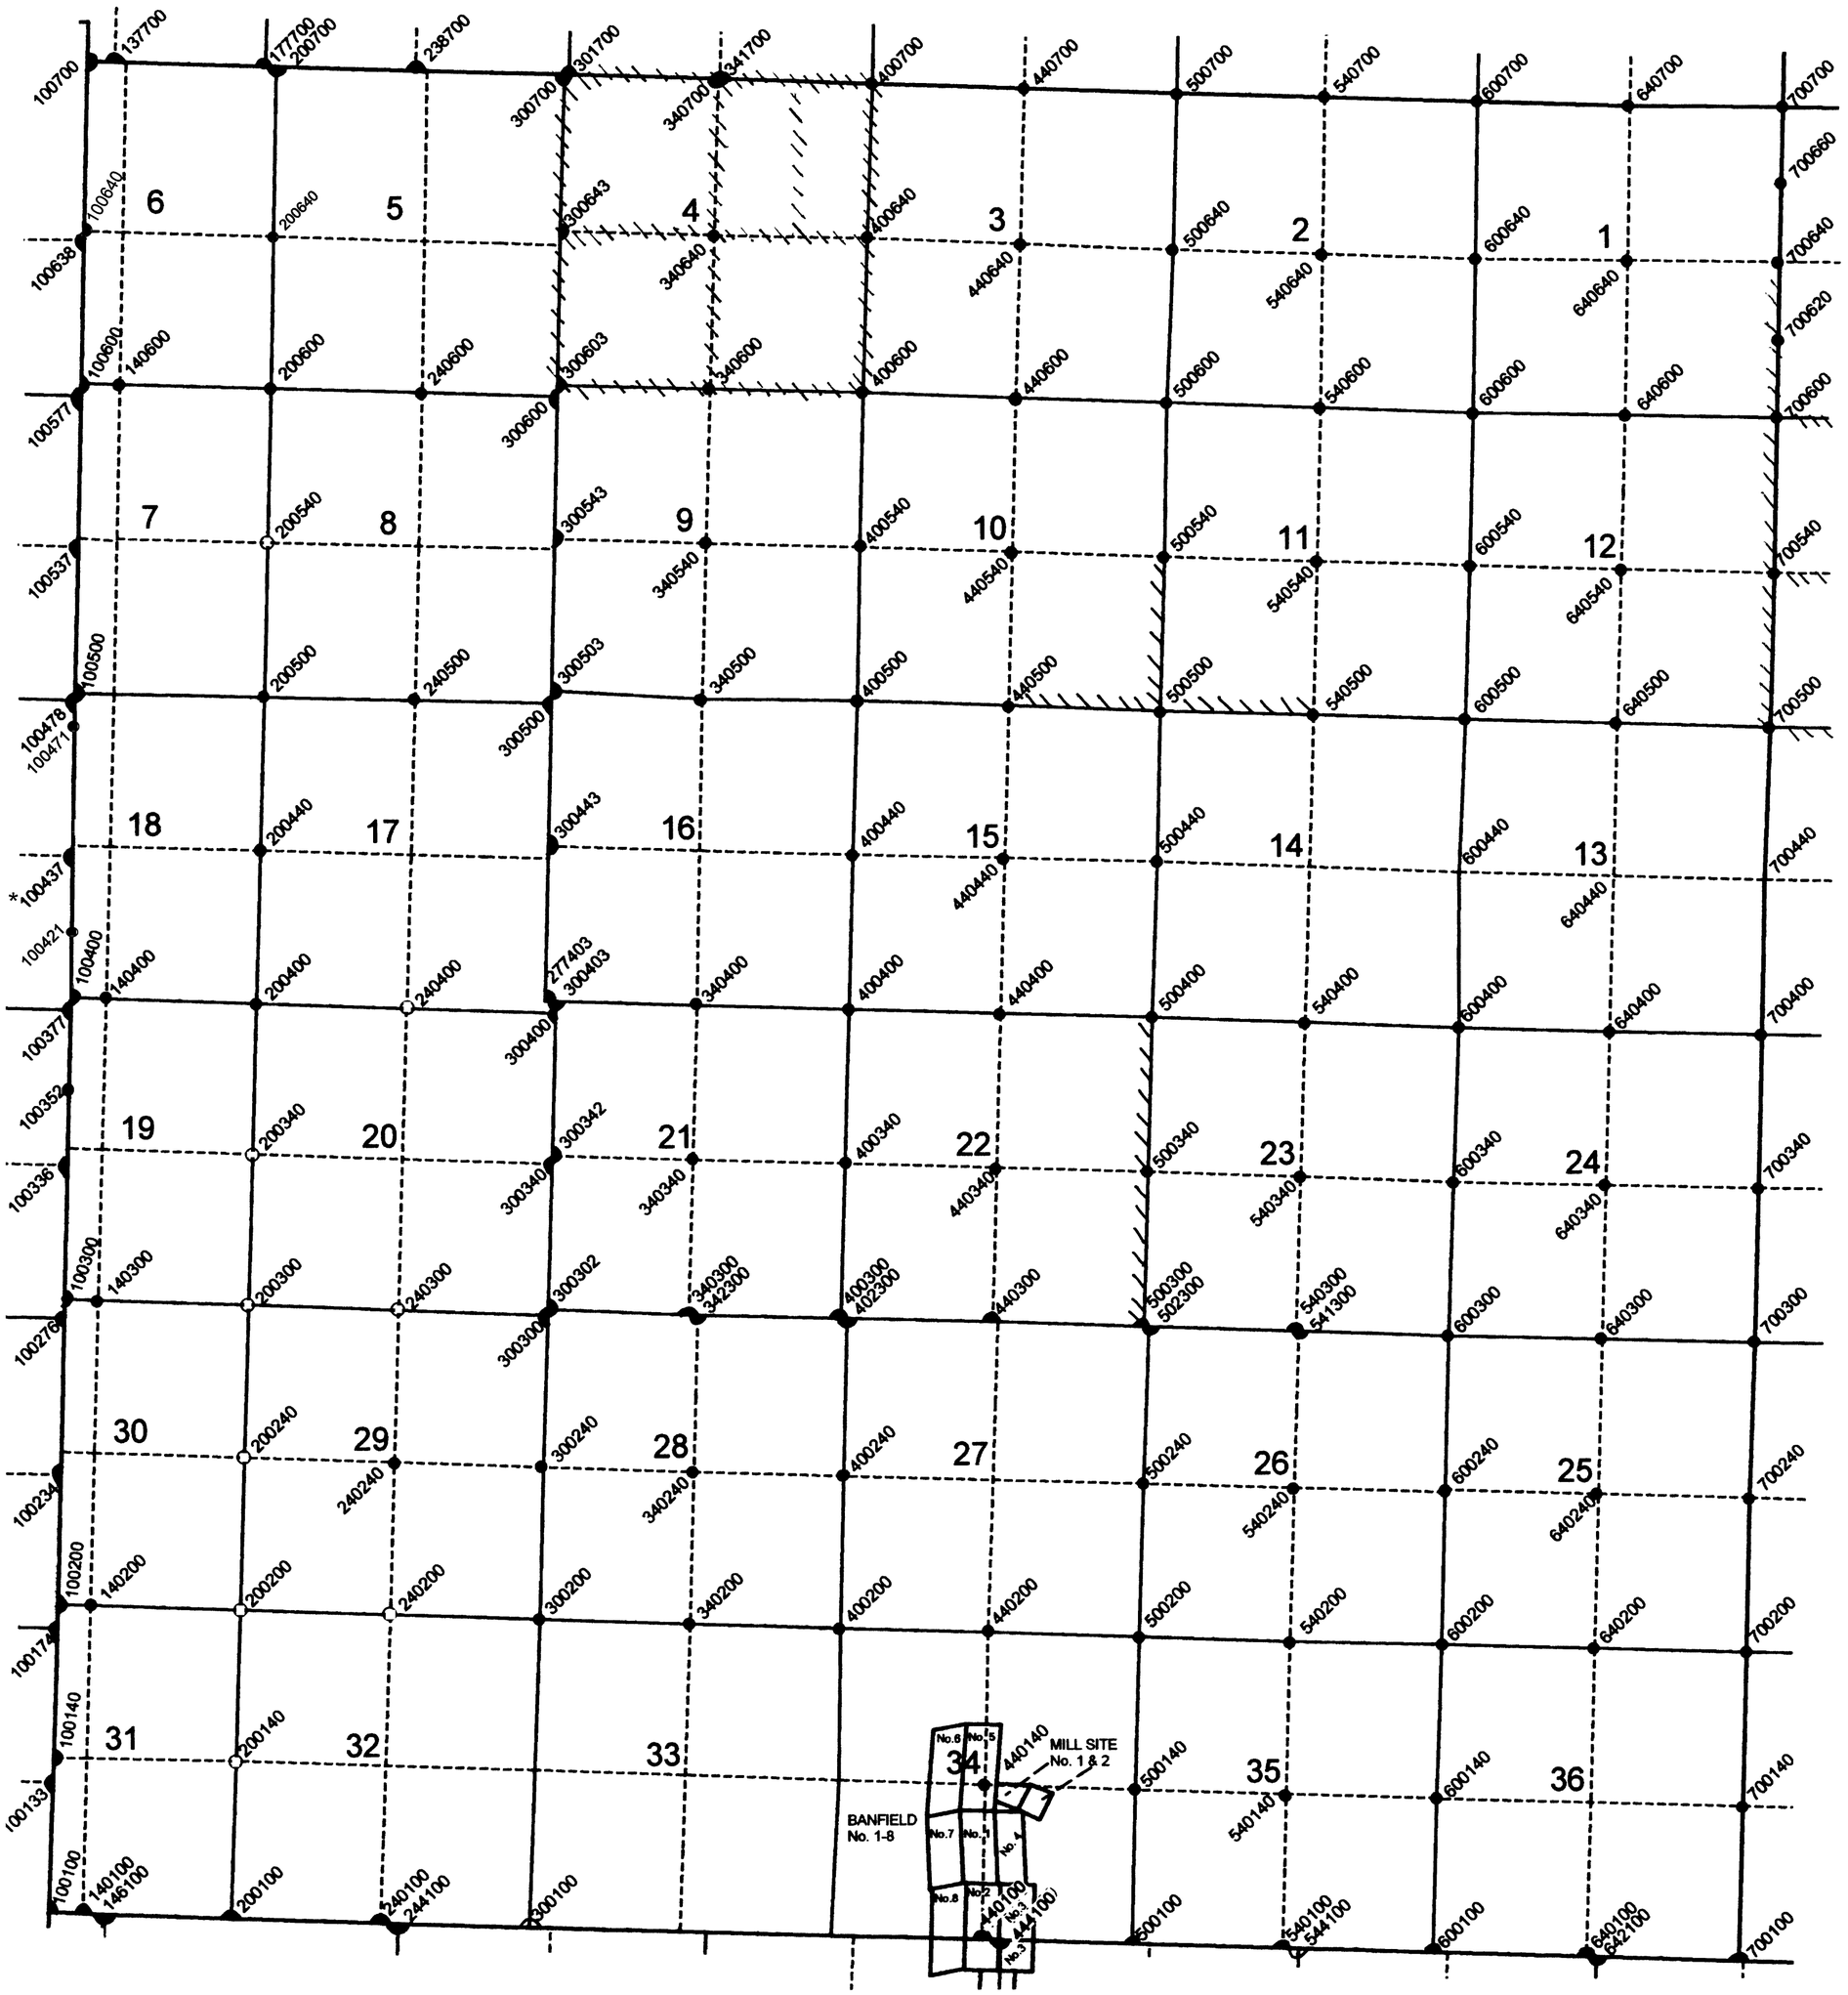

DETAIL
NO SCALE
BANFIELD

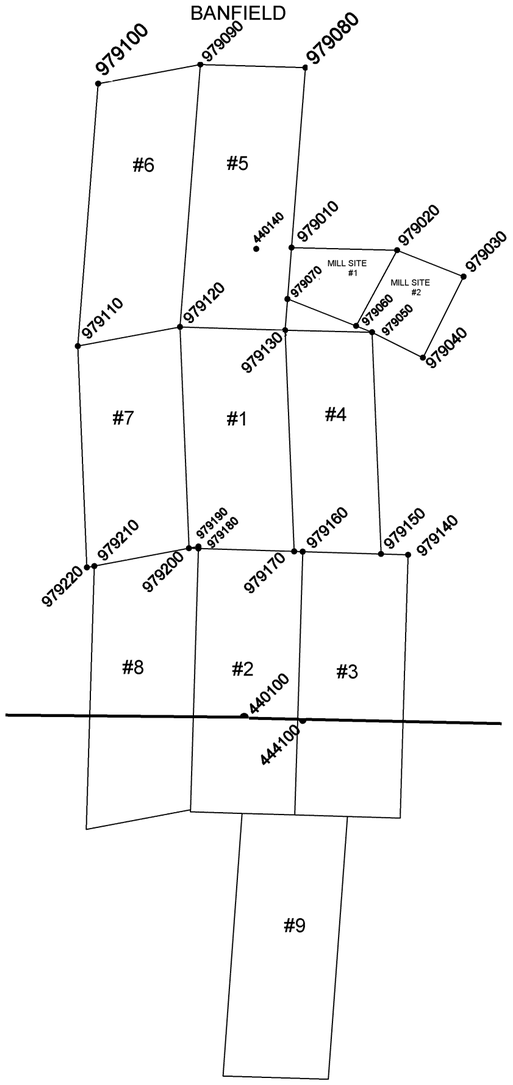

SEE DETAIL FOR MINERAL SURVEY CORNERS