T 33 S R 7 W

1" = 2000'
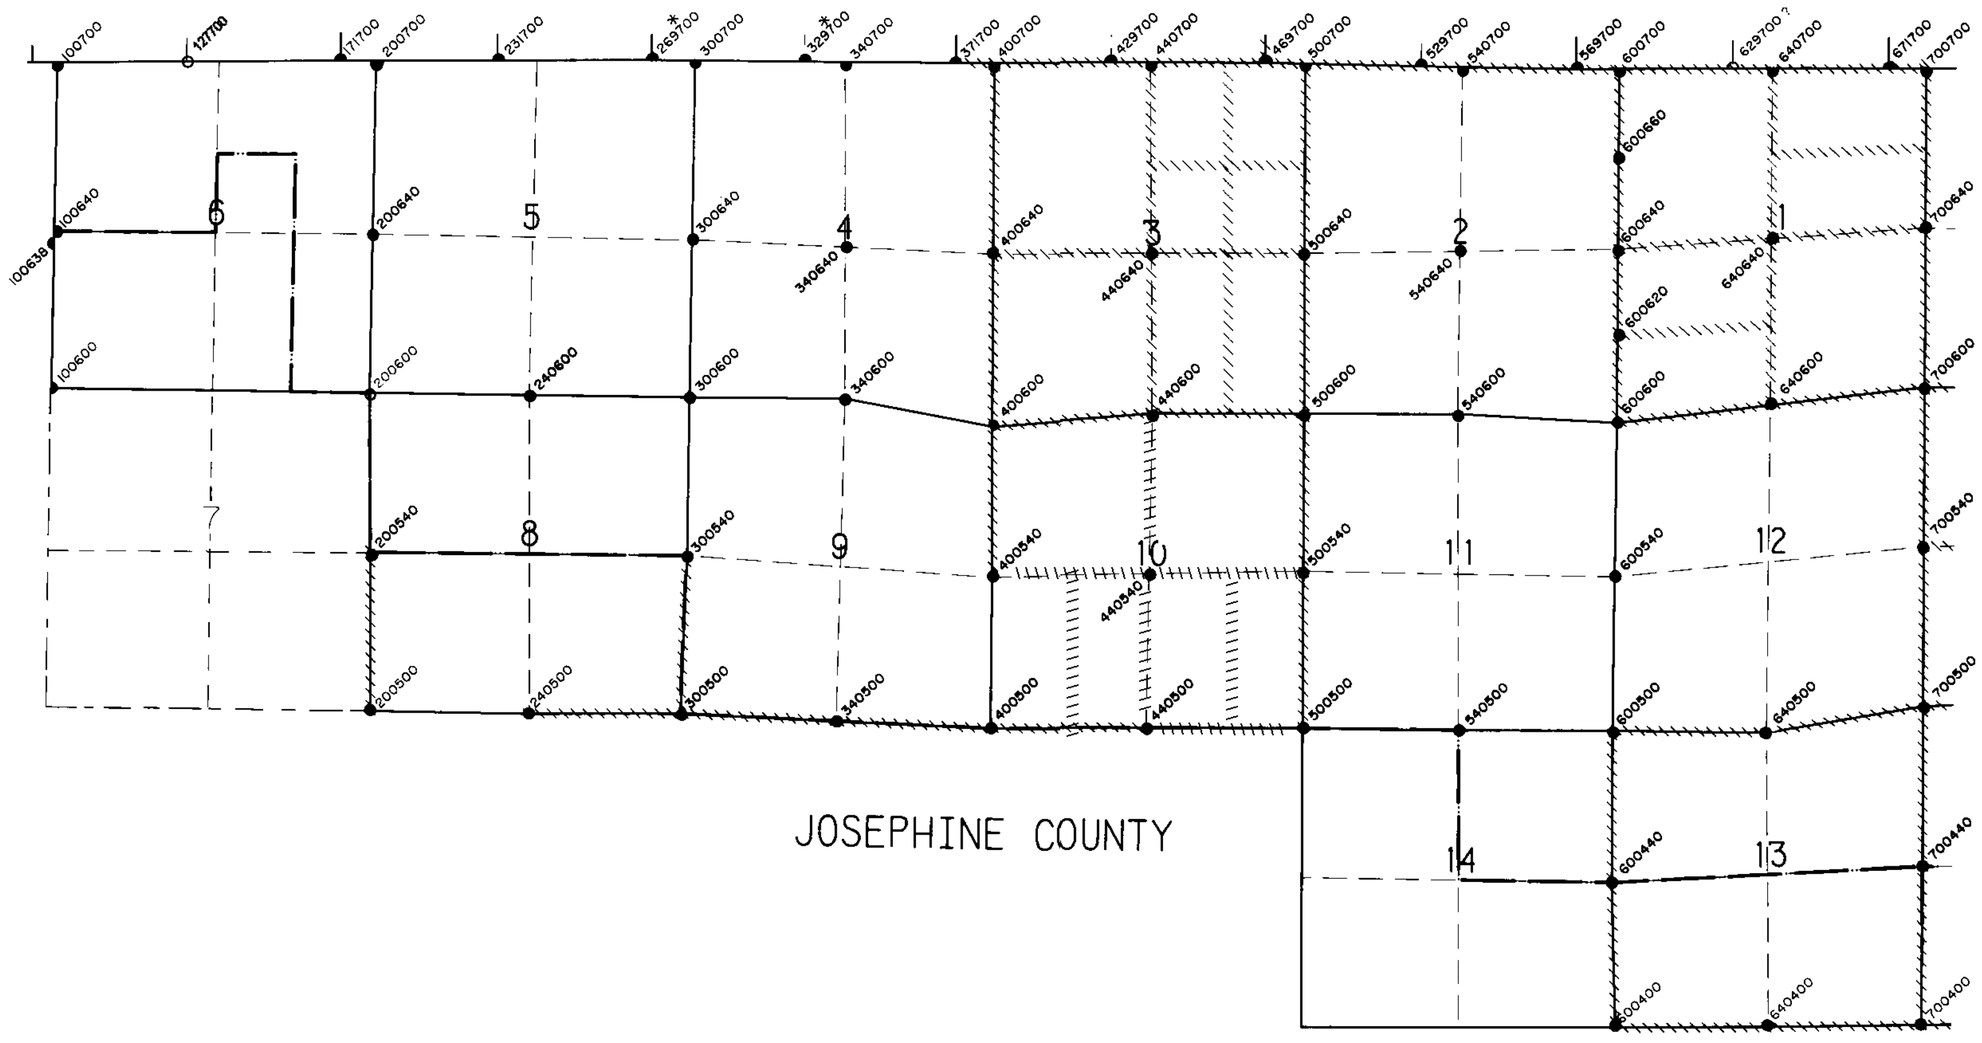
B. L. M. RESURVEYS
CORNERS RENEWED OR ESTABLISHED
CORNERS FOUND AND USED
CORNERS LOOKED FOR AND NOT FOUND
COUNTY BOUNDARY
CORNER RENEWED - LAST REPORT NOT FD - - *